
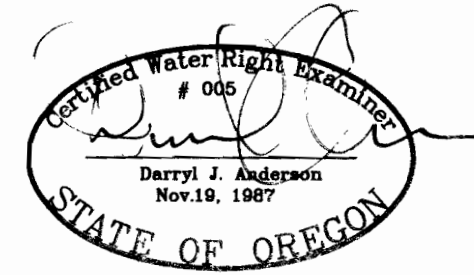
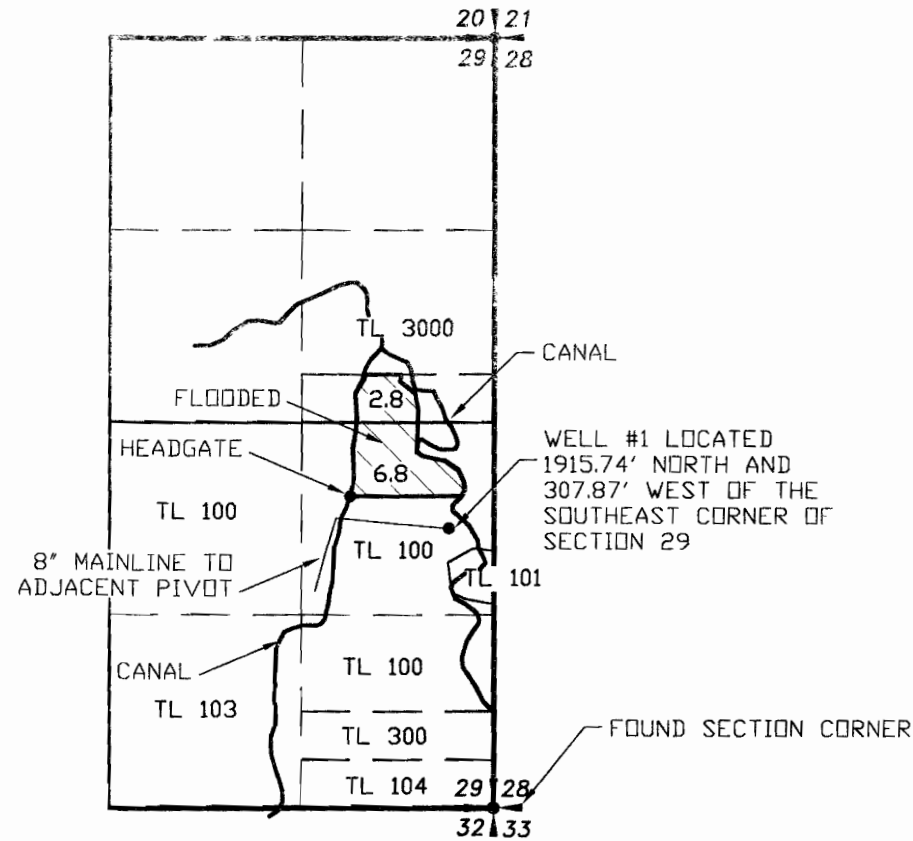


CLAIM OF BENEFICIAL USE MAP FOR LAKEVIEW WATER USERS INC.

SECTION 29, TOWNSHIP 39 SOUTH RANGE 19 EAST, W.M.
SECTION 19, TOWNSHIP 40 SOUTH RANGE 19 EAST, W.M.
LAKE COUNTY, OREGON

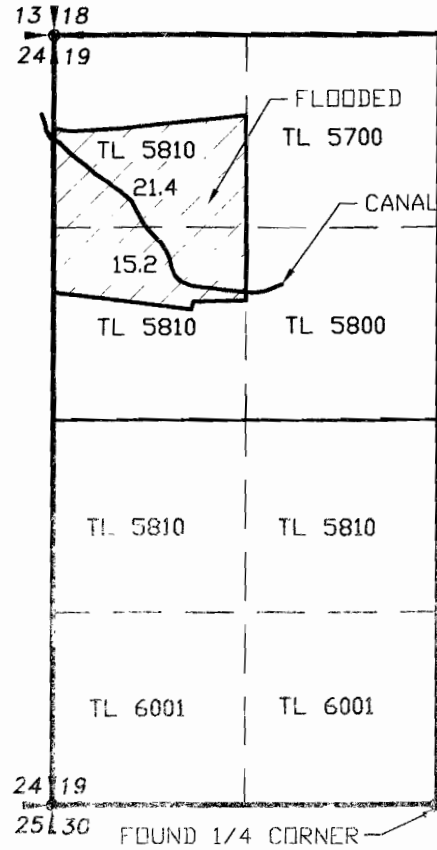


RENEWAL 12/31/07

LEGEND

- SECTION LINE
- 1/4 SECTION LINE
- 1/16 SECTION LINE
- MAINLINE

- PRIMARY IRRIGATION FROM CERTIFICATE 76187
SUPPLEMENTAL IRRIGATION FROM PERMIT S-43956
- PRIMARY IRRIGATION FROM CERTIFICATE 76187
SUPPLEMENTAL IRRIGATION FROM PERMIT S-43956
SUPPLEMENTAL IRRIGATION FROM PERMIT G-13070

TRANSFER NO. T-9658

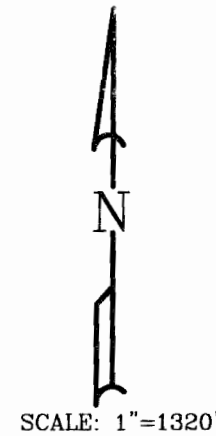

NOTE:
PREPARATION OF THIS MAP IS FOR IDENTIFYING PROPOSED
WATER RIGHTS ONLY. IT HAS NO INTENT TO PROVIDE
LOCATIONS OR DIMENSIONS OF PROPERTY BOUNDARIES.

COBU MAP # 0288

REVISION	BY

**ANDERSON ENGINEERING
AND SURVEYING, INC.**
P.O. BOX 28,
LAKEVIEW, OREGON
97630 (541)
947-4407 FAX
947-2321




FOR:
SHARI PICKARD
3000 ASSOCIATED RD #56
FULLERTON, CA 92835
(805) 466-7808

CLAIM OF BENEFICIAL USE
T-9658

DATE:	08/10/07
SCALE:	1"=1320'
DWG. BY:	R.C.
JOB:	2004-196
FILE:	2004-196
SHEET:	1 OF 1

CLAIM OF BENEFICIAL USE MAP FOR LAKEVIEW WATER USERS INC.

SECTION 29, TOWNSHIP 39 SOUTH RANGE 19 EAST, W.M.
SECTION 19, TOWNSHIP 40 SOUTH RANGE 19 EAST, W.M.
LAKE COUNTY, OREGON

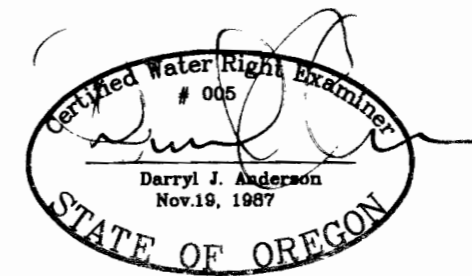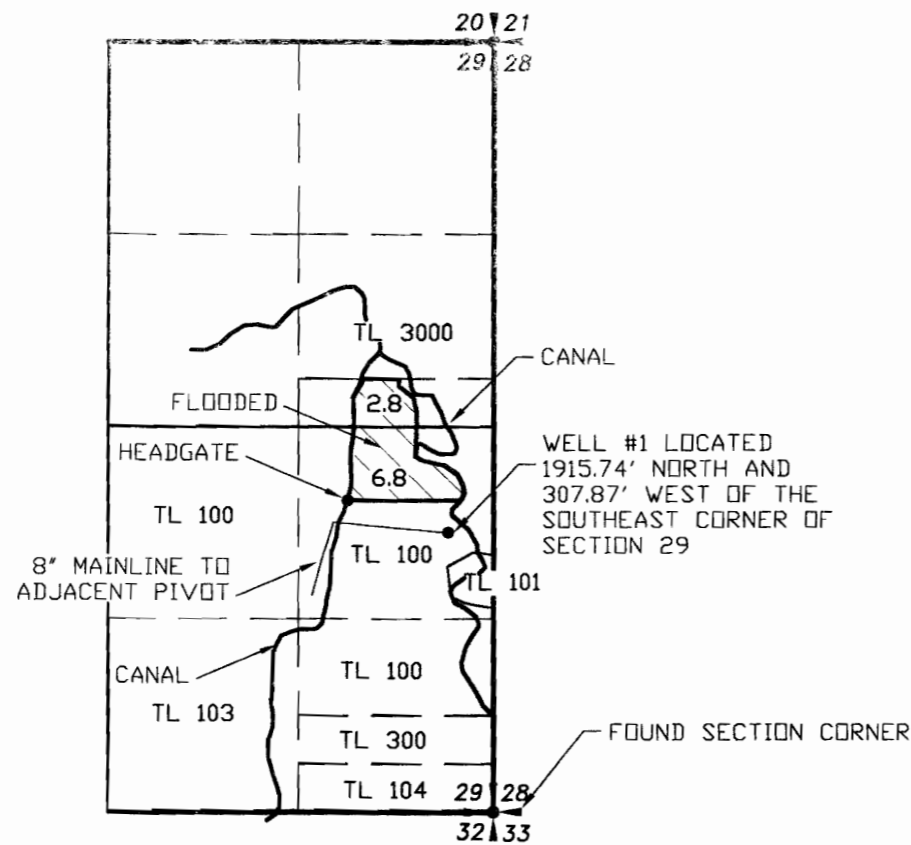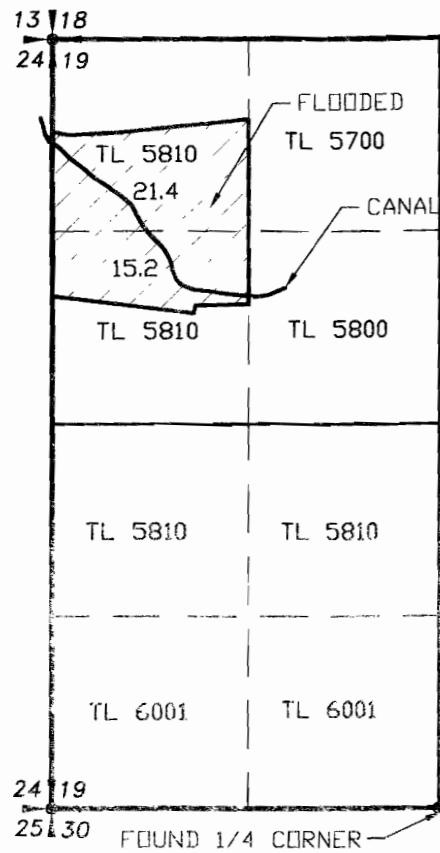


RENEWAL 12/31/07

LEGEND

- SECTION LINE
- 1/4 SECTION LINE
- 1/16 SECTION LINE
- MAINLINE
- PRIMARY IRRIGATION FROM CERTIFICATE 76187
SUPPLEMENTAL IRRIGATION FROM PERMIT S-43956
- PRIMARY IRRIGATION FROM CERTIFICATE 76187
SUPPLEMENTAL IRRIGATION FROM PERMIT S-43956
SUPPLEMENTAL IRRIGATION FROM PERMIT G-13070

TRANSFER NO. T-9658

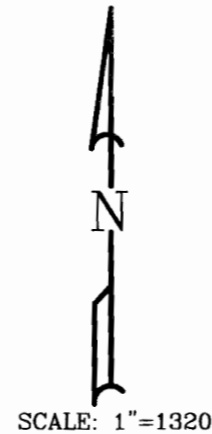

NOTE:
PREPARATION OF THIS MAP IS FOR IDENTIFYING PROPOSED
WATER RIGHTS ONLY. IT HAS NO INTENT TO PROVIDE
LOCATIONS OR DIMENSIONS OF PROPERTY BOUNDARIES.

COBU MAP # 0288

REVISION	BY

**ANDERSON ENGINEERING
AND SURVEYING, INC.**
P.O. BOX 28
LAKEVIEW, OREGON
97630 (541)
947-4407 FAX
947-2321

FOR:
SHARI PICKARD
5000 ASSOCIATED RD #59
FULLERTON, CA 92836
(805) 466-7808




CLAIM OF BENEFICIAL USE
T-9658

DATE:	08/10/07
SCALE:	1"=1320'
DWG. BY:	R.C.
JOB:	2004-196
FILE:	2004-196
SHEET:	1 OF 1

SEP 21 2007

CLAIM OF BENEFICIAL USE MAP FOR LAKEVIEW WATER USERS INC.

SECTION 29, TOWNSHIP 39 SOUTH RANGE 19 EAST, W.M.
SECTION 19, TOWNSHIP 40 SOUTH RANGE 19 EAST, W.M.
LAKE COUNTY, OREGON

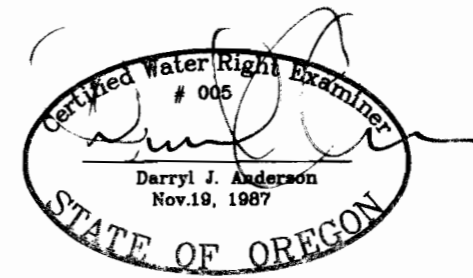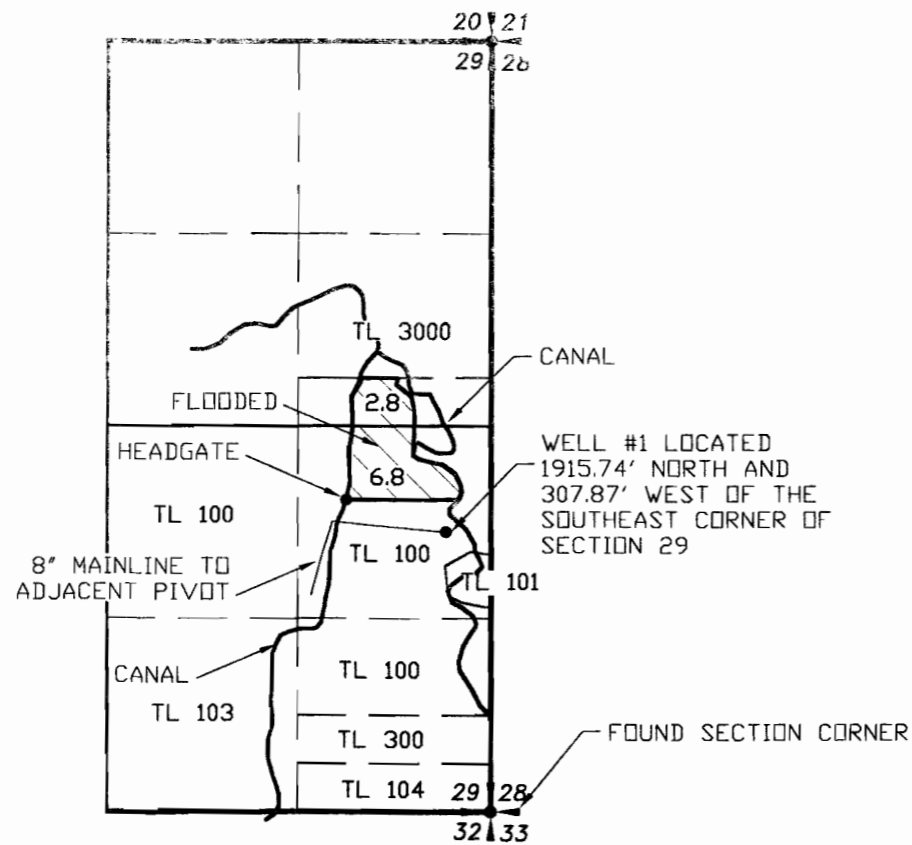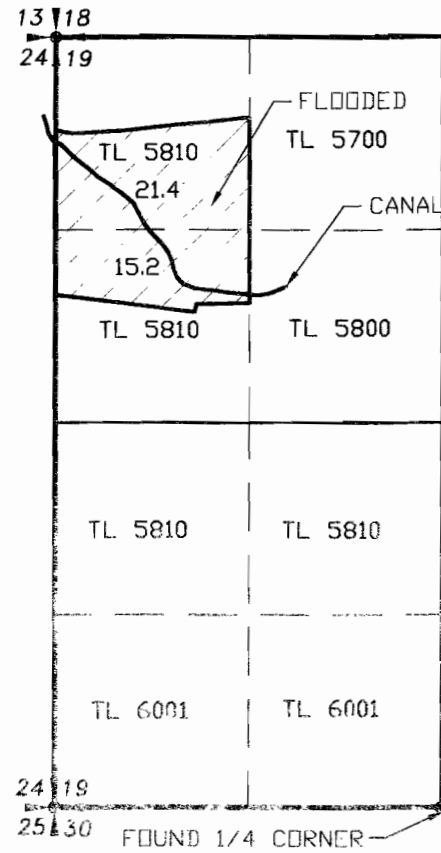


RENEWAL 12/31/07

LEGEND

- SECTION LINE
- 1/4 SECTION LINE
- 1/16 SECTION LINE
- MAINLINE

- PRIMARY IRRIGATION FROM CERTIFICATE 76187
SUPPLEMENTAL IRRIGATION FROM PERMIT S-43956
- PRIMARY IRRIGATION FROM CERTIFICATE 76187
SUPPLEMENTAL IRRIGATION FROM PERMIT S-43956
SUPPLEMENTAL IRRIGATION FROM PERMIT G-13070

TRANSFER NO. T-9658

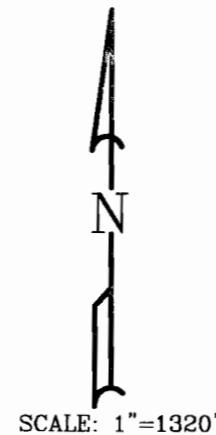

NOTE:
PREPARATION OF THIS MAP IS FOR IDENTIFYING PROPOSED
WATER RIGHTS ONLY. IT HAS NO INTENT TO PROVIDE
LOCATIONS OR DIMENSIONS OF PROPERTY BOUNDARIES.

REVISION	BY

**ANDERSON ENGINEERING
AND SURVEYING, INC.**
P.O. BOX 28
LAKEVIEW, OREGON
97630 (541)
947-4407 FAX
947-2321

FOR:
SHARI PICKARD
3000 ASSOCIATED RD #59
FULLERTON, CA 92835
(805) 486-7908

**CLAIM OF BENEFICIAL USE
T-9658**


DATE:	08/10/07
SCALE:	1"=1320'
DWG. BY:	R.C.
JOB:	2004-196
FILE:	2004-196
SHEET:	1 OF 1

COBU MAP # 0288

SEP 21 2007

CLAIM OF BENEFICIAL USE MAP FOR LAKEVIEW WATER USERS INC.

SECTION 29, TOWNSHIP 39 SOUTH RANGE 19 EAST, W.M.
SECTION 19, TOWNSHIP 40 SOUTH RANGE 19 EAST, W.M.
LAKE COUNTY, OREGON


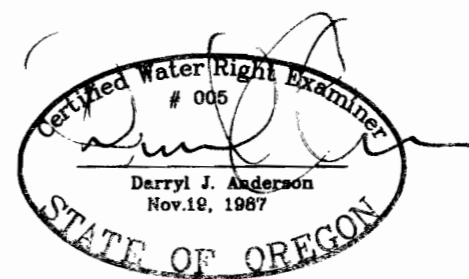


RENEWAL 12/31/07

LEGEND

- SECTION LINE
- 1/4 SECTION LINE
- 1/16 SECTION LINE
- MAINLINE
- PRIMARY IRRIGATION FROM CERTIFICATE 76187
SUPPLEMENTAL IRRIGATION FROM PERMIT S-43956
- PRIMARY IRRIGATION FROM CERTIFICATE 76187
SUPPLEMENTAL IRRIGATION FROM PERMIT G-13070

TRANSFER NO. T-9658

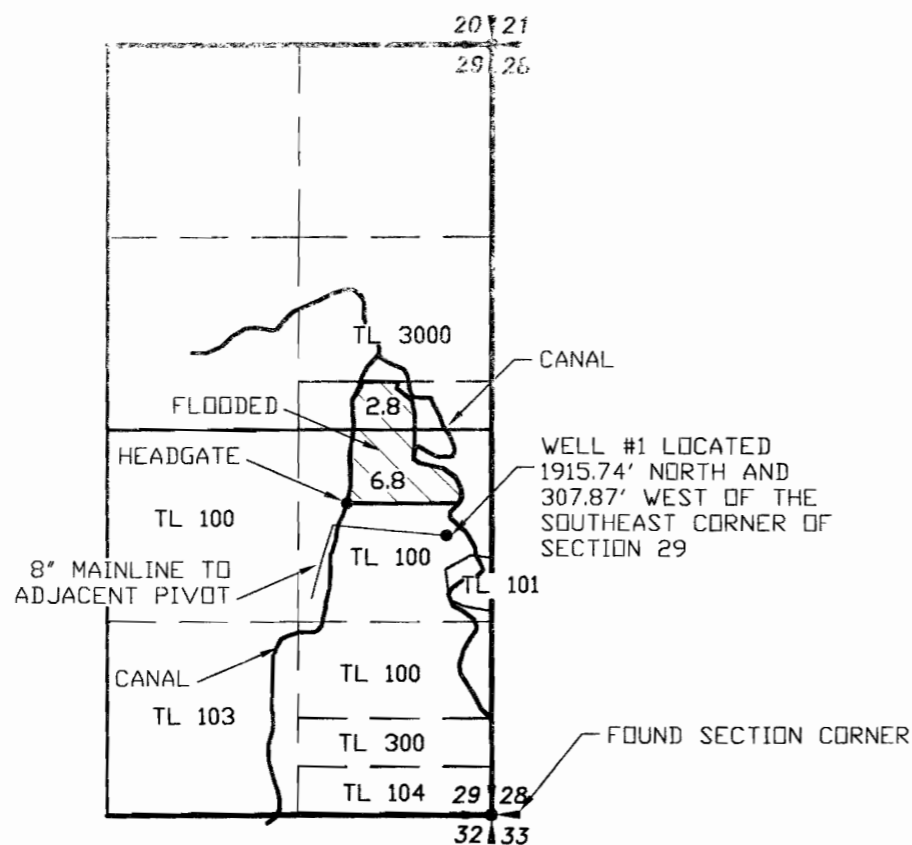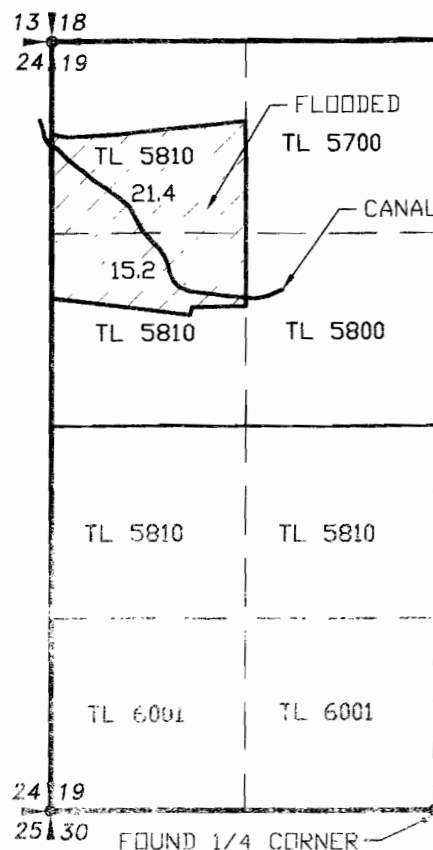

COBU MAP # 0288

NOTE:
PREPARATION OF THIS MAP IS FOR IDENTIFYING PROPOSED
WATER RIGHTS ONLY. IT HAS NO INTENT TO PROVIDE
LOCATIONS OR DIMENSIONS OF PROPERTY BOUNDARIES.

REVISION	BY

**ANDERSON ENGINEERING
AND SURVEYING, INC.**
P.O. BOX 28
LAKEVIEW, OREGON
97630 (541)
947-4407 FAX
947-2321

FOR:
SHARI PICKARD
3000 ASSOCIATED RD #59
FULLERTON, CA 92635
(805) 466-7808

CLAIM OF BENEFICIAL USE
T-9658

DATE:	08/10/07
SCALE:	1"=1320'
DWG. BY:	R.C.
JOB:	2004-196
FILE:	2004-196
SHEET:	1 OF 1