


TOWNSHIPS 5&6 NORTH, RANGE 35 EAST, W.M.

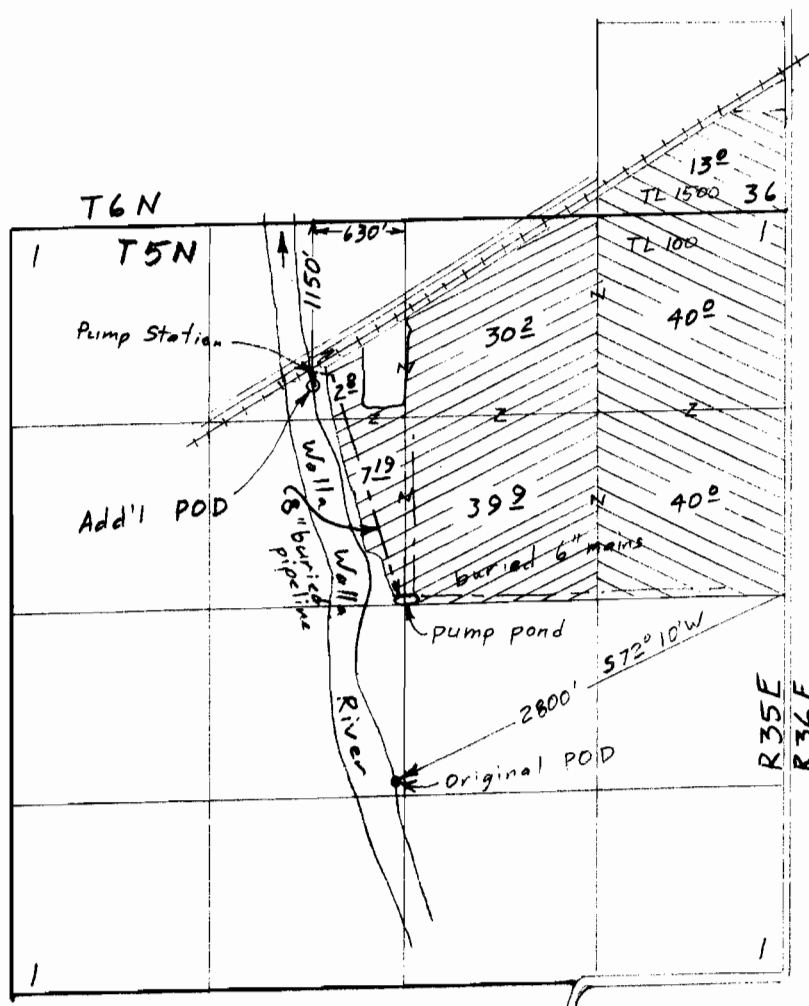


Scale 1" = 1320'

Surveyed August 30, 2003

- ⊙ 1897 (80²/₂ acres)
- ⊙ July 12, 1912 (93²/₂ acres)

Claim of Beneficial Use Map
for
J. Frank Schmidt & Son Co.

T-9121

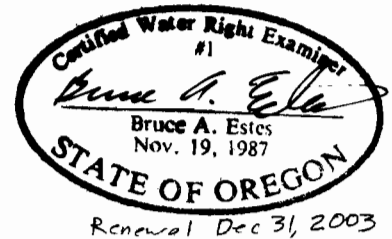

This map is for the purpose of locating a water right only and has no intent to provide legal dimensions or the location of property lines.

ESTES SURVEYS, LLC

PO Box 17519 60382 Arnold Rd
Salem, OR 97305-7519 Bend, OR 97702
(503) 585-7593 (541) 382-7391