


T-1641

RECORDED  
INDEXED  
STATE ENGINEER  
BALENT, OREGON

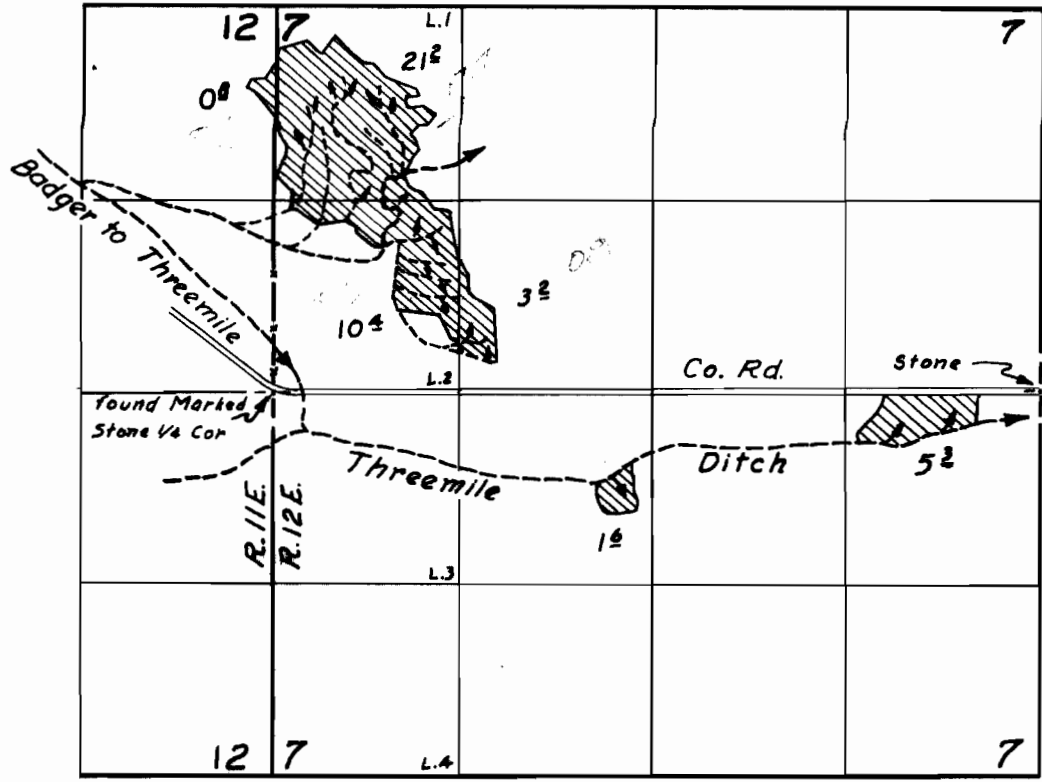

**FINAL PROOF SURVEY**  
UNDER

Transfer No. P-59  
IN NAME OF

*William & Arthur Peetz*

Surveyed *April 12 1962*, by *L. W. Dehausek*