


T. 4S., R. 12 & 13E., W. M.

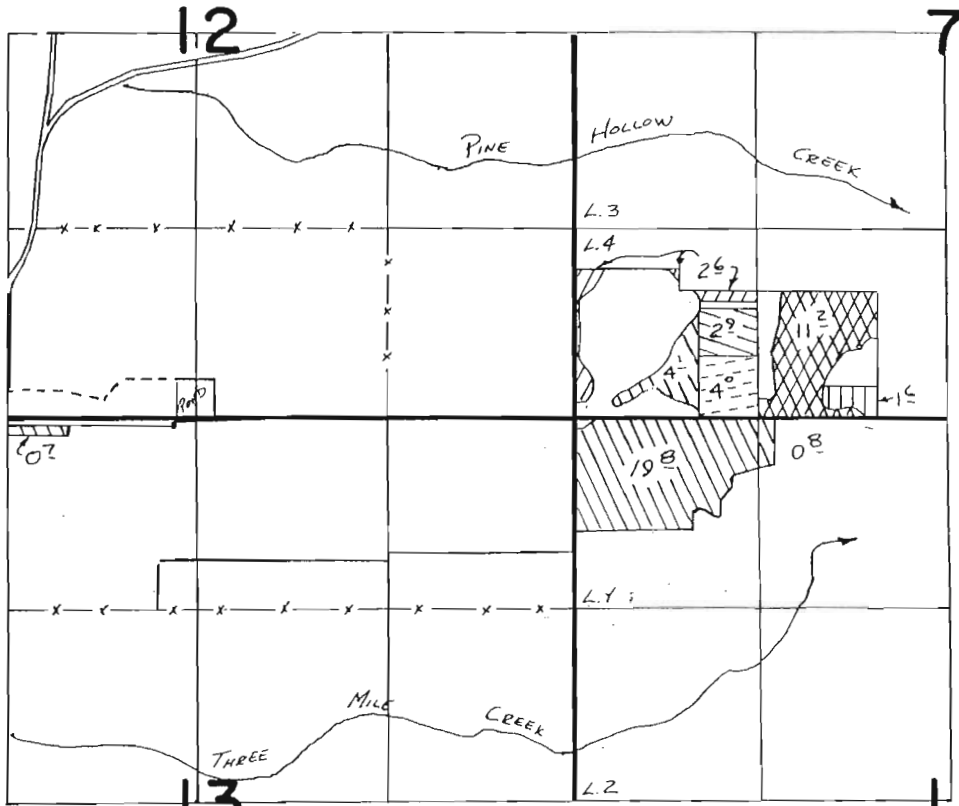

SCALE 1" = 1320'


-  T-4324
-  T-4313
-  T-4312
-  Prim.  
T-4314  
Suppl.
-  T-5553

**FINAL PROOF SURVEY**  
UNDER

**TRANSFERS 4324, 4313, 4312, 4314, 5553**  
IN NAME OF

**RAY A. BENZEL**

Surveyed 10-18 1988, by V.L. Church

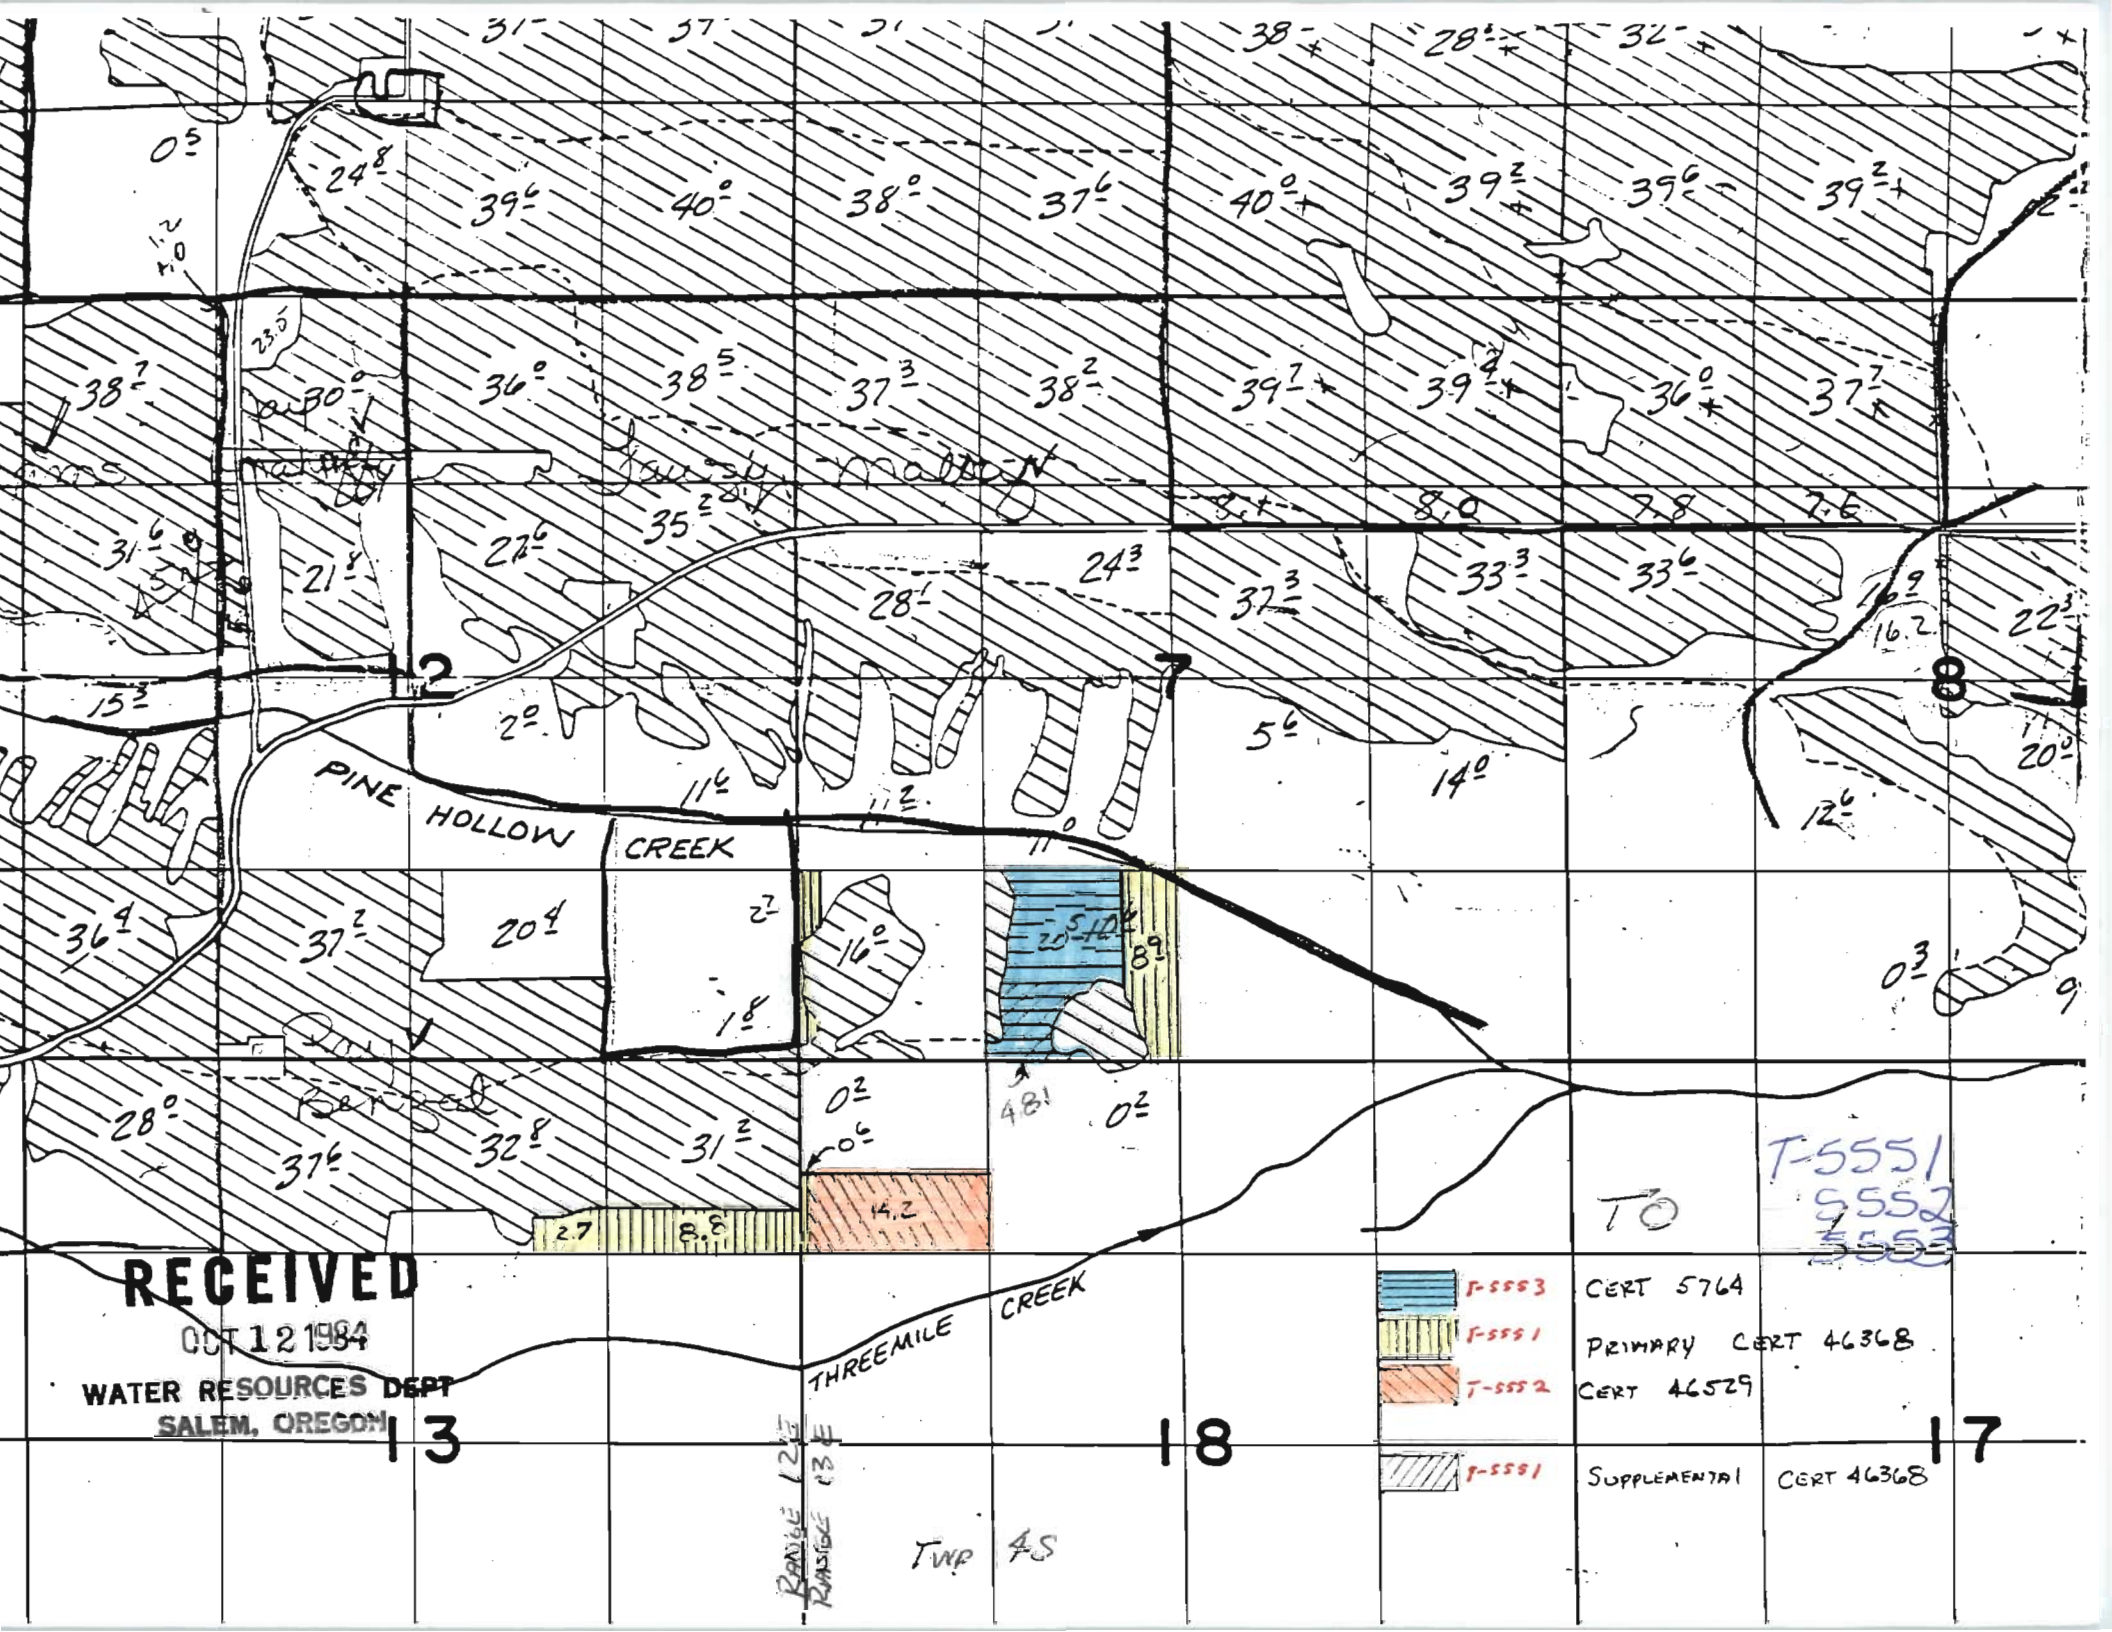

**RECEIVED**

OCT 12 1984

WATER RESOURCES DEPT  
SALEM, OREGON

13

RANGE 12 E  
RANGE 13 E

TWP 4S

18

-  T-5553
-  T-5551
-  T-5552
-  T-5551

CERT 5764  
PRIMARY CERT 46368  
CERT 46529  
SUPPLEMENTAL CERT 46368

TO

T-5551  
5552  
5553

17



RECEIVED

OCT 12 1984

WATER RESOURCES  
SALEM, OREGON

T-5551

T.A.S. R. 12E Sec 9

January 7, 1874	Threemile Creek	Primary	20.5	5764
March 22, 1961	Badger Creek & Misc	Primary	23.7	46368
		Supplemental	4.81	46368
October 27, 1964	Threemile Creek & Misc.	Primary	14.2	46529
July 23, 1968	Threemile Creek & Misc.	Supplemental	58.4	51486
May 1, 1975	Threemile Creek & Misc.	Supplemental	58.4	51486

TAS RIZE SEC 9

