


R15E | R16E

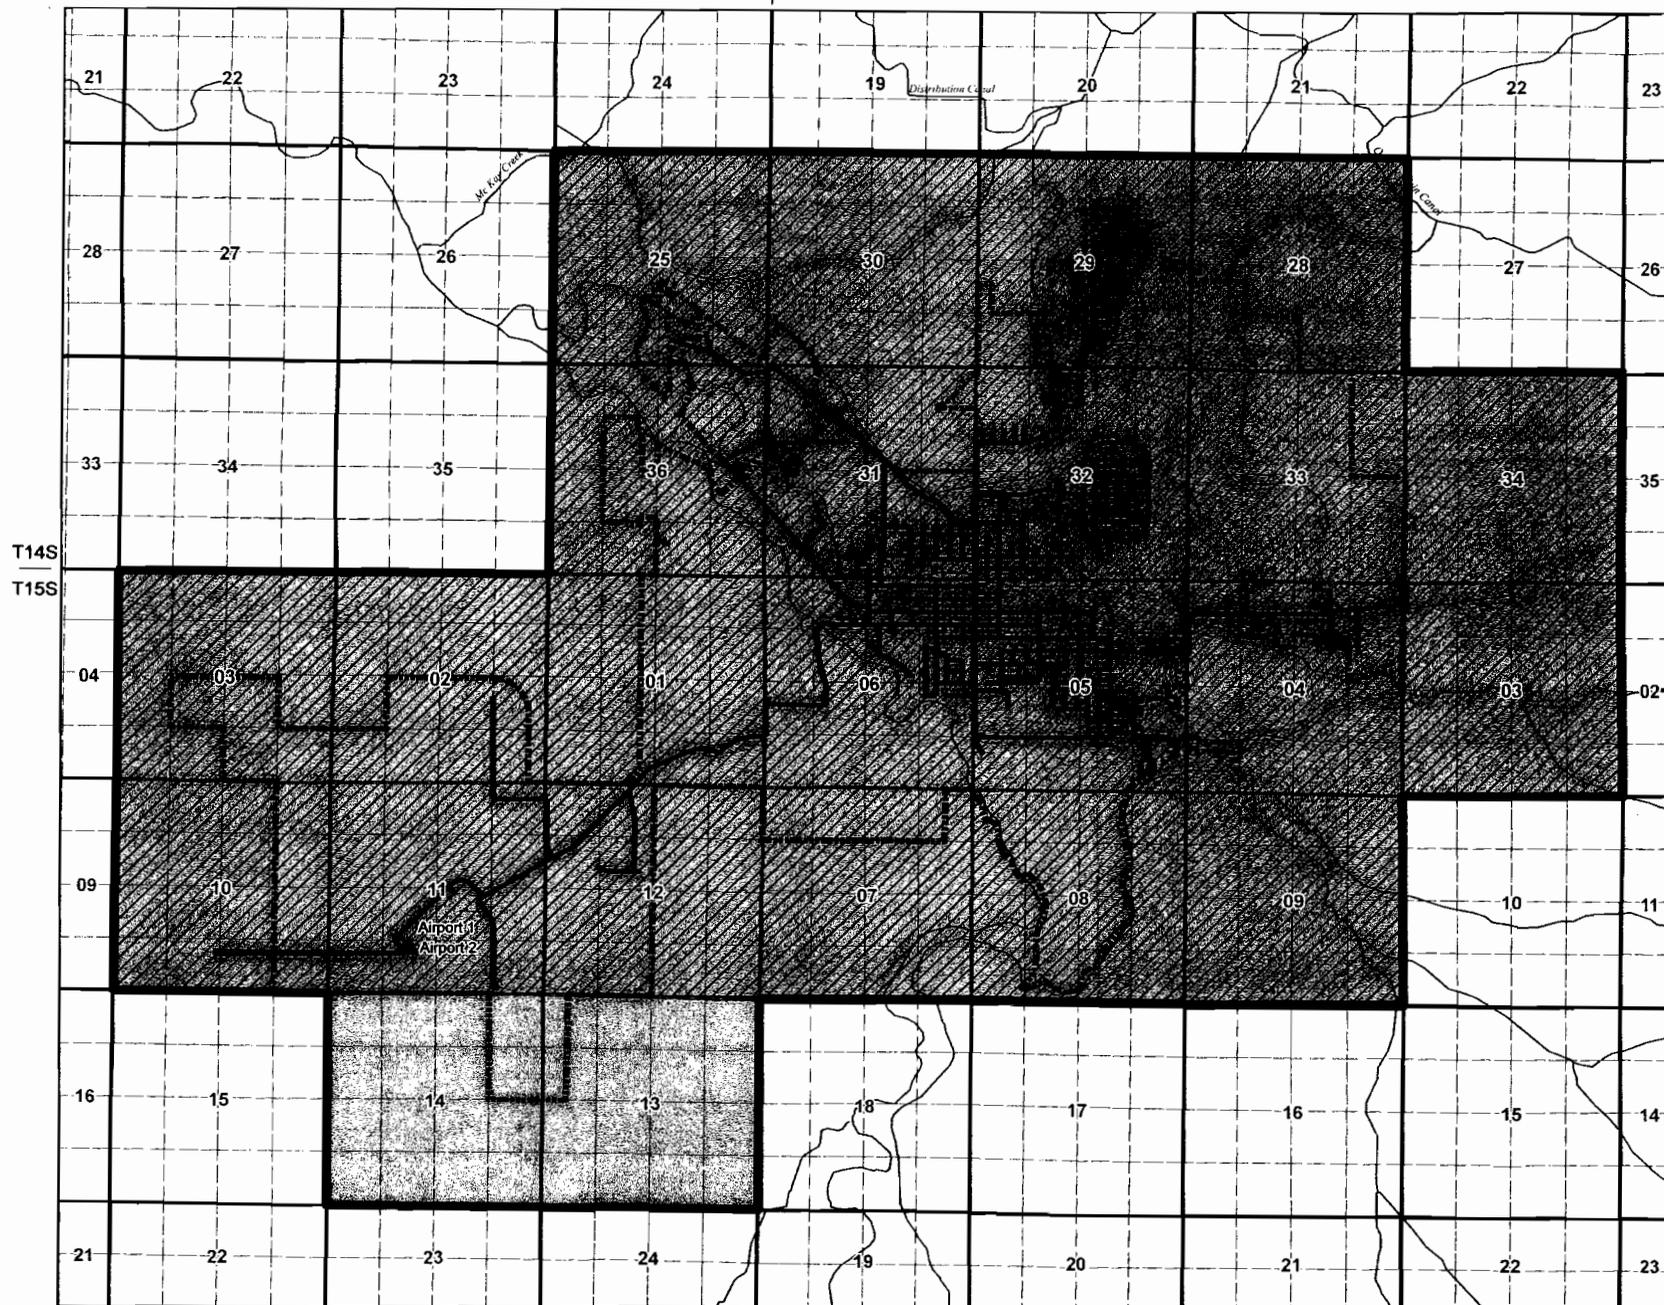

LEGEND

-  Prineville City Limits
-  City Water Main
-  G-16146 Point of Appropriation
-  G-16146 Existing Place of Use
-  G-16146 Revised Place of Use

Map Notes:

Map projection - Oregon Lambert Conformal Conic Datum - North American Datum of 1983-91 (HPGN). (Additional information on projection available at www.gis.state.or.us/data/doq/metadata.pdf)

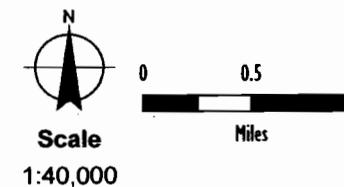


Figure 2
Proposed Place of Use
 City of Prineville
 Permit Amendment Application
 Permit G-16146 (Application G-15974)

Map Date: March 27, 2007
 Created by: R. Cook (GSI)



RECEIVED

MAY 02 2007

WATER RESOURCES DEPT
SALEM, OREGON

