

T 8506  
WATER RIGHT TRANSFER


RECEIVED

MAY 01 2000

WATER RESOURCES DEPT.  
SALEM, OREGON



NORTH  
Scale 1" = 1320'

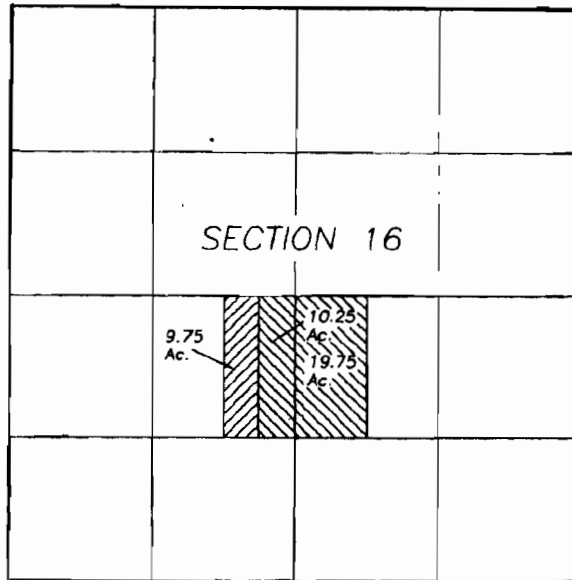

PERMIT NO. G-10704



RIGHT TO BE TRANSFERRED TO SE1/4,  
SECTION 17, T.25 S., R.18 E.

30.00 ACRES



RIGHT REMAINING

9.75 ACRES

ORIGINAL AREA FOR THIS RIGHT

39.75 ACRES

RECEIVED

THIS MAP DEPICTS WATER RIGHTS INFORMATION ONLY.  
AND DOES NOT REPRESENT A BOUNDARY SURVEY.

FEB 22 2008

WATER RESOURCES DEPT  
SALEM, OREGON



SHEET 2 OF 3

WATER RIGHT SURVEY  
FOR JEREMY WARKENTIN

NE1/4 SW1/4 & NW1/4 SE1/4, SECTION 16,  
T.27 S., R.18 E., LAKE COUNTY, OREGON

SCALE 1" = 1320'

DATE: APRIL 14, 2000

DRWN: RLB

FILE: D:\HOLD\JEREMY.DWG


SURVEY BY: MCCULLOUGH, BRYANT & ASSOC.

354 NE GREENWOOD #107, BEND, OREGON PH. 389-5766

T 10547

G-9121  
52877

T.26S., R.19E., W.M.

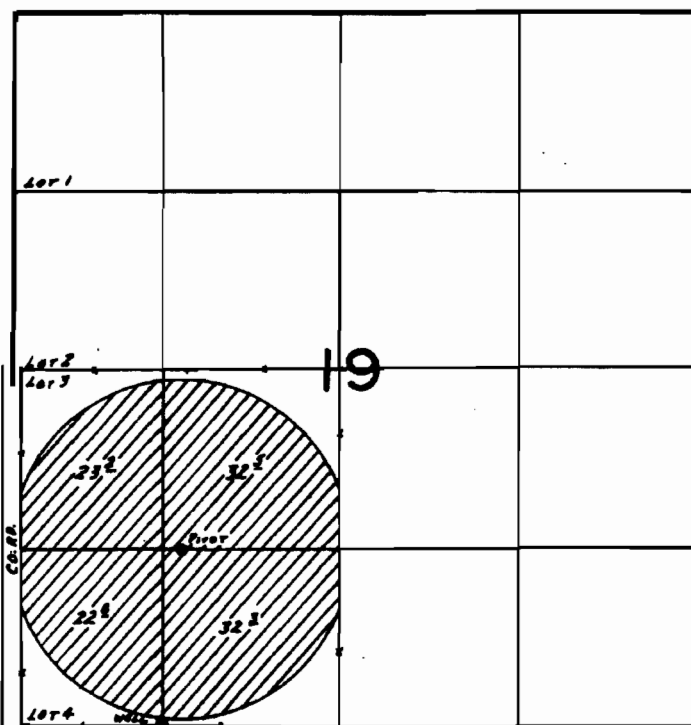

WELL LOC: 50' N. & 1100' E. FROM SW COR. SEC. 19


**FINAL PROOF SURVEY**  
UNDER

Application No. G-9966.. Permit No. G-9121.....  
IN NAME OF

.....CLAUDE ALAN BLACKMAN.....

Surveyed OCT. 13... 1984, by B.W. BISHOP.....

T.27S., R.18E., W.M.

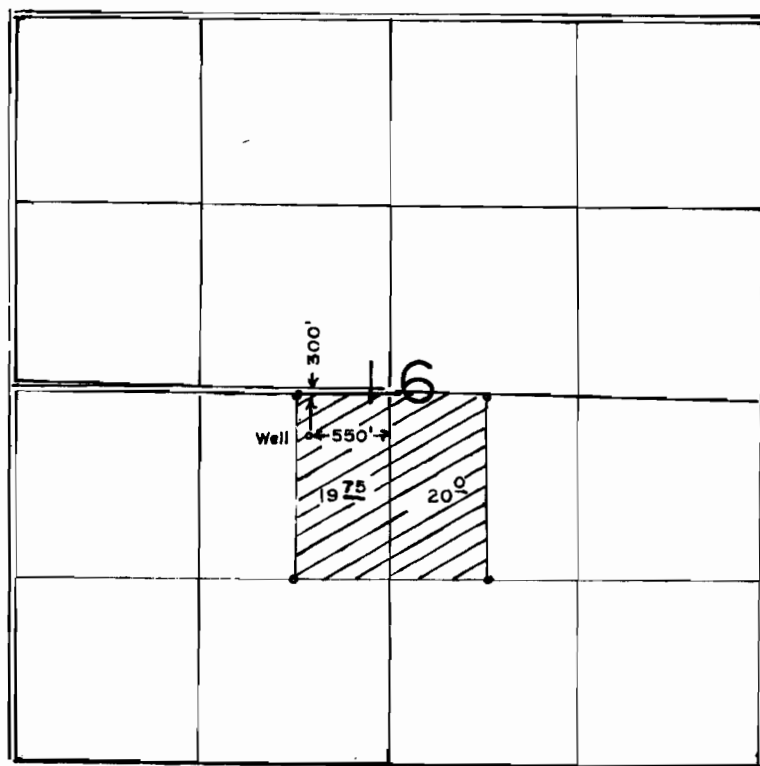

SCALE: 1"=1320'

**FINAL PROOF SURVEY**  
**UNDER**

Application No. G-11203 Permit No. G-10704...  
**IN NAME OF**

.....John H. & Patricia E. Effingham.....

Surveyed JUNE 5, 1990, by B.W. BISHOP.....

T 40547

2003 FSA Compliance Imagery  
T27S; R18E; sec 16




T 10547

**RECEIVED**

FEB 22 2008

WATER RESOURCES DEPT  
SALEM, OREGON

T26S,R19E, SECT:19

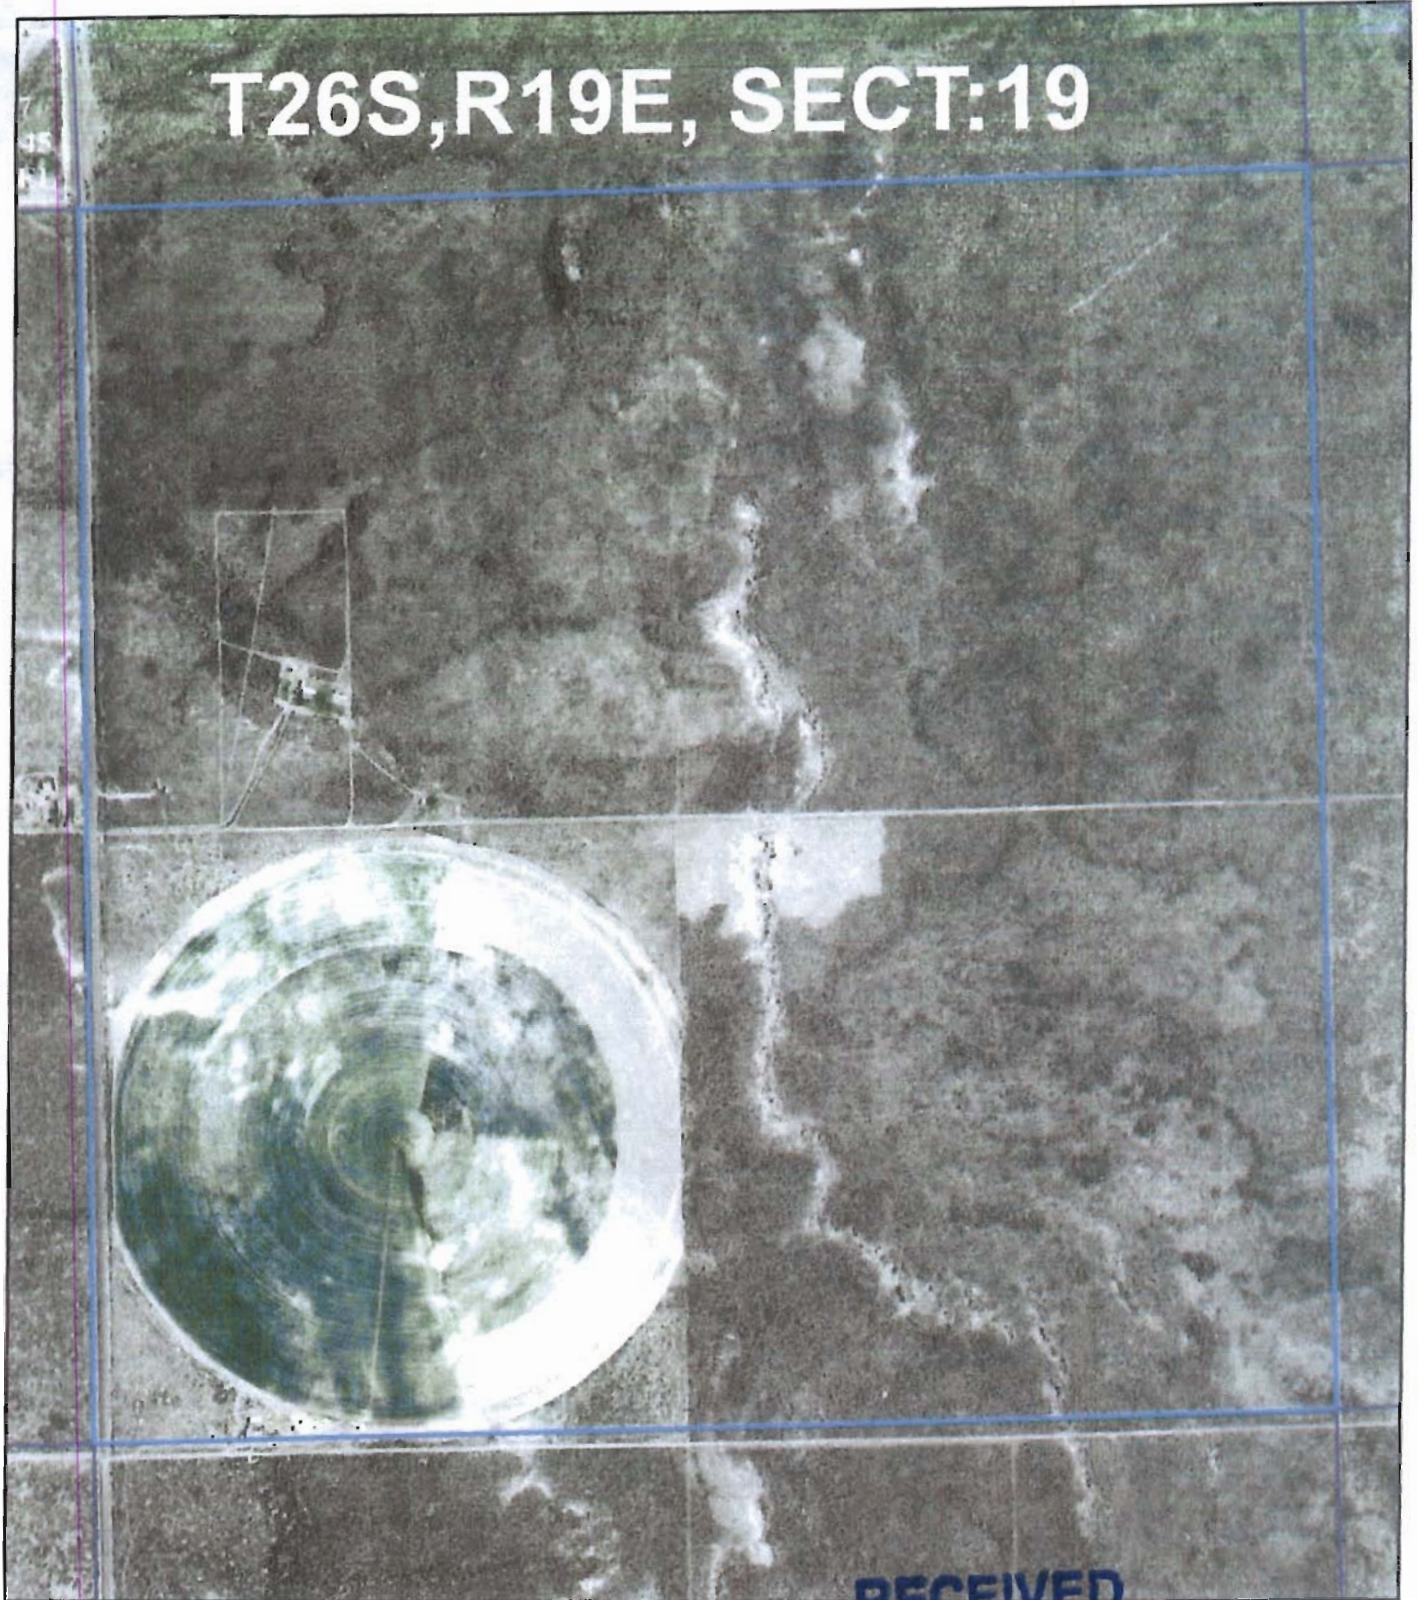

**USDA** USDA  
Farm Service Agency

2006

**Lake County**

July 09, 2007

0 200 400 800 1,200 1,600  
Feet

**RECEIVED**

FEB 22 2008

**WATER RESOURCES DEPT**  
SALEM, OREGON



This acreage is for FSA program  
purposes only. No warranty is  
made for any other use.

T 10547