


**Exhibit B: Map of McKenzie Piping Project**

**RECEIVED**

**FEB 28 2008**

**WATER RESOURCES DEPT  
SALEM, OREGON**

# Phase I

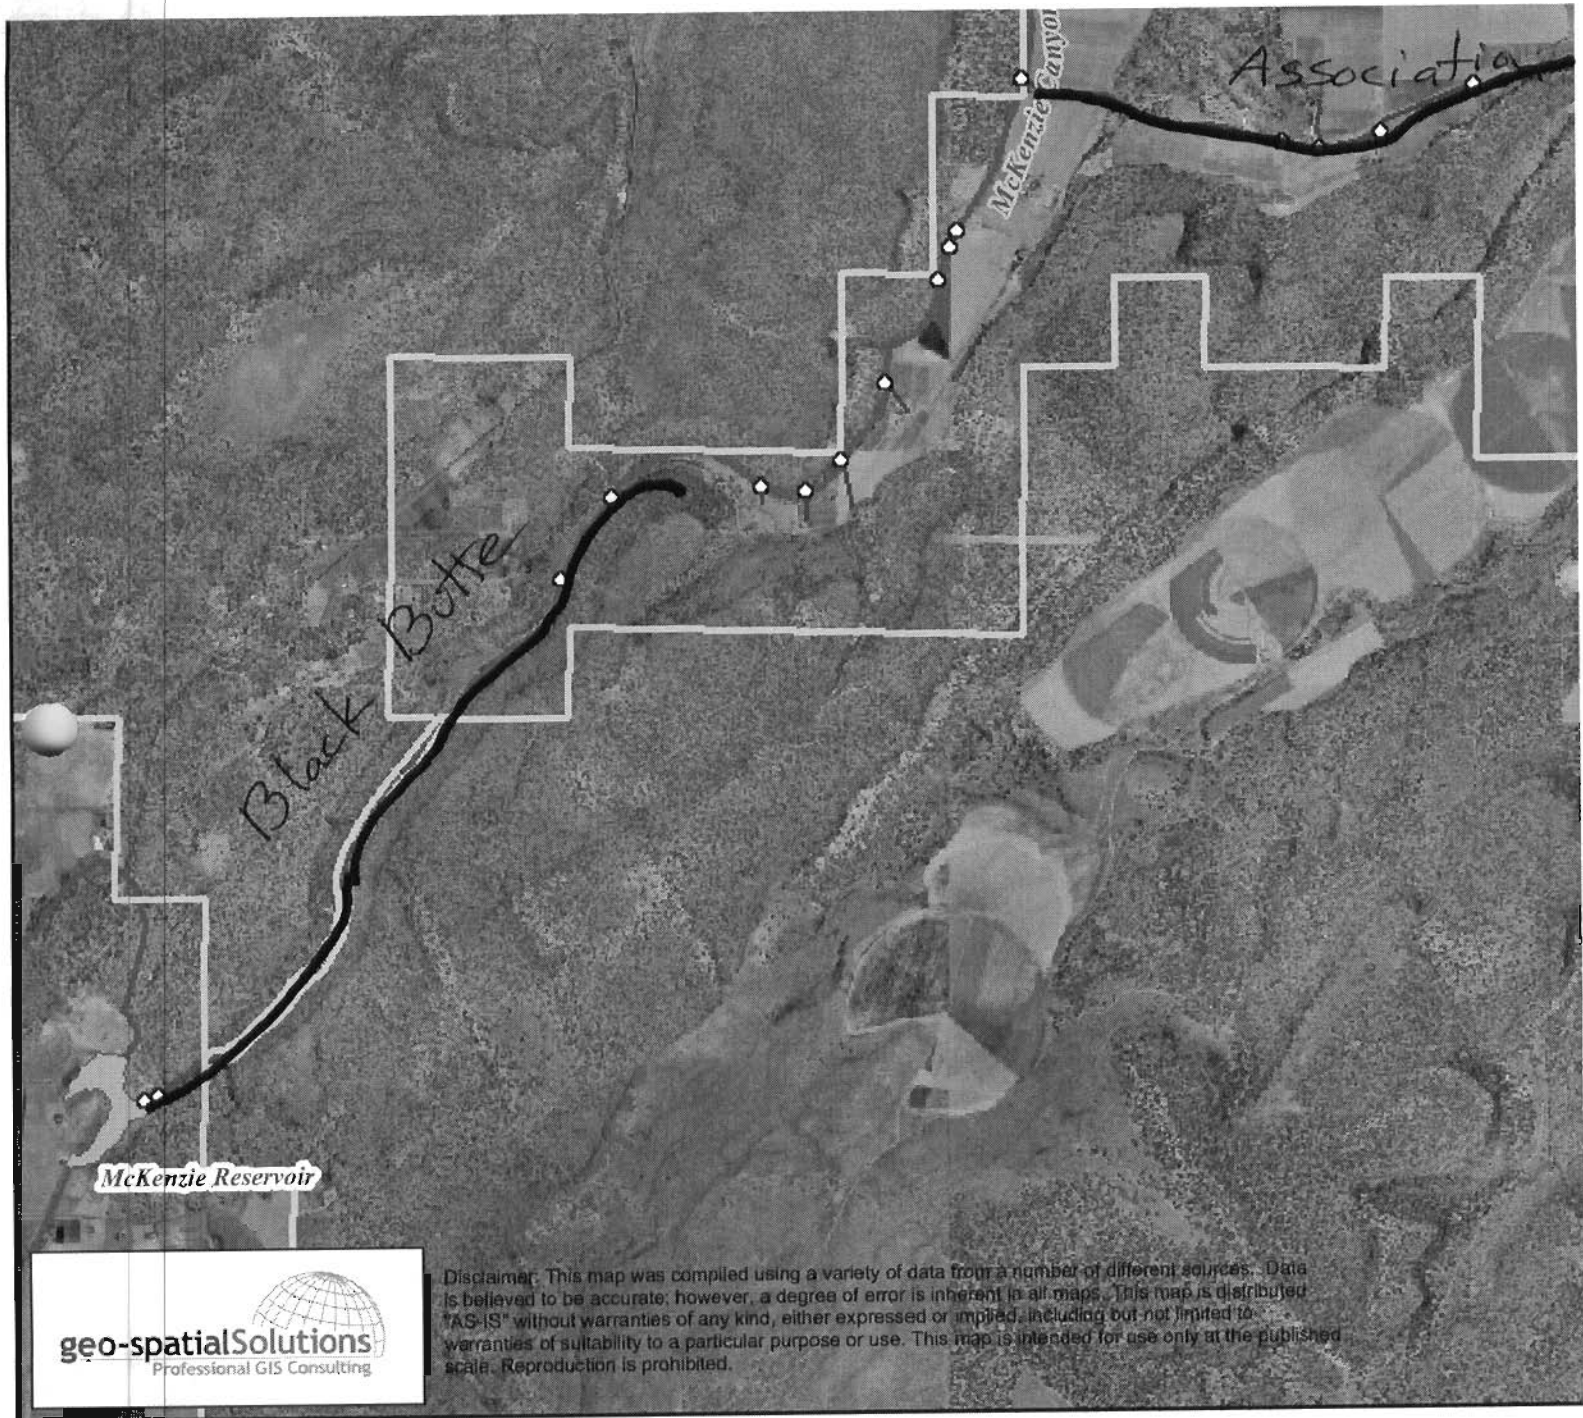

**RECEIVED**

FEB 28 2008

WATER RESOURCES DIVISION  
SALEM, OREGON