

2003 FSA Compliance Imagery
T27S; R18E; sec 16



T-1055b

RECEIVED

MAR 07 2008

WATER RESOURCES DEPT
SALEM, OREGON

T 8506
WATER RIGHT TRANSFER


RECEIVED

MAY 01 2000

WATER RESOURCES DEPT.
SALEM, OREGON



NORTH
Scale 1" = 1320'

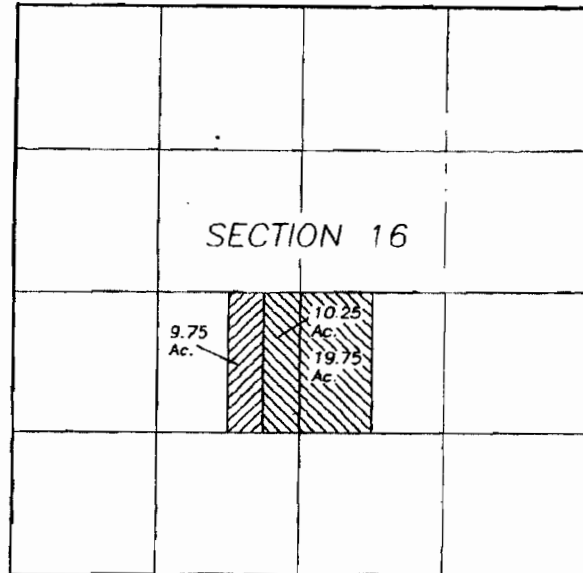

PERMIT NO. G-10704



RIGHT TO BE TRANSFERRED TO SE1/4,
SECTION 17, T.25 S., R.18 E.

30.00 ACRES



RIGHT REMAINING

9.75 ACRES

ORIGINAL AREA FOR THIS RIGHT

39.75 ACRES

RECEIVED

MAR 07 2008

WATER RESOURCES DEPT
SALEM, OREGON



SHEET 2 OF 3

THIS MAP DEPICTS WATER RIGHTS INFORMATION ONLY,
AND DOES NOT REPRESENT A BOUNDARY SURVEY.

WATER RIGHT SURVEY
FOR JEREMY WARKENTIN

NE1/4 SW1/4 & NW1/4 SE1/4, SECTION 16,
T.27 S., R.18 E., LAKE COUNTY, OREGON

SCALE 1" = 1320'

DATE: APRIL 14, 2000

DRWN: RLB

FILE: D:\HOLD\JEREMY.DWG

SURVEY BY: MCCULLOUGH, BRYANT & ASSOC.


354 NE GREENWOOD #107, BEND, OREGON PH. 389-5766

T-10556

THIS MAP WAS PREPARED FOR
ASSESSMENT PURPOSE ONLY

SECTION 19 T.26S. R.19E. W.M.
LAKE COUNTY
1" = 400'

26 19 19

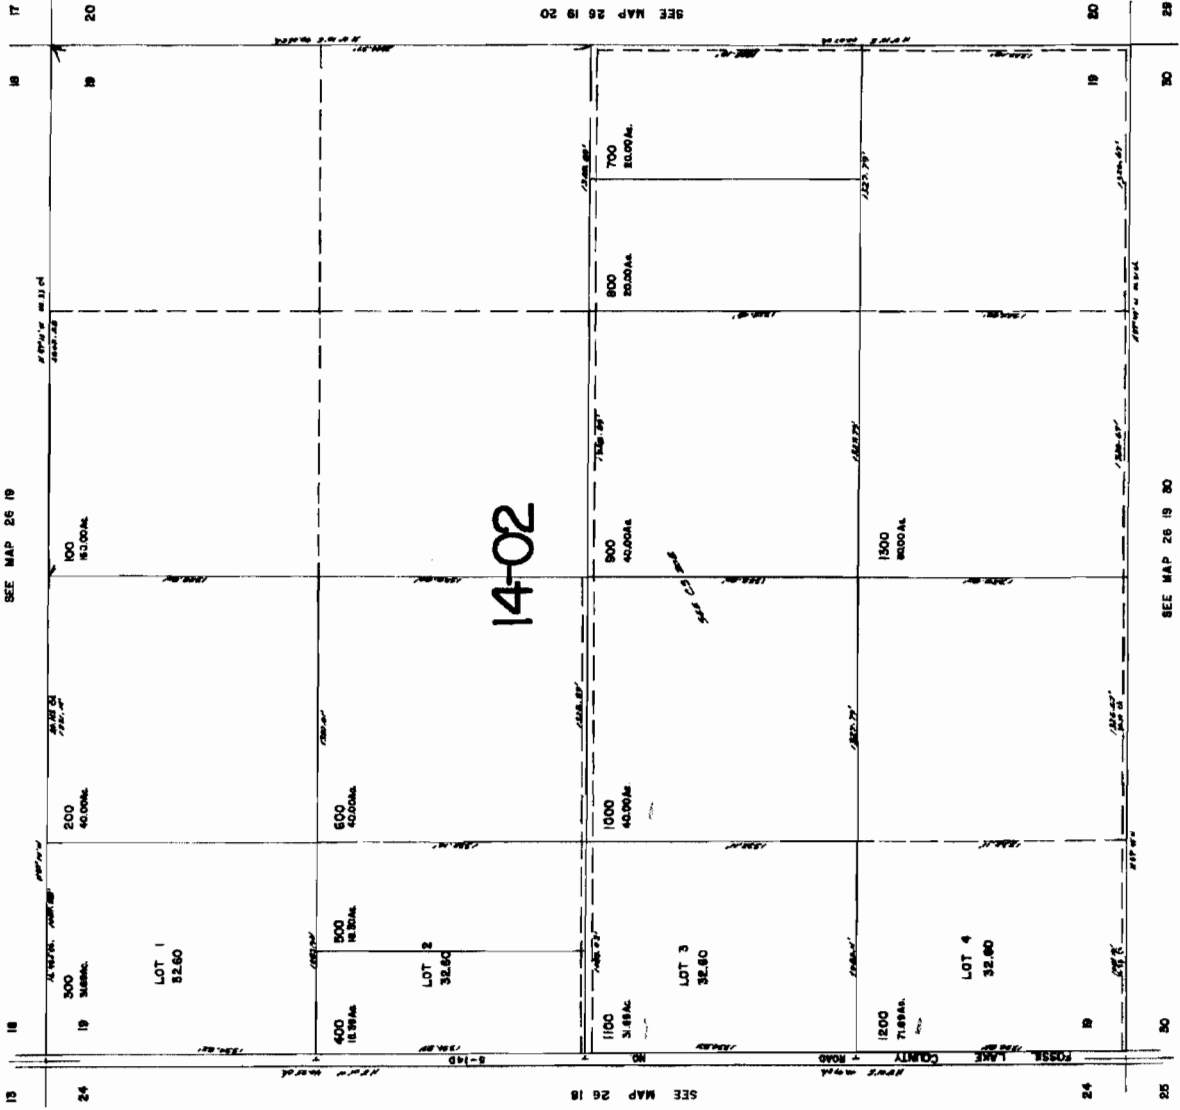

RECEIVED
MAR 07 2008
WATER RESOURCES DEPT
SALEM, OREGON

7-10556

26 19 19


THIS MAP WAS PREPARED FOR
ASSESSMENT PURPOSE ONLY

SECTION 16 T.27S. R.18E. W.M.
LAKE COUNTY

1" = 400'

0 100 200 300 400 500
SCALE IN FEET

SEE MAP 27 18 8

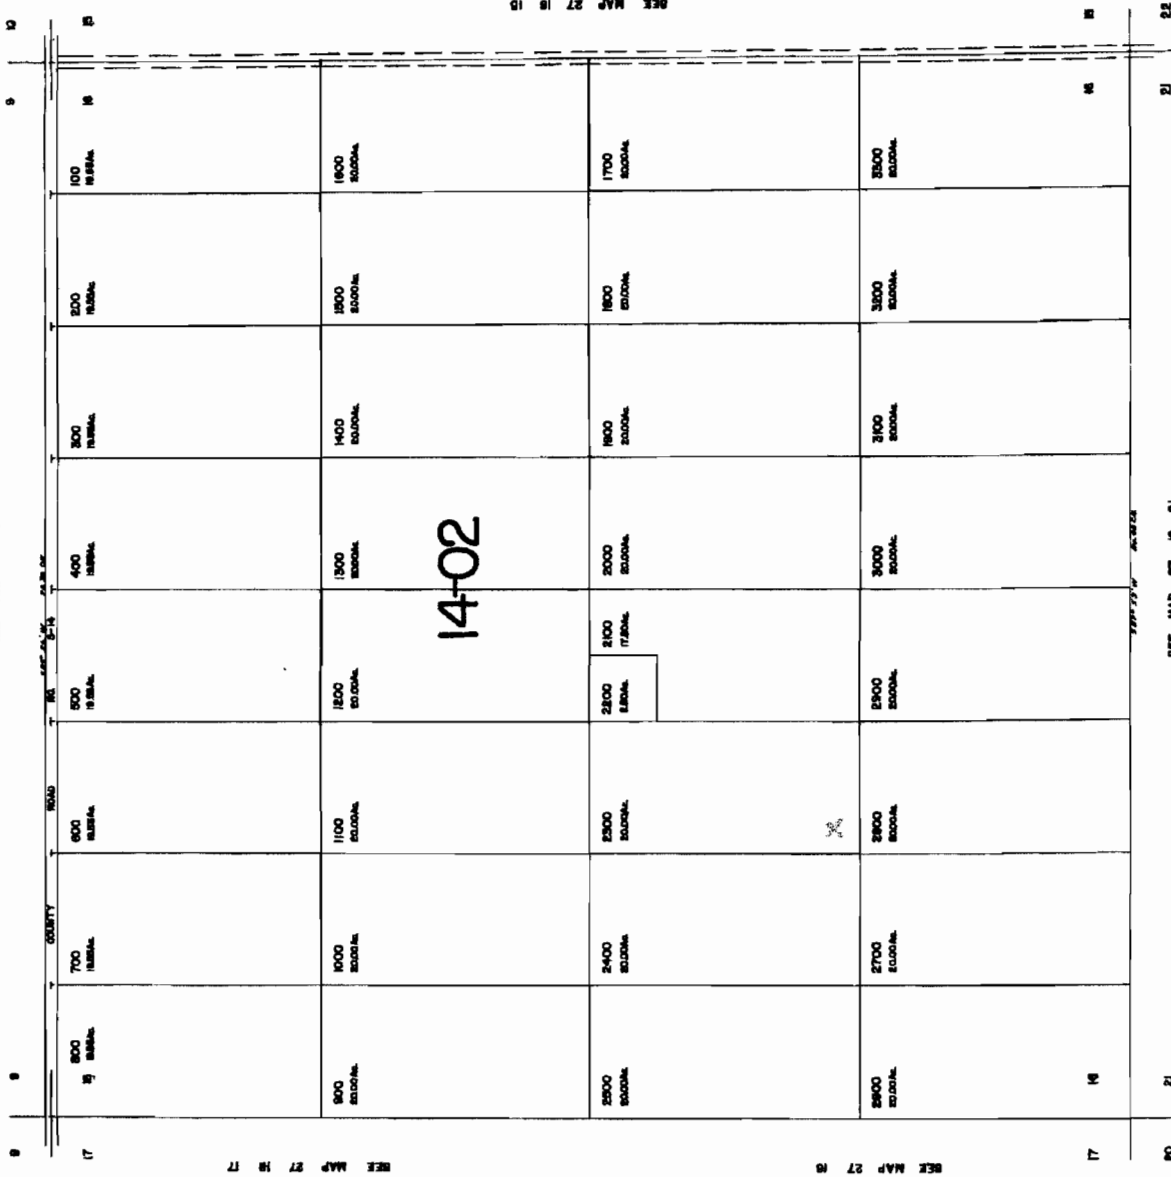

SEE MAP 27 18 8


RECEIVED

MAR 07 2008

WATER RESOURCES DEPT
SALEM, OREGON

7-10556

T.27S., R.18E., W.M.

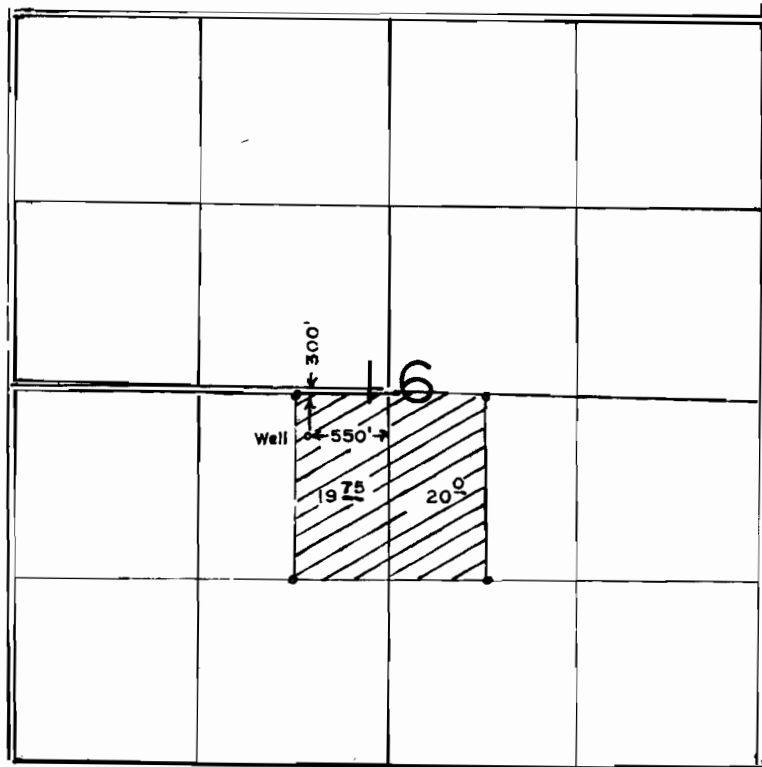

SCALE: 1"=1320'

FINAL PROOF SURVEY
UNDER

Application No. G-11203 Permit No. G-10704...
IN NAME OF

.....**John H. & Patricia E. Effingham**.....

Surveyed JUNE 5, 1990, by B.W. BISHOP.....


T-10556

PTS 11-1990

9-5-90 DLM

G-9121
52877

T.26S., R.19E., W.M.

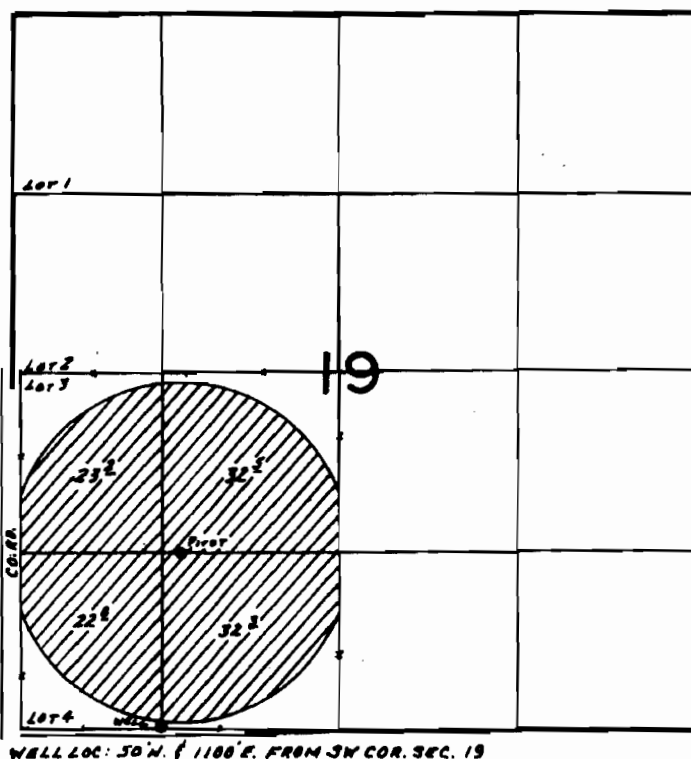

FINAL PROOF SURVEY
UNDER

Application No. G-9966.. Permit No. G-9121.....
IN NAME OF

.....CLAUDE ALAN BLACKMAN.....

Surveyed OCT. 13... 1984, by B.W. BISHOP.....

T-10556