


Township 105 Range 3W, W.M.
North

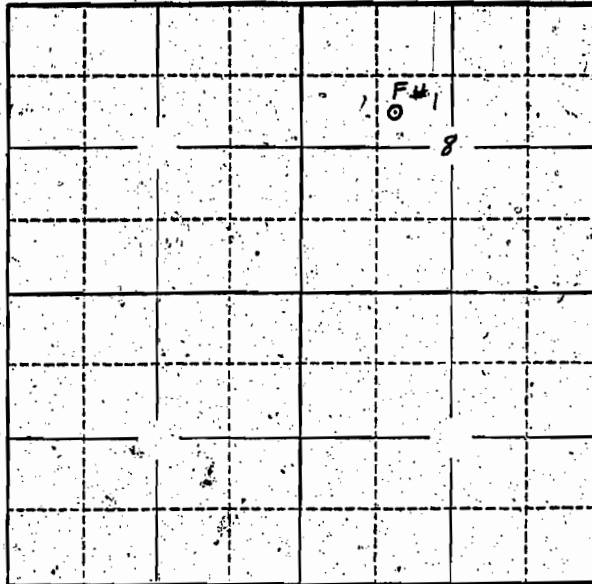

Locate well and acreage of irrigated land on plat.

Scale: 2" = 1 Mile

STATE OF OREGON

County of Marion

} ss.

I, _____ being first duly sworn, do hereby certify that I have read the foregoing Registration Statement and that all of the items therein contained are true to the best of my knowledge and belief.

Charles Jones
(Signature of Registrant)

Subscribed and sworn to before me this 29th day of July, 1958

My commission expires 12th June 1961

Wm. S. Bartholomew
(Notary Public)

(SEAL)

CERTIFICATE OF REGISTRATION

STATE OF OREGON

County of Marion

} ss.

This is to certify that the foregoing Registration Statement was received in the office of the State Engineer on the 29th day of July, 1958, at 12:00 o'clock A.M. and has been duly recorded in said office in Book No. 12 of Registration Statements on page GR-2777

Witness my hand this 25th day of May, 1959

Henry A. Stanley
(State Engineer)

By _____ (Deputy)

#15.00

GR-2777

10564

THIS MAP WAS PREPARED FOR ASSESSMENT PURPOSES ONLY

SEC. 08 T. 10S. R. 03W. W.M.
LINN COUNTY, OREGON

10 3W 8

1" = 100'

SEE MAP 10 3W 5

New Well Site

140-19

PARTITION PLAT
2007-97

100 84.39 AC

101 2.08 AC PARCEL 1

C.S. 24870

PARCEL 3

102 2.02 AC PARCEL 2

DEVER-CORNER RD.

COUNTY ROAD NO. 34

2400 3001 0.86 AC 102 0.86 AC

500 143.19 AC

700 83.07 AC

701 80.88 AC

PARCEL 2

1703 81.24 AC

PARTITION PLAT
2005-29

SEE MAP 10 3W 9



SEE MAP 10 3W 7

8-9

140-16

600 26.82 AC

800 140.88 AC

1 10564

S.E. COR. ST. JONES D.L.C. 73

SEE MAP 10 3W 17

10 3W 8

11/14/07.08:39:58.Wed

Gary & Goldie
Burton

GR 2960 Modification
T10S R3W Sec 8
TL 500
A in POA

Proposed well site
1430' S. and 840' W
of N 1/4 cor Sec 8.
N 44-71910
W 123-08530

Scale 1" = 1000'

RECEIVED
MAR 20 2008
WATER RESOURCES DEPT
SALEM, OREGON