

STATE ENGINEER
Salem, Oregon

LINN
4611

Well Record

STATE WELL NO. 10/3W-8F
COUNTY LINN
APPLICATION NO. GR-2960

OWNER: Charles LeRoy Jones


MAILING ADDRESS: R F D #2 Box 346

LOCATION OF WELL: Owner's No. #1

CITY AND STATE: Albany, Oregon

SE 1/4 NW 1/4 Sec. 8 T. 10 S. R. 3 W., W.M.

Bearing and distance from section or subdivision corner 2000' S. and 1650' E.

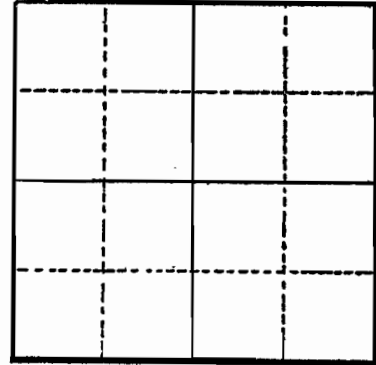

Section

Altitude at well

TYPE OF WELL: drilled Date Constructed 1948

Depth drilled 30 Depth cased 30

CASING RECORD:

10-inch

RECEIVED

MAR 20 2008

WATER RESOURCES DEPT
SALEM, OREGON

FINISH:

Perforated from 15 to 30

AQUIFERS:

sand and gravel

WATER LEVEL:

17-feet

PUMPING EQUIPMENT: Type Pacific Centrifugal H.P. 15

Capacity 150 G.P.M.

WELL TESTS:

Drawdown ft. after hours G.P.M.

Drawdown ft. after hours G.P.M.

USE OF WATER Irrigation Temp. °F. 19

SOURCE OF INFORMATION GR-2777

DRILLER or DIGGER Jim Sneed

ADDITIONAL DATA:

Log Water Level Measurements Chemical Analysis Aquifer Test

REMARKS:

Sand and gravel 0 30