


T. 3N. R. 28E. W. M.

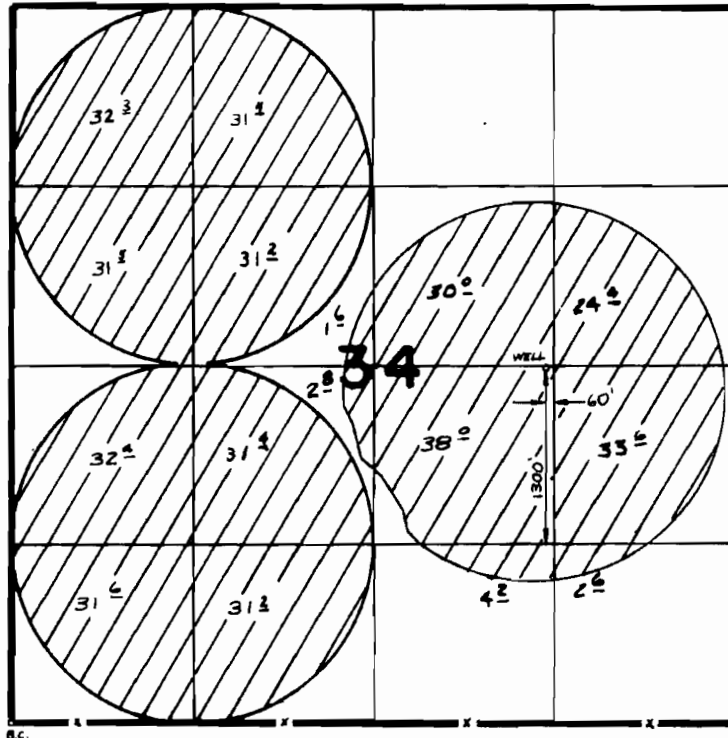

FINAL PROOF SURVEY
UNDER

RECORDED
INDEXED
WATER RESOURCES DEPT.
SALEM, OREGON

Application No. **G-5820** Permit No. **G-5812**
IN NAME OF

..... *David Sparks*

Surveyed *4-30* 19*72*, by *R. BARWIN*.....