


G 9171
53056

T.27S.,R.16E.,W.M.

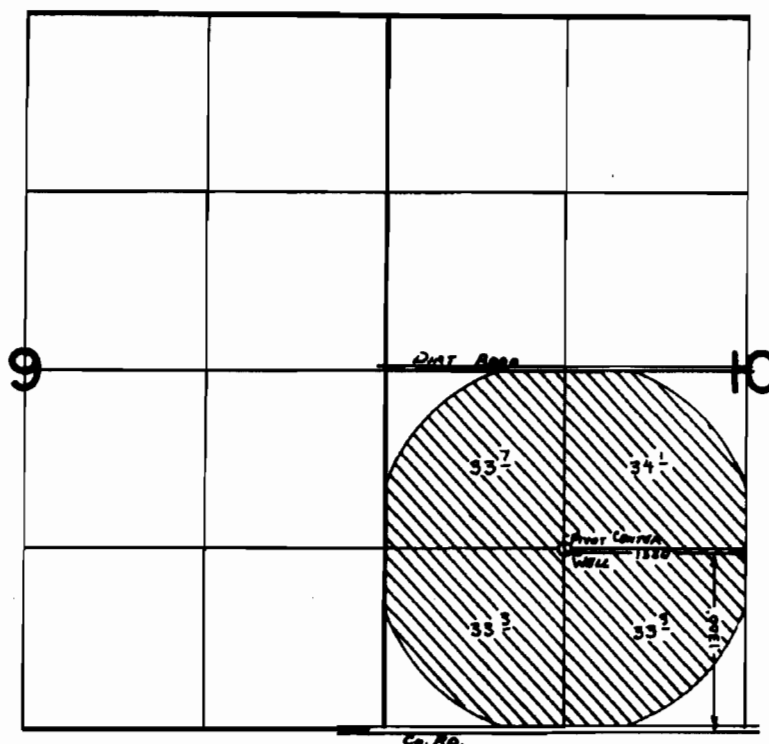

FINAL PROOF SURVEY
UNDER


Application No. G:10099. Permit No. G:9171.....
IN NAME OF

.....JIM ROBEY, Jr.

Surveyed July 25, 1983, by L. M. TOLL.....

T 10601

null

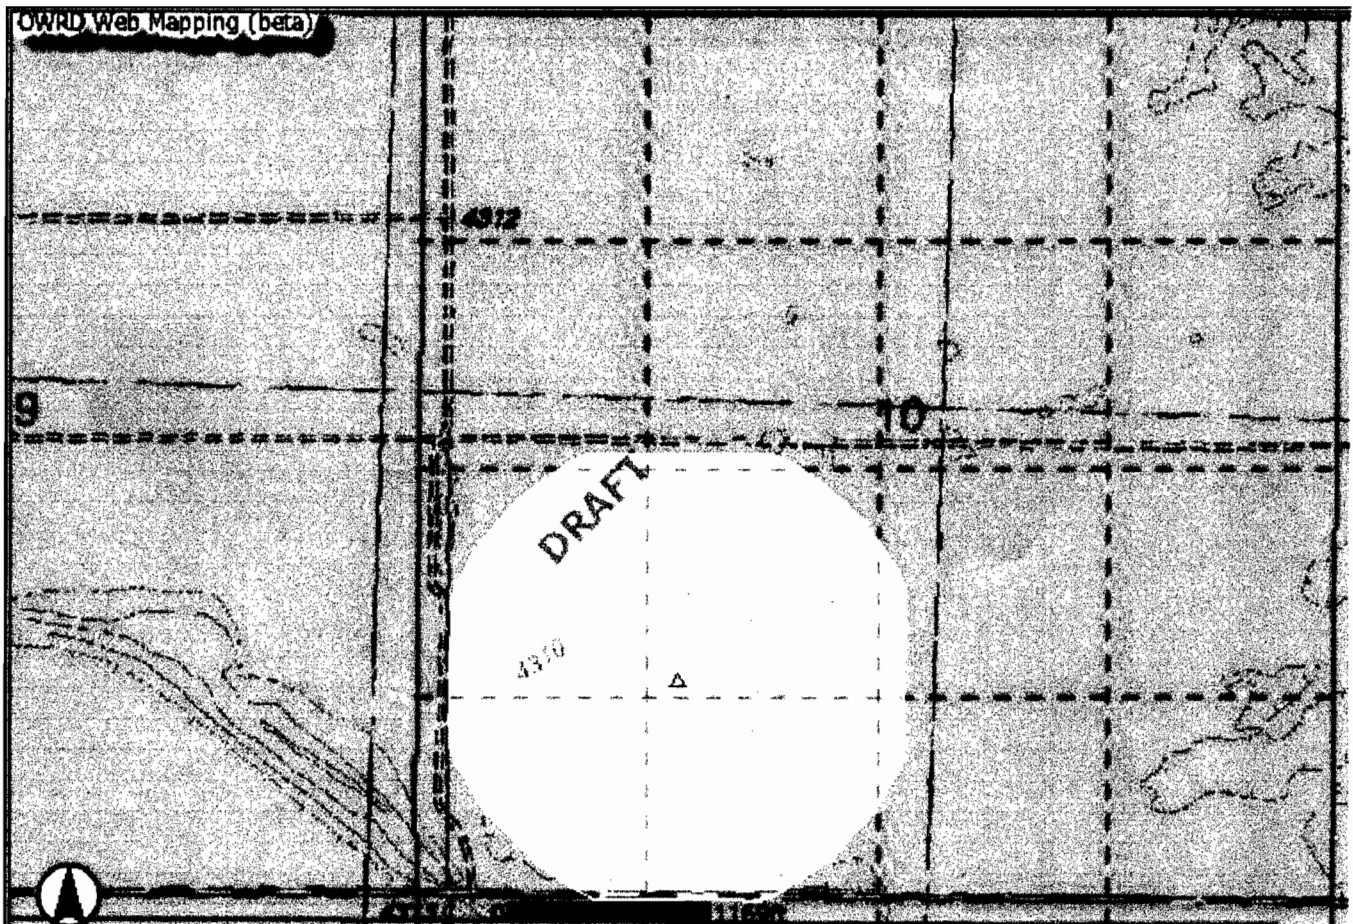

RECEIVED


APR 2 1 2008

WATER RESOURCES DEPT
SALEM OREGON

T 10601

MAP TO ACCOMPANY APPLICATION
TO CHANGE PLACE OF USE
AND POINT OF APPROPRIATION
FOR
JERRY AND LINDA NEWMAN

ALL WITHIN TOWNSHIP 27 SOUTH, RANGE 16, W.M.
LAKE COUNTY, OREGON

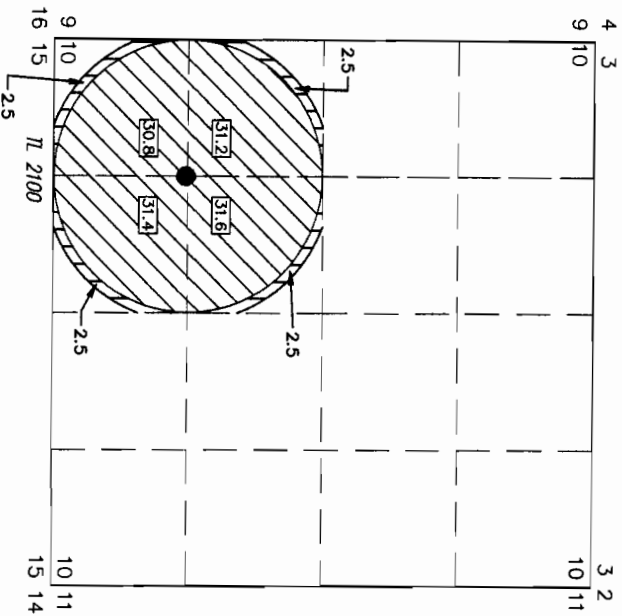

● AUTHORIZED P.O.A. PER CERTIFICATE NO. 53056, IS
LOCATED IN THE SE 1/4 SW 1/4 AND 1320 FEET NORTH
AND 1320 FEET WEST FROM THE S 1/4 CORNER OF SECTION
10. WELL TO REMAIN IN USE.

● ADDITIONAL P.O.A. FOR CERTIFICATE NO. 53056, IS LOCATED
IN THE NE 1/4 NW 1/4 AND 460 FEET SOUTH AND 280
FEET WEST FROM THE N 1/4 CORNER OF SECTION 24.




EXISTING CONFIGURATION OF WATER RIGHTS PER
CERTIFICATE NO. 53056.



CONFIGURATION OF CERTIFICATE NO. 53056 AFTER
TRANSFER TO IL 600.

THIS MAP IS FOR THE PURPOSE OF LOCATING A WATER RIGHT ONLY AND HAS NO
INTENT TO PROVIDE LEGAL DIMENSIONS OR THE LOCATION OF PROPERTY LINES

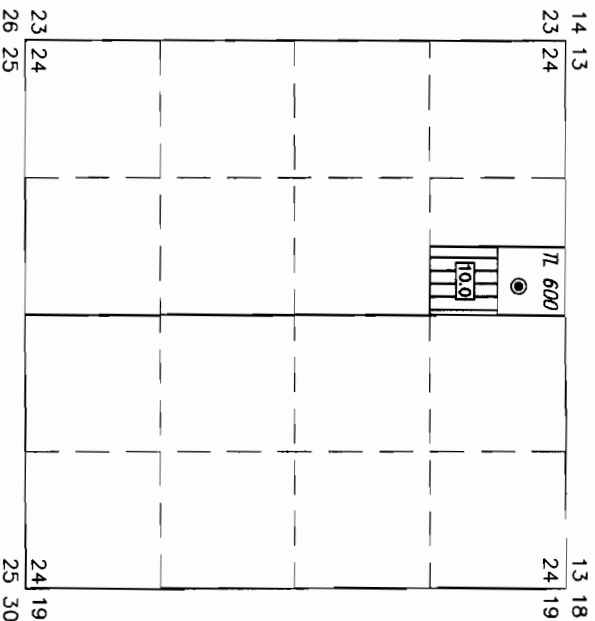

T 10601

PROJECT No. 08-023


PREPARED AT THE REQUEST OF:

JERRY AND LINDA NEWMAN
P.O. BOX 761
CHRISTMAS VALLEY, OR 97641



ALL POINTS ENGINEERING
& SURVEYING, INC.

P.O. BOX 767 (CRR)
TERREBONNE, OREGON 97760
(541) 548-5833 PH
(541) 585-4602 FX
www.APEandS.com

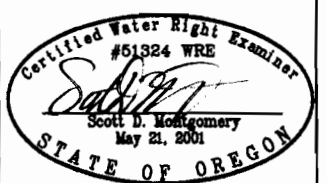

RENEWAL DATE: 12/31/2008