
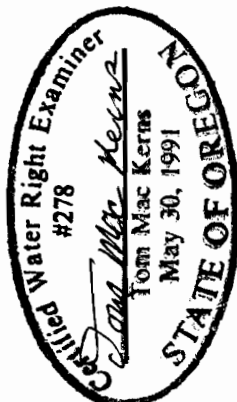





Richard Stephens Transfer "FROM" Map

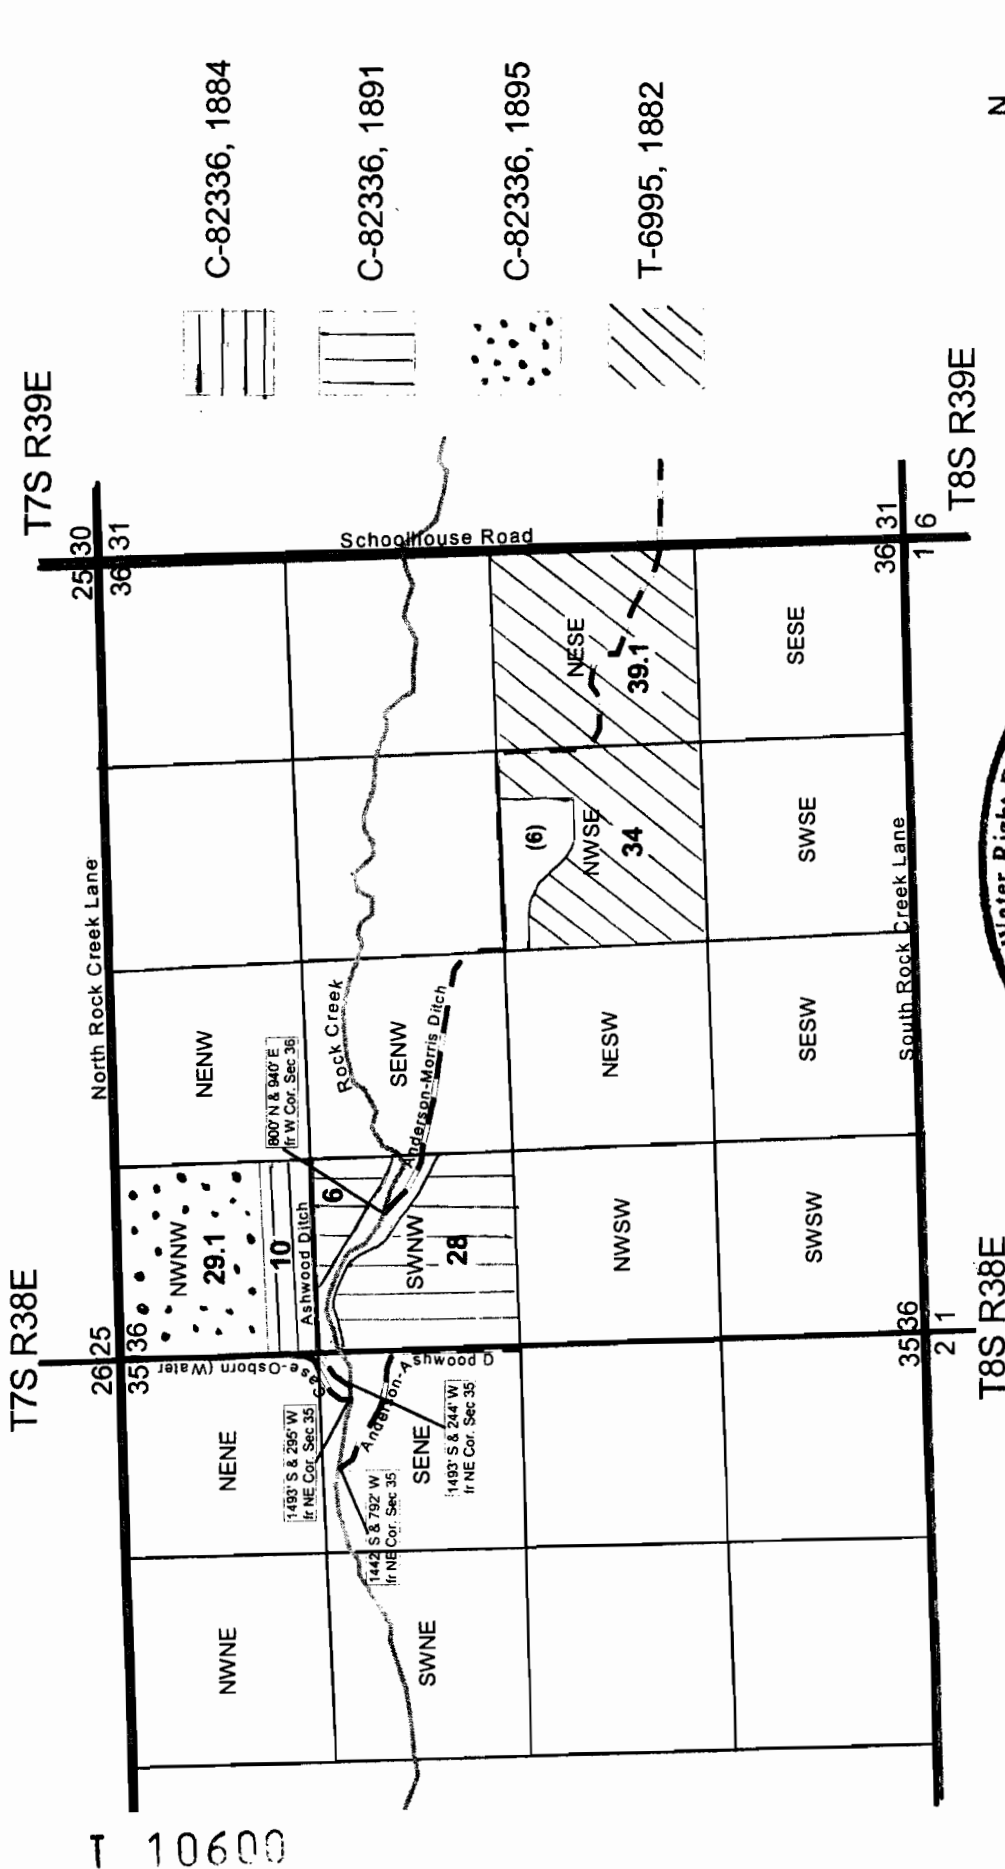

RECEIVED
 APR 14 2008
 WATER RESOURCES DEPT
 SALEM, OREGON

T 10600

Richard Stephens Transfer "TO" Map

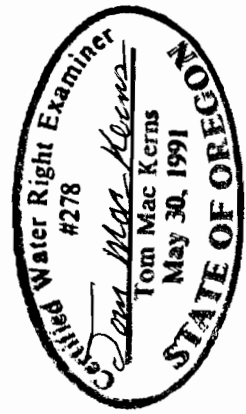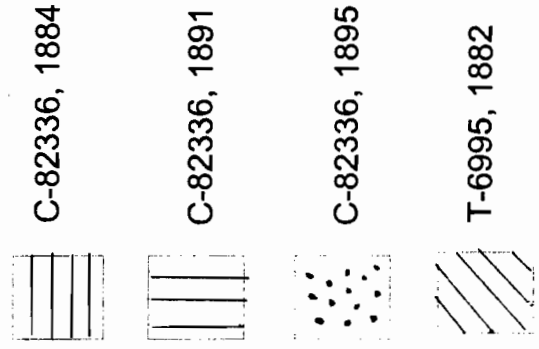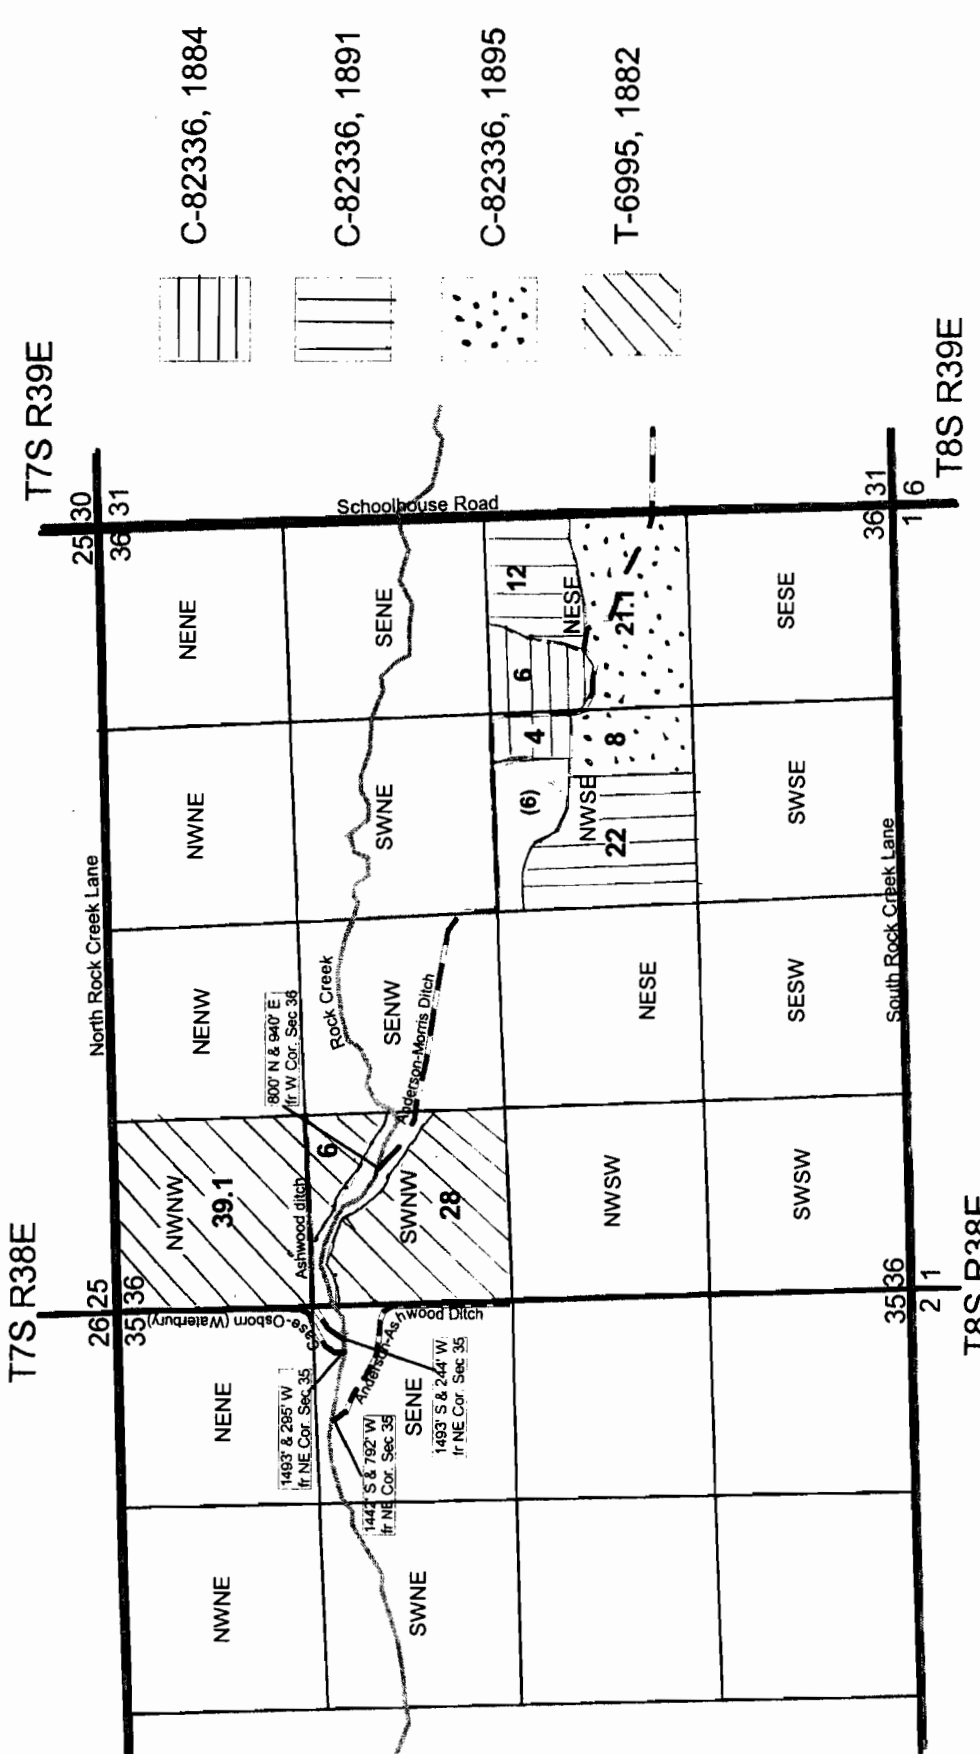

RECEIVED

APR 14 2008

WATER RESOURCES DEPT
SALEM, OREGON

T 10600