



**RECEIVED** Tax Lot Map  
APR 21 2008  
WATER RESOURCES DEPT  
SALEM OREGON

WELL LOCATION  
~~XXXXXXXXXX~~  
N 45° 13.954  
W 122° 41.322

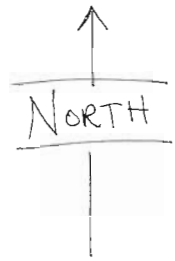

Approx. Scale  
1" = 1320'

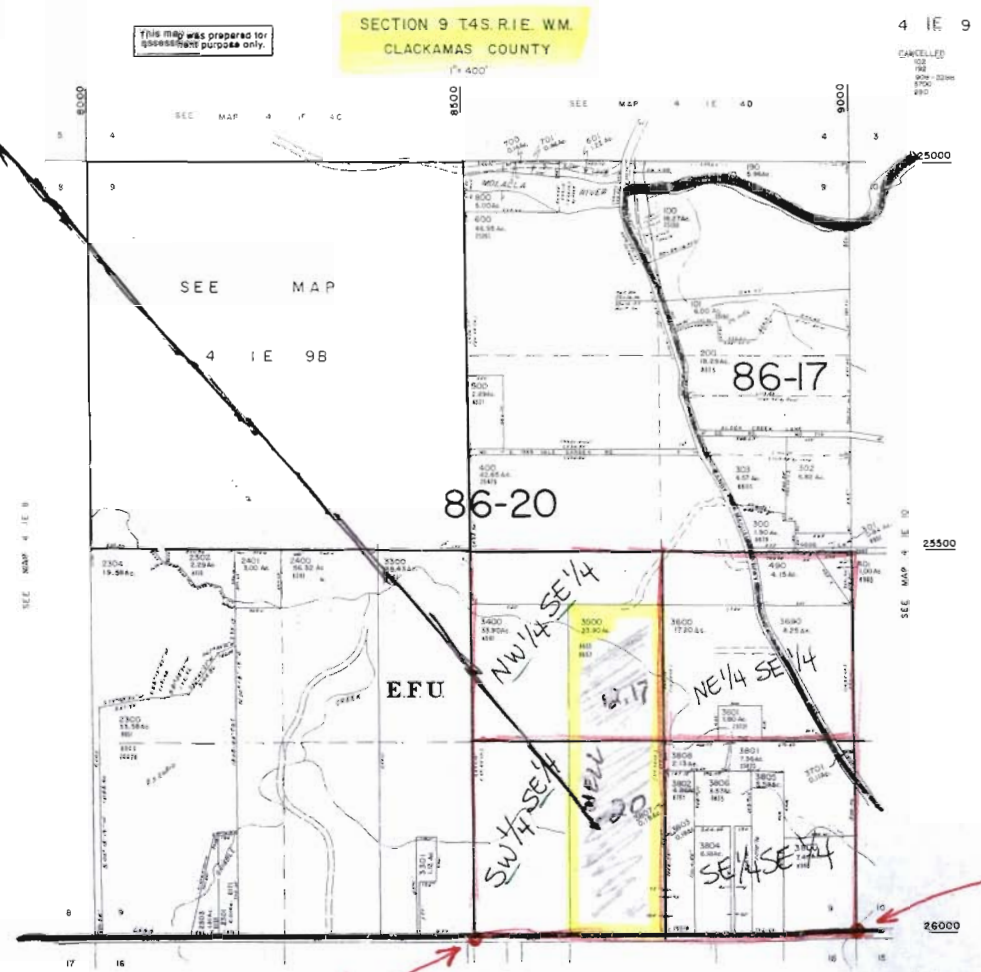

T 10603

South 1/4 corner of Sec. 9

SE corner of Section 9

F.H.D.  
4 IE 9

