

STATE ENGINEER
Salem, Oregon


CLAC
013050

Well Record

STATE WELL NO. 4/1E - 9P
COUNTY CLACKAMAS
APPLICATION NO. GR-2242

OWNER: Steele's Pansy Gardens, Inc. MAILING ADDRESS: Rt. 3, Box 206
LOCATION OF WELL: Owner's No. CITY AND STATE: Canby, Oregon

SE 1/4 SW 1/4 Sec. 9 T. 4 N. S. R. 1 E. W.M.
Bearing and distance from section or subdivision corner 1710' W. and 400' N.

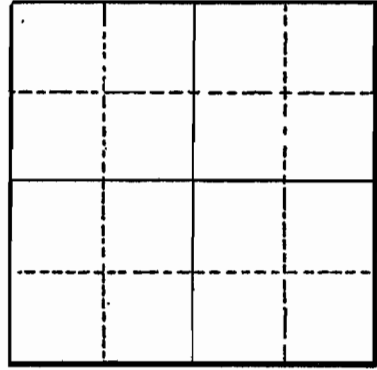

Section

Altitude at well
TYPE OF WELL: Drilled Date Constructed 1950
Depth drilled 155 Depth cased 155

CASING RECORD:

8-Inch

FINISH:

Perforations from 137 to 142
Perforations from 146 to bottom

RECEIVED

AQUIFERS:

Silt

APR 21 2008
WATER RESOURCES DEPT
SALEM OREGON

WATER LEVEL:

32-Feet

PUMPING EQUIPMENT: Type Peerless Turbine H.P. 7 1/2
Capacity 160 G.P.M.

WELL TESTS:

Drawdown 68 ft. after hours Pumping 300 G.P.M.
Drawdown ft. after hours G.P.M.

USE OF WATER Irrigation Temp. °F. 19

SOURCE OF INFORMATION GR-2143

DRILLER or DIGGER John Beck, Canby, Oregon

ADDITIONAL DATA:

Log X Water Level Measurements Chemical Analysis Aquifer Test

REMARKS:

RECEIVED

MAR 24 2008

WATER RESOURCES DEPT
SALEM, OREGON

STATE ENGINEER
Salem, Oregon

State Well No. 4/1 - 9P
County CLACKAMAS
Application No. GR-2242

Well Log

Owner: Steele's Pansy Gardens, Inc. Owner's No. _____

Driller: John Beck Date Drilled _____

CHARACTER OF MATERIAL	(Feet below surface)		Thickness (feet)
	To	From	
Top soil	4		4
Brown silt	33		28
Brown gravel	49		16
Blue silt	78		29
Blue clay	114		36
Fine dark sand	118		4
Dark blue silt	128		10
Sand becoming coarser	137		9
Small gravel	140		3
Clay - blue	146		6
Gravel coarse	154		9
Blue clay	155		?

RECEIVED

APR 21 2008

WATER RESOURCES DEPT
SALEM OREGON

RECEIVED

MAR 24 2008