

RECEIVED

MAY 01 2008

WATER RESOURCES DEPT. SALEM, OREGON 01N 10E 01

SECTION 01 T.01N. R.10E. W.M. HOOD RIVER COUNTY


1"=400'

HIS MAP WAS PREPARED FOR ASSESSMENT PURPOSE ONLY

CANCELLED NO.

- 101
- 401
- 1200
- 2200
- 2501


Transfer To - 43
 C. 81340 - 24
 C. 80929 - 19

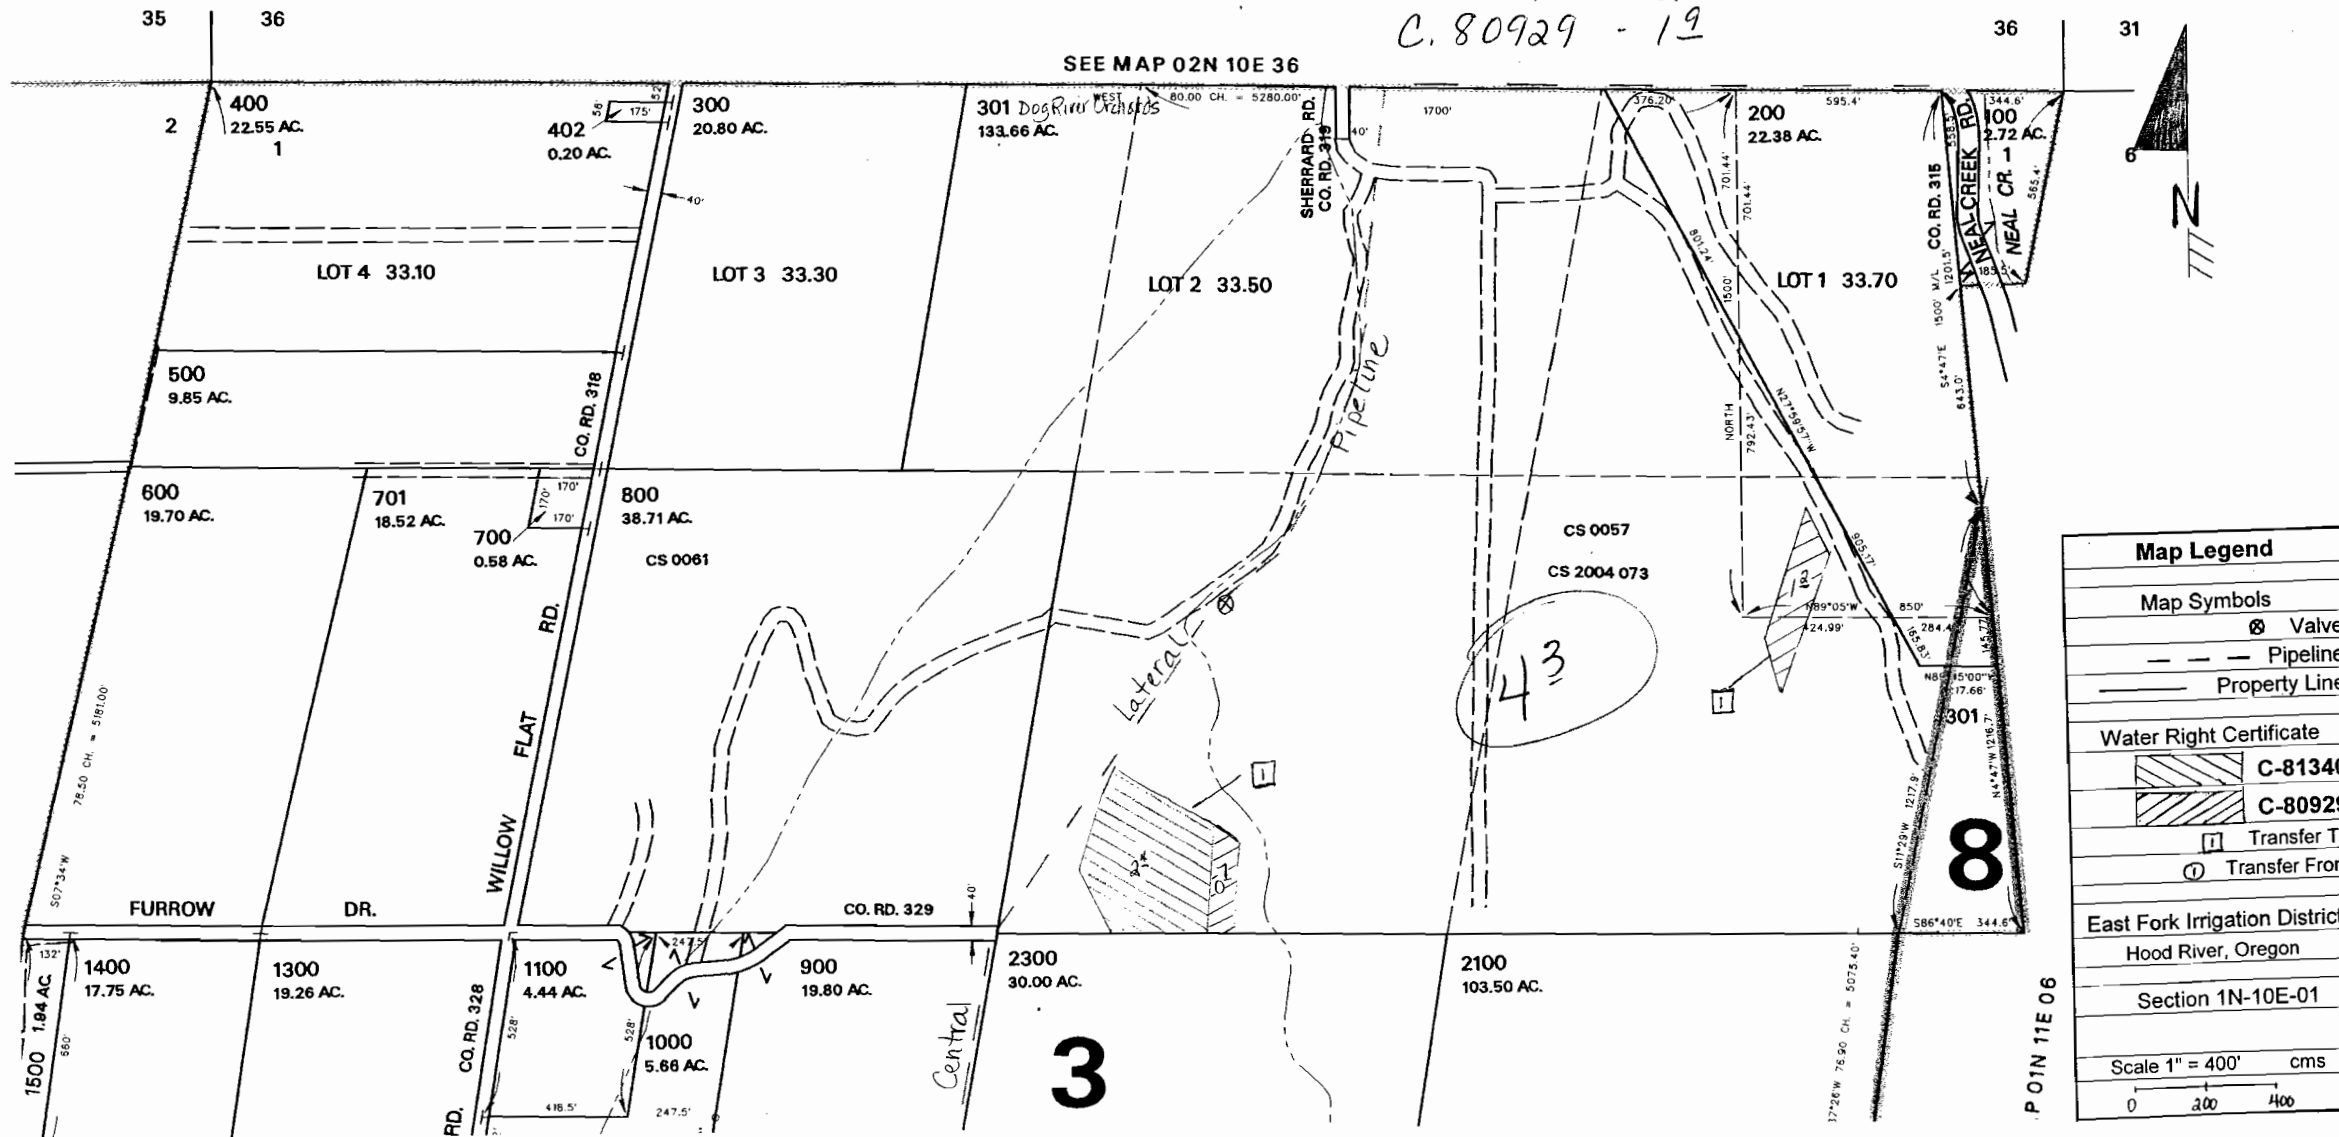

Map Legend	
Map Symbols	
	Valve
	Pipeline
	Property Line
Water Right Certificate	
	C-81340
	C-80929
	Transfer To
	Transfer From
East Fork Irrigation District Hood River, Oregon	
Section 1N-10E-01	
Scale 1" = 400' cms	
0 200 400	

SEE MAP 01N 10E 02

SEE MAP 01N 11E 06

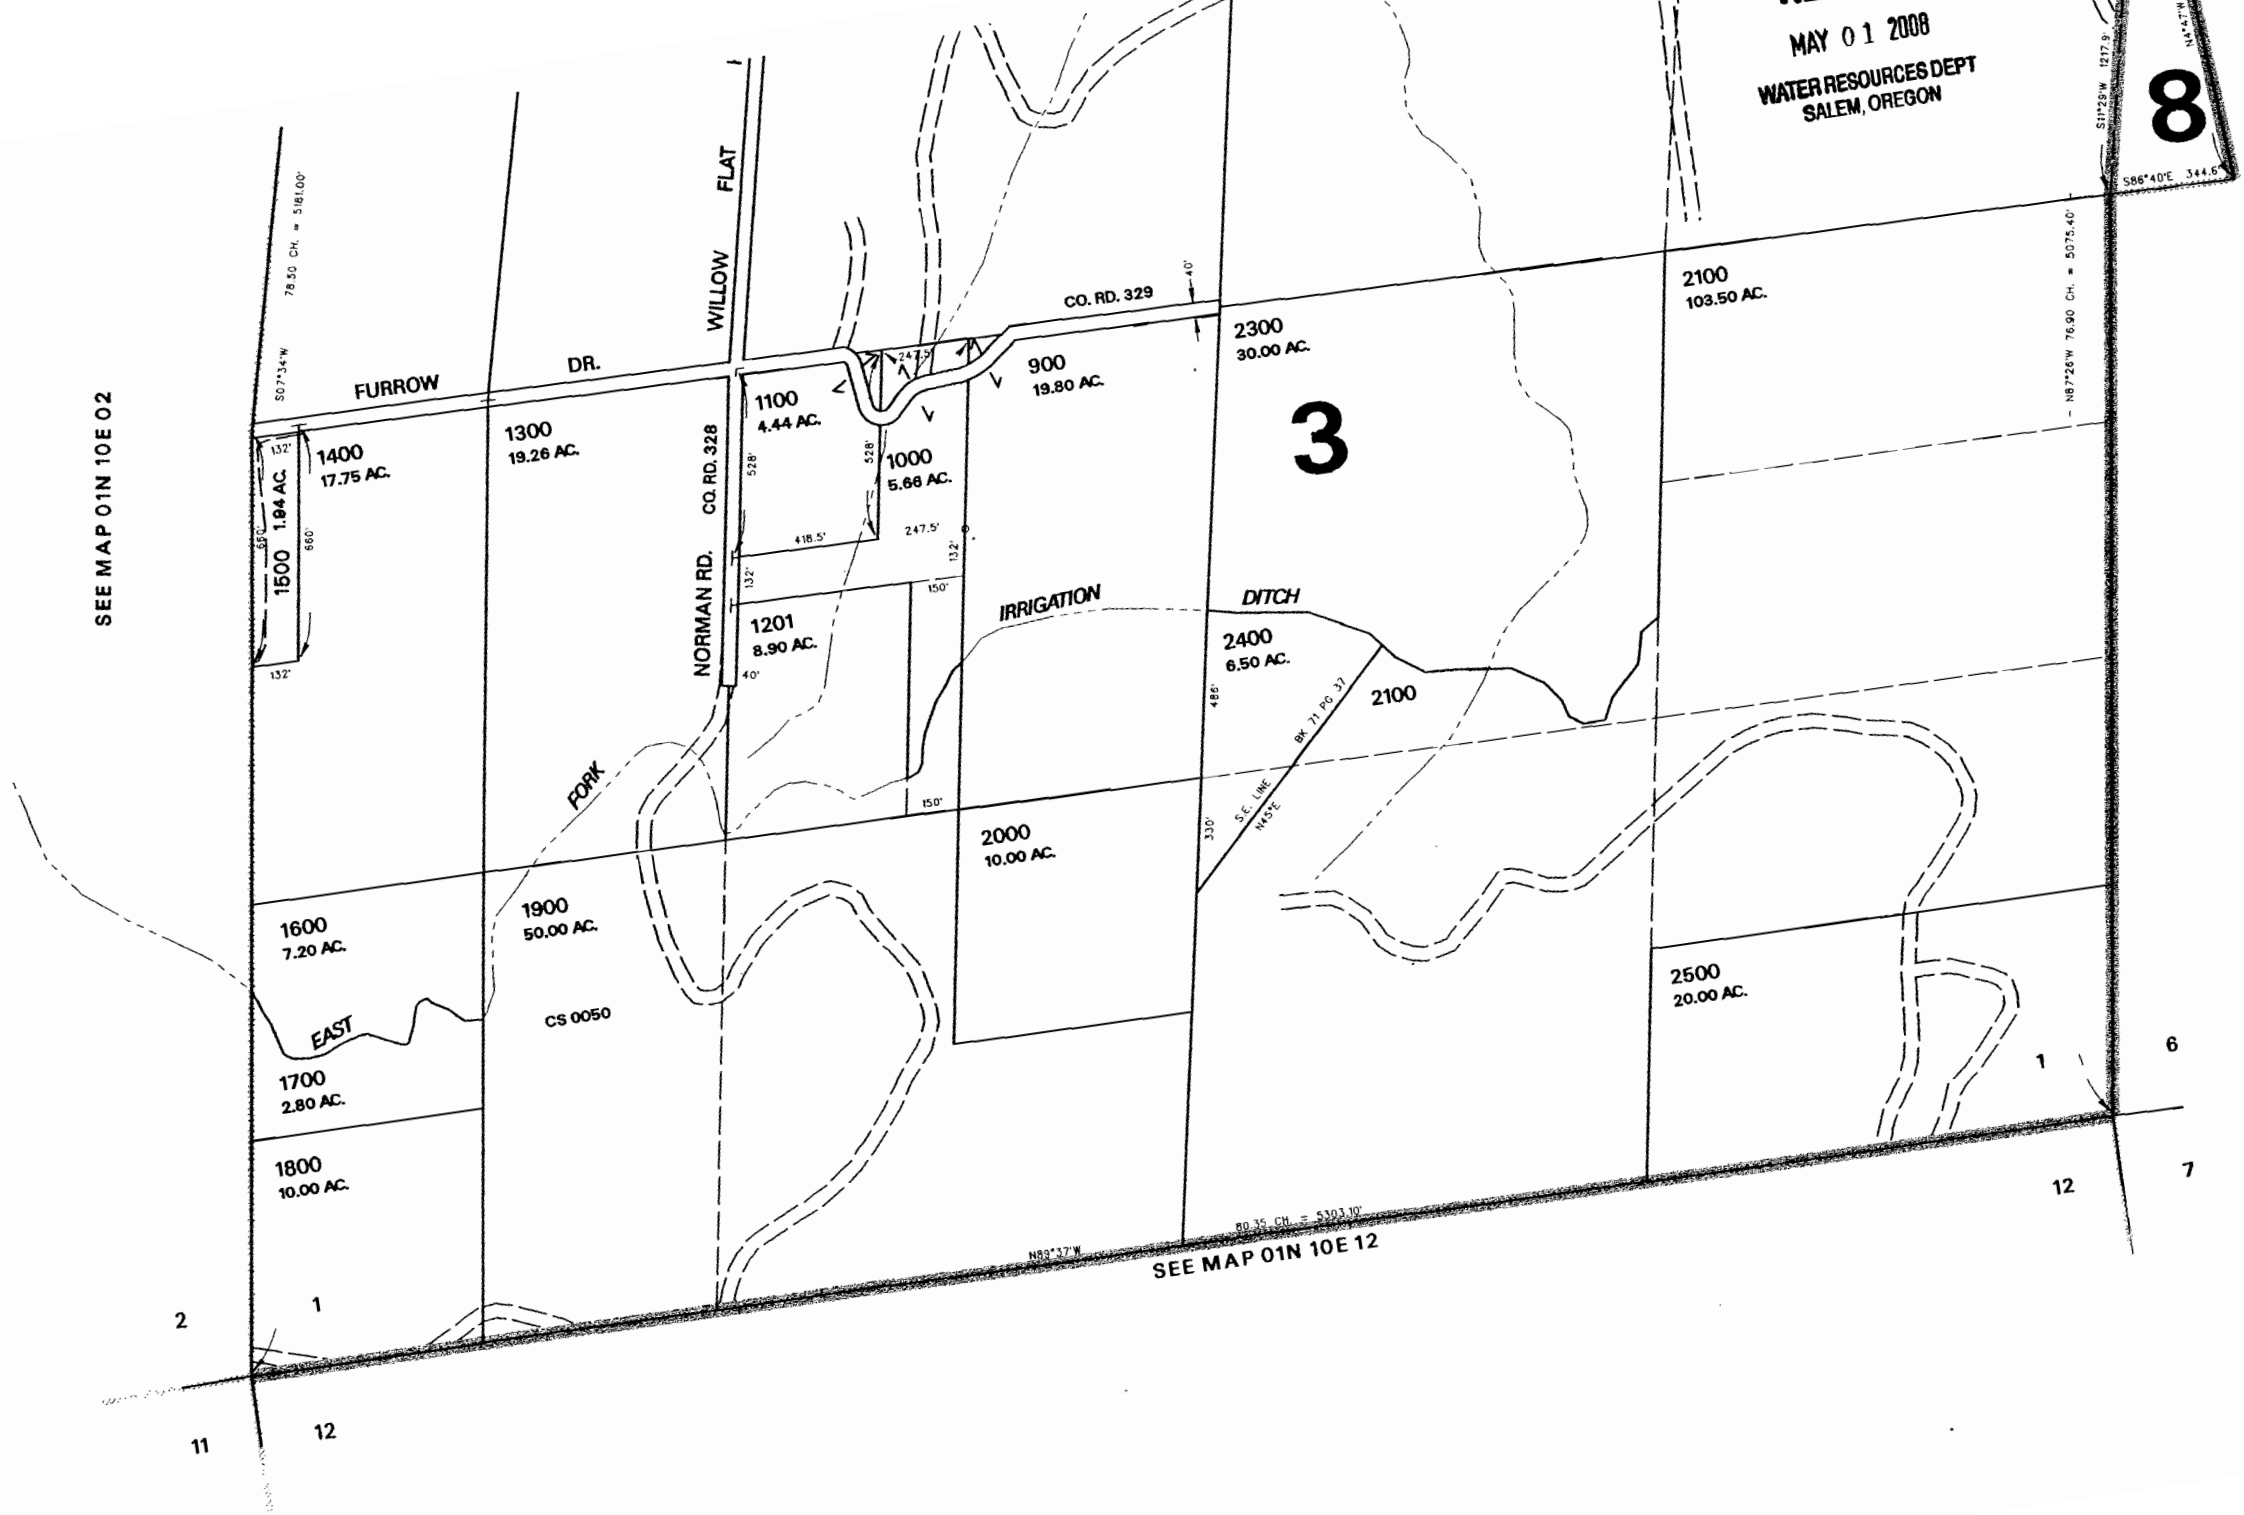

SEE MAP 01N 10E 12

2

1

11

12

12

6

7

3

1

THIS MAP WAS PREPARED FOR
ASSESSMENT PURPOSE ONLY

SECTION 02 T.01N. R.10E. W.M. HOOD RIVER COUNTY

1"=400'


RECEIVED

MAY 01 2008

WATER RESOURCES DEPT
SALEM, OREGON


01N 10E 02

CANCELLED NO
1402
1801
1802
1803
1805
1901

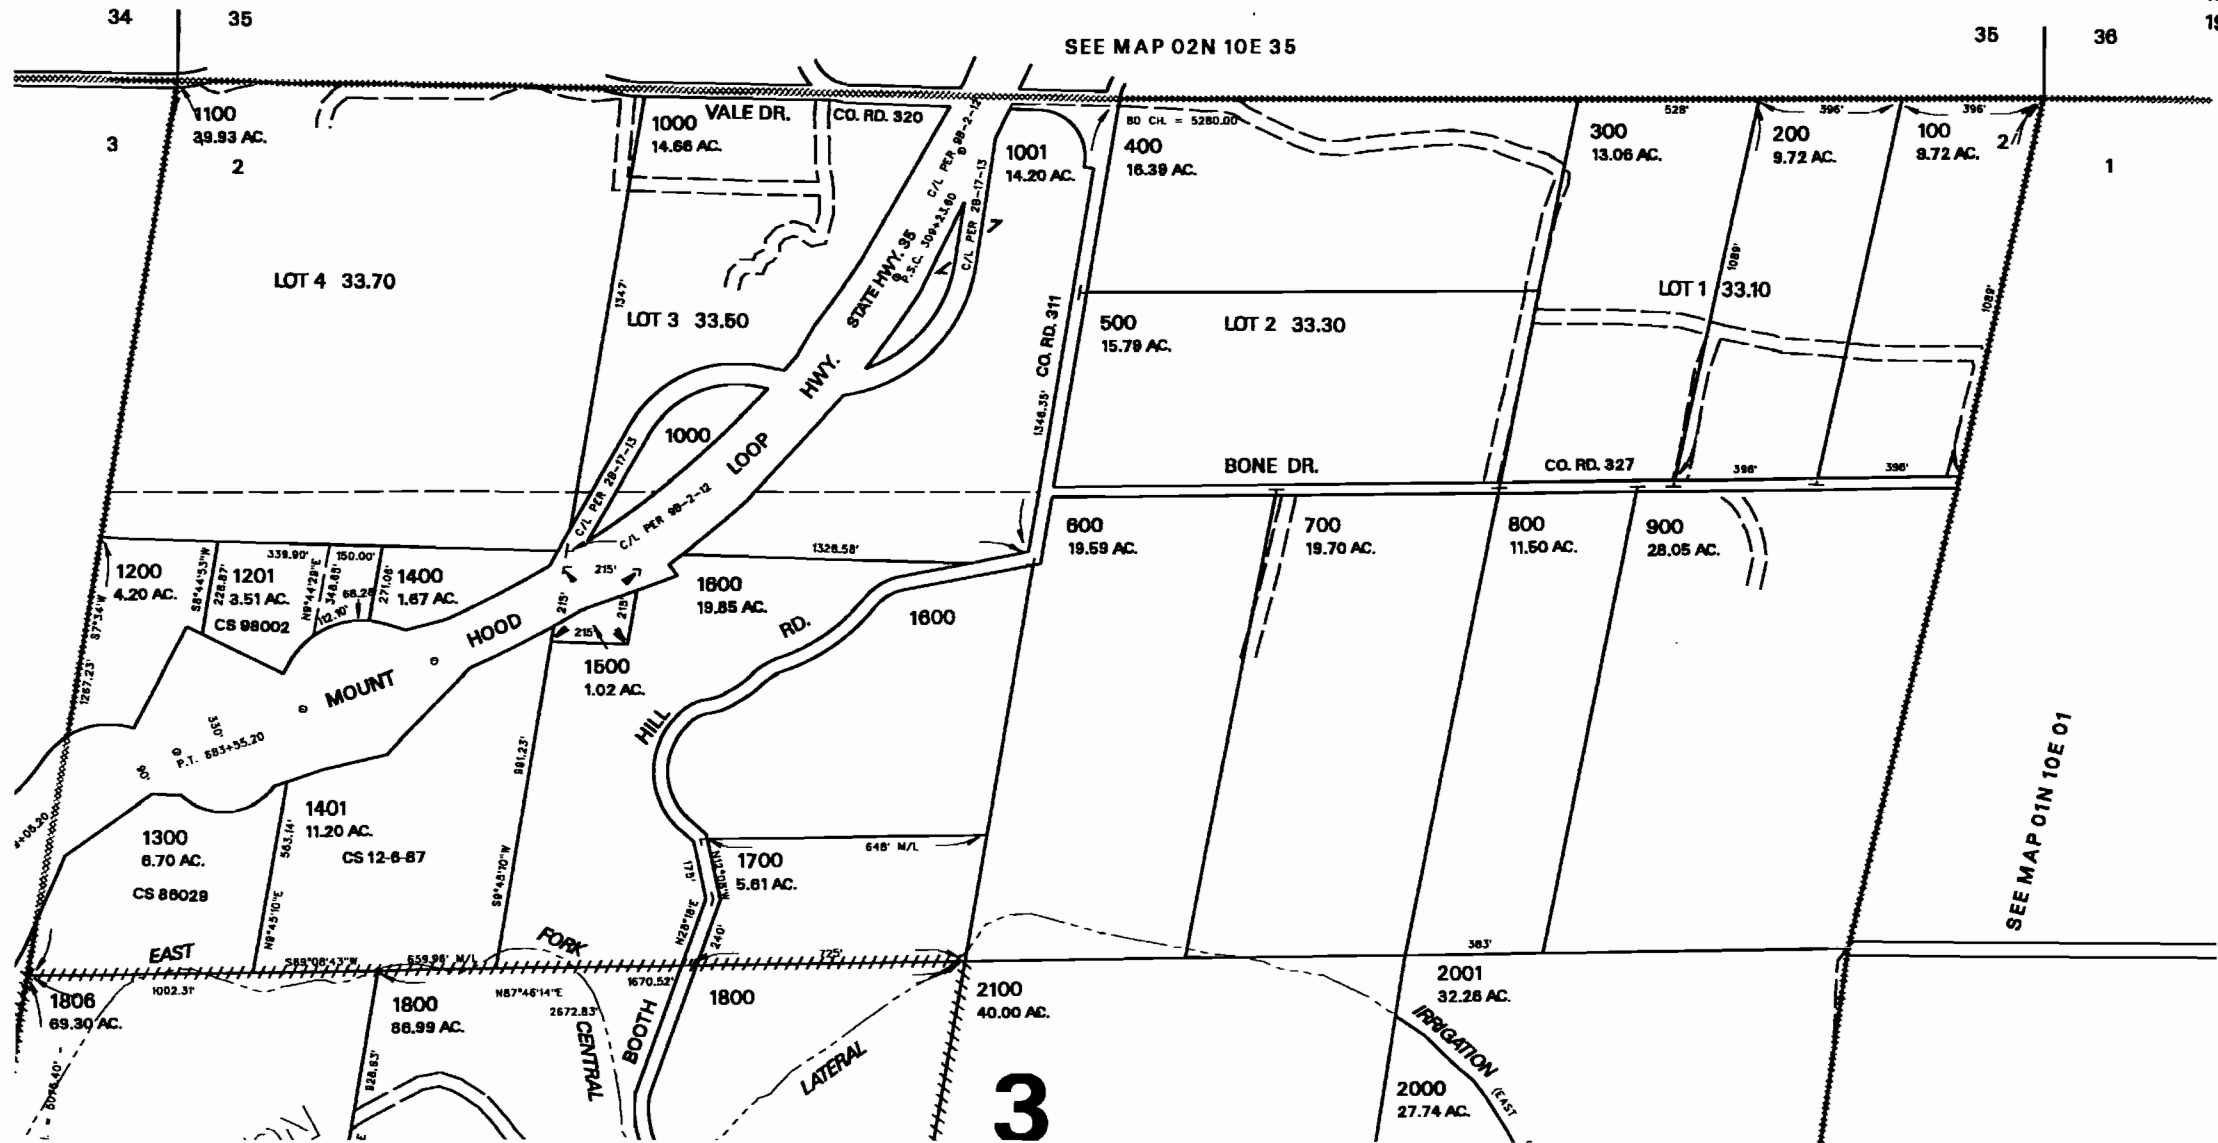

RECEIVED
 MAY 01 2008
 WATER RESOURCES DEPT
 SALEM, OREGON

SEE MAP 01N 10E 01

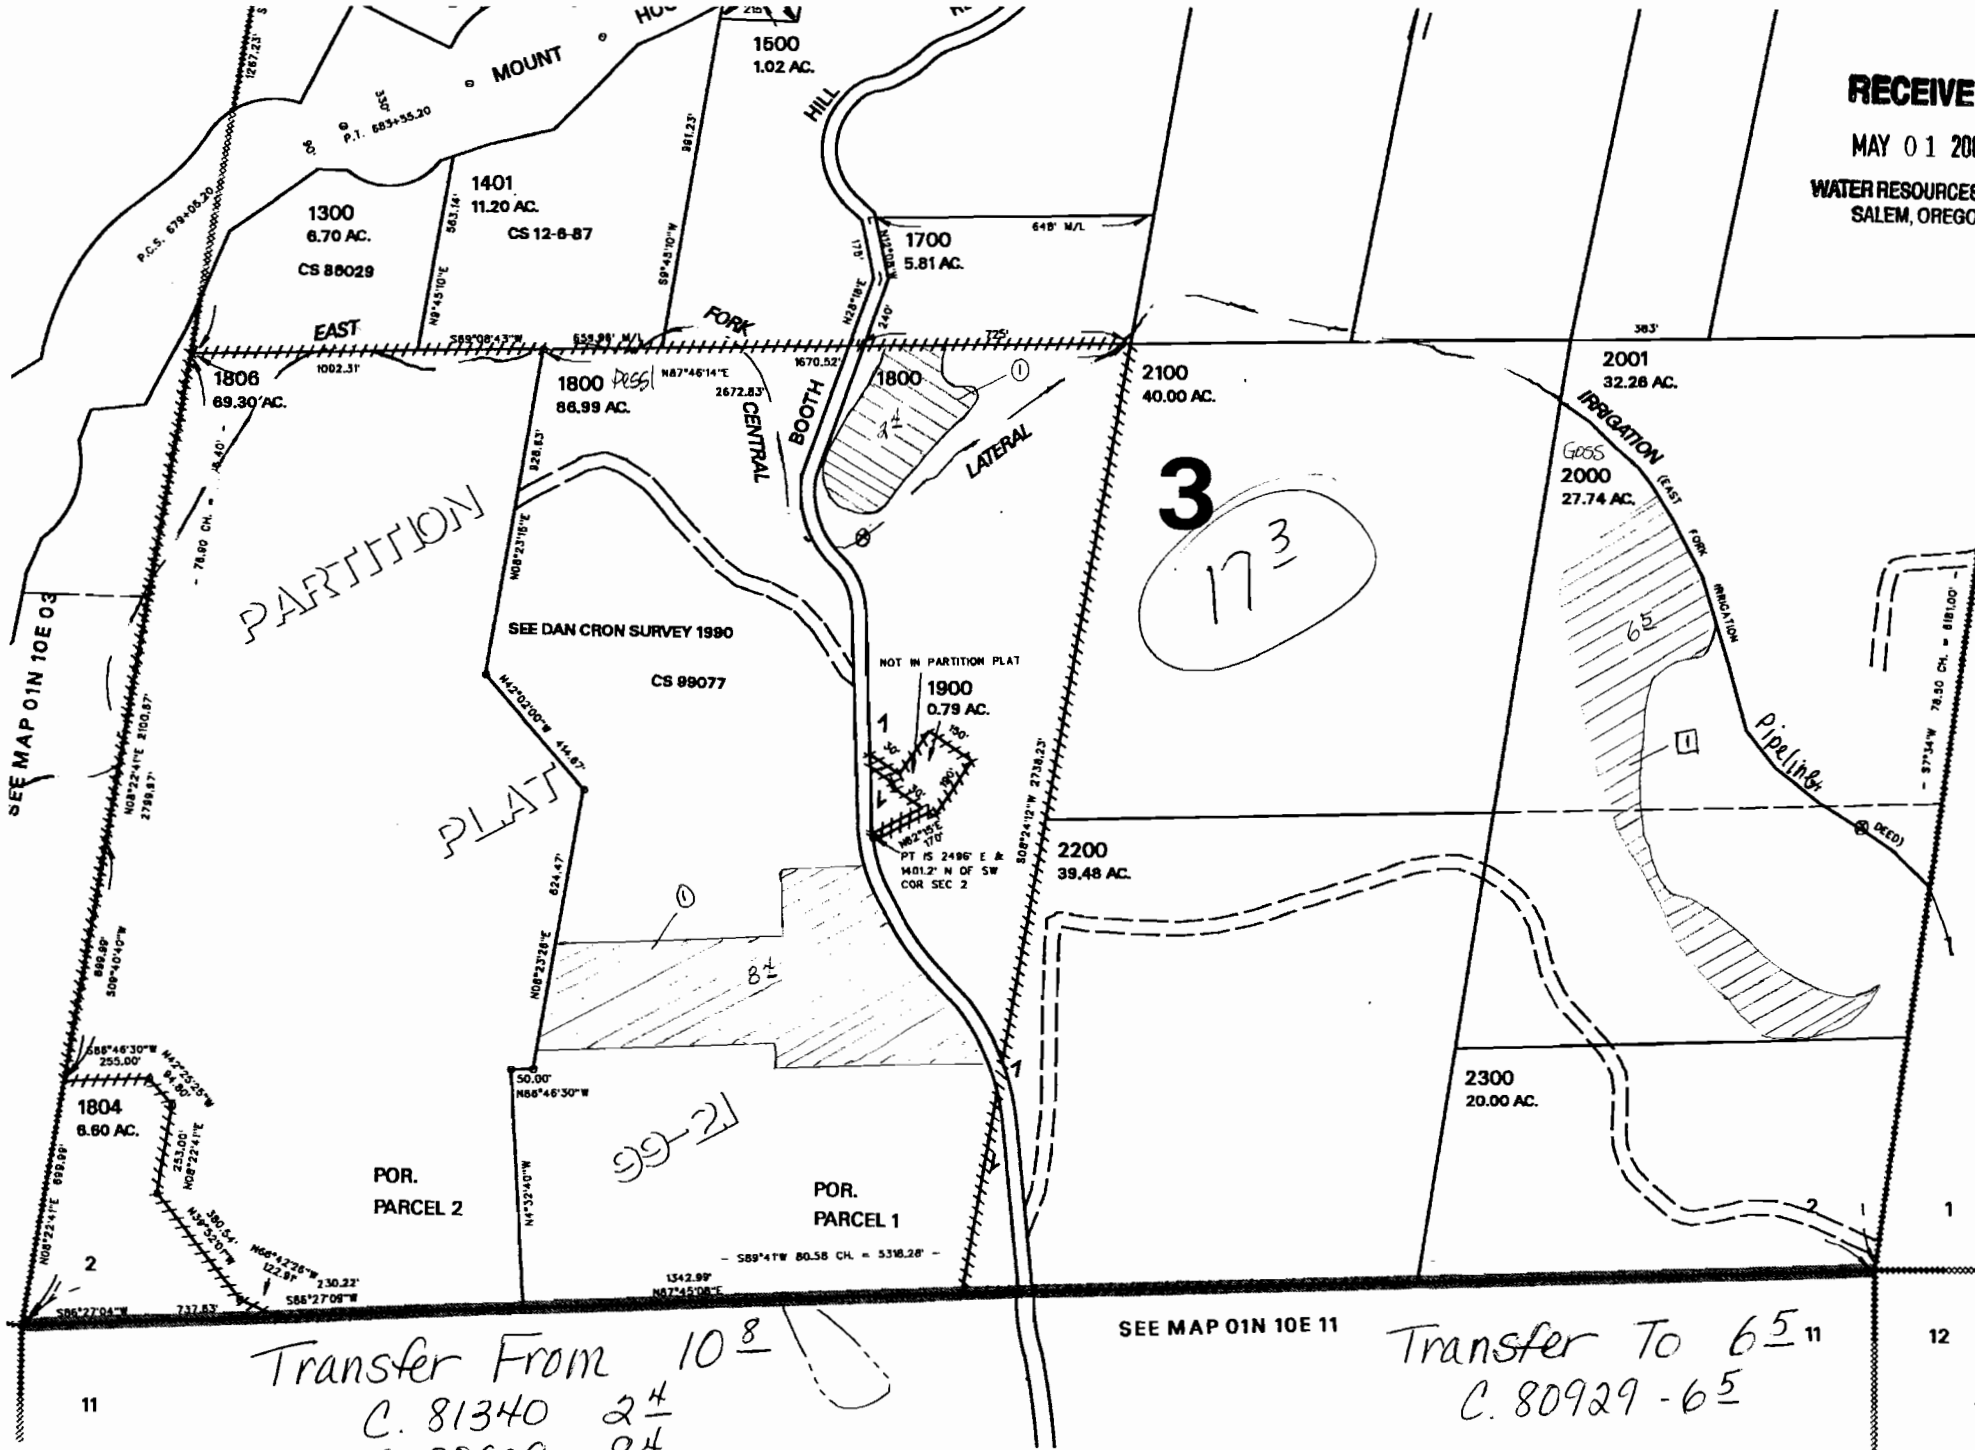


Transfer From 10⁸
 C. 81340 2⁴/₄
 C. 80929 8⁴/₄

SEE MAP 01N 10E 11 Transfer To 6⁵/₁₁
 C. 80929 - 6⁵/₁₁

12
 T 10616

01N