



2008 Instrument Lease

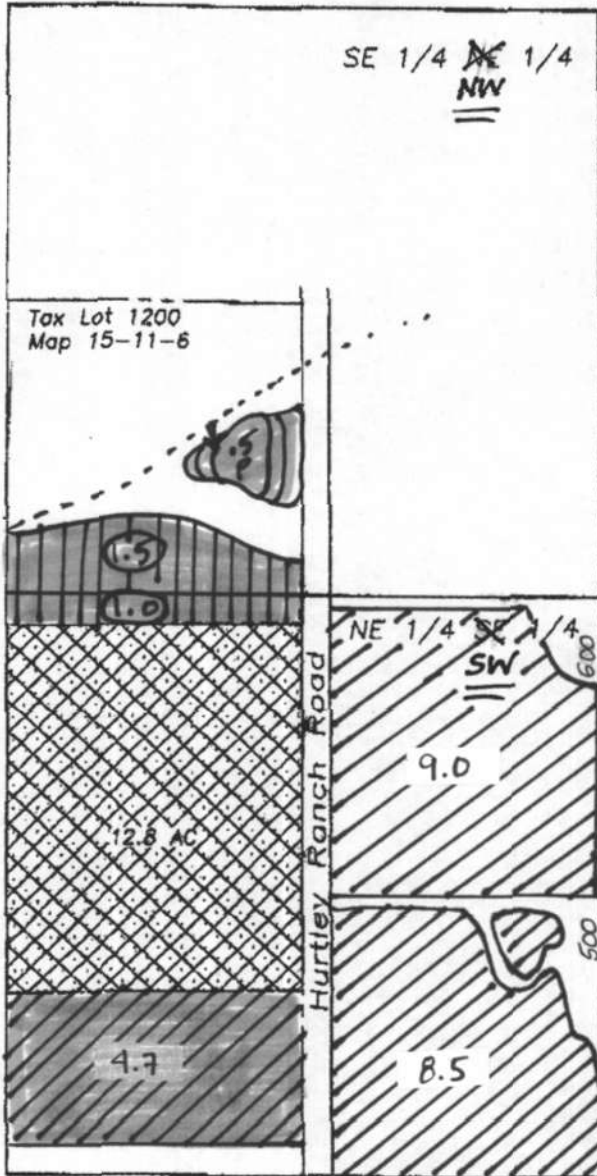




Three Sisters Irrigation District


In the name of Robert Taylor

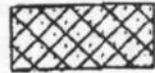Acres Leased instream

 Existing water right (Certificate 74135, priority date 2/31/1887)



-  Pending Transfer
-  1895 Water remaining
-  1887 Water remaining

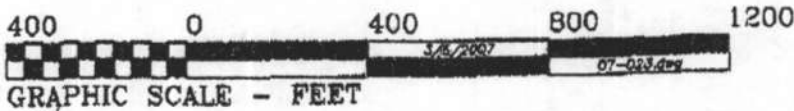

THIS MAP IS FOR THE PURPOSE OF IDENTIFYING THE LOCATION OF THE WATER RIGHT. IT IS NOT INTENDED TO PROVIDE LEGAL DIMENSIONS OR LOCATIONS OF PROPERTY OWNERSHIP LINES.