


TRANSFER APPLICATION
FOR: PAULETTO RANCH LLC
BY: DUANE W. KIRBY
T26S, R7W, W.M., SEC 3
CERTIFICATES 58676
TAX LOT 1800

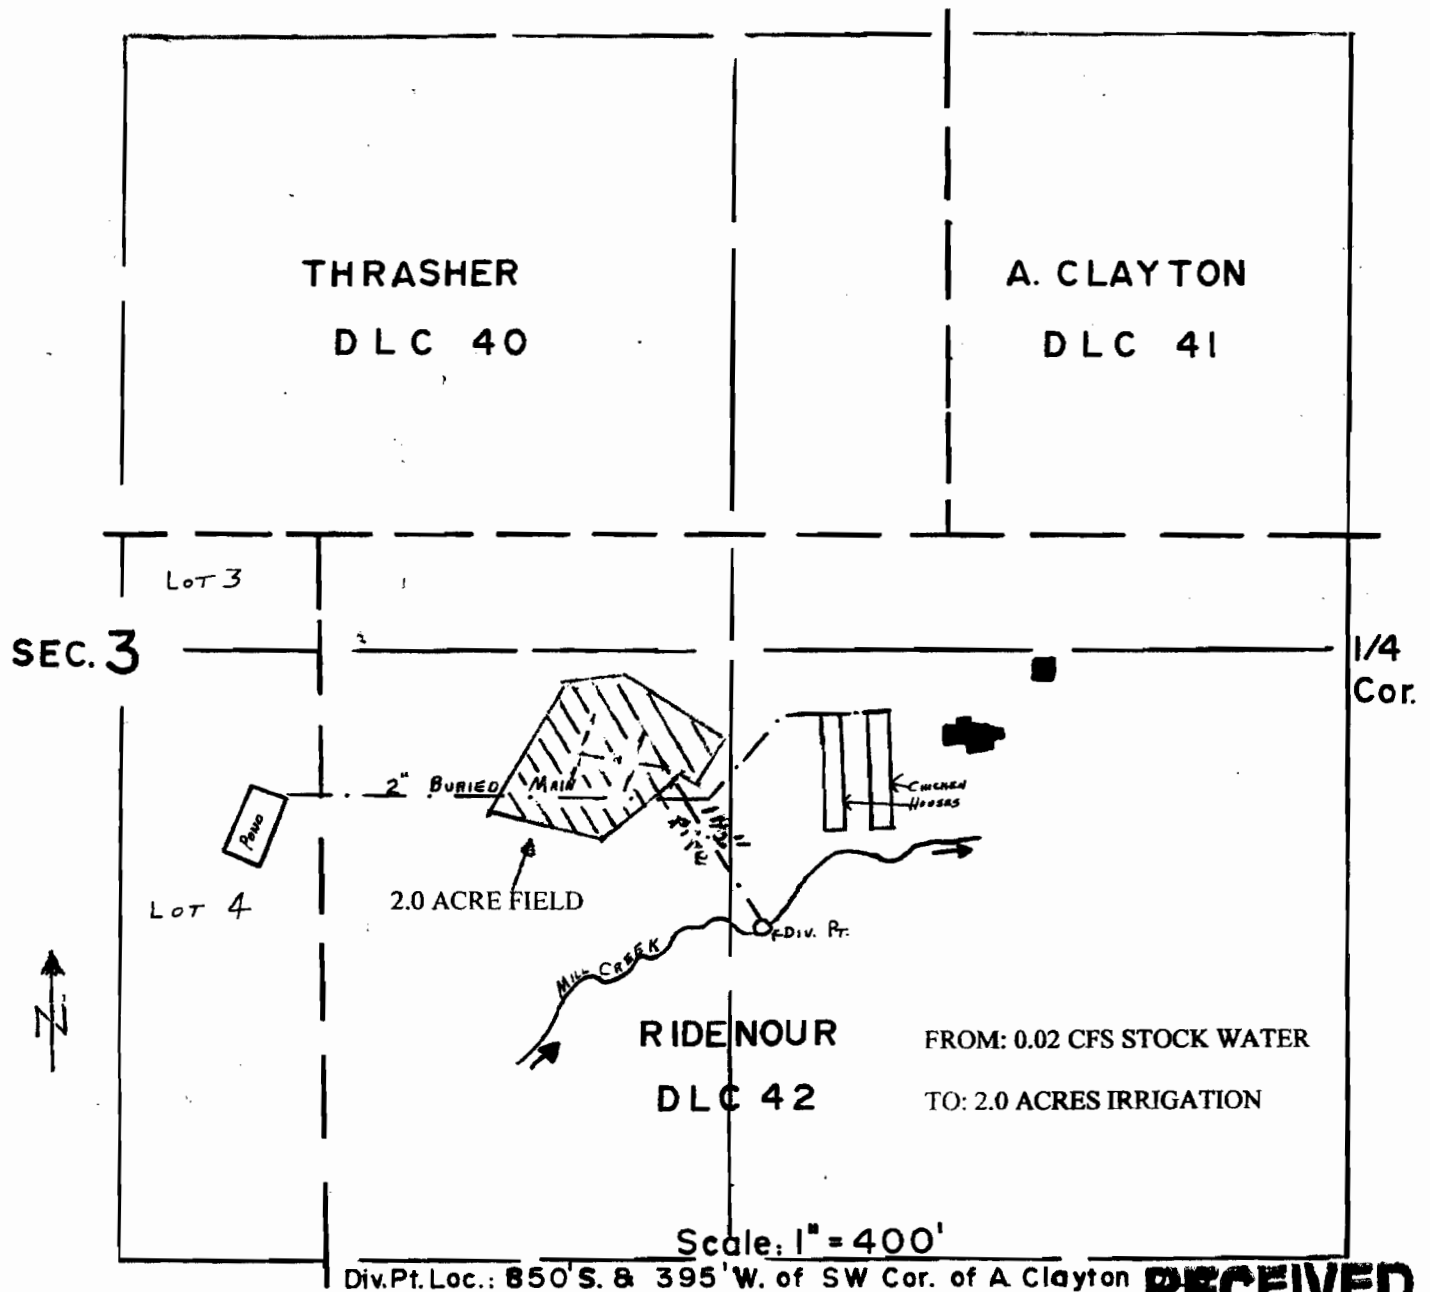

Div.Pt. Loc.: 850' S. & 395' W. of SW Cor. of A Clayton

RECEIVED

APR 21 2008

WATER RESOURCES DEPT
SALEM OREGON

RECEIVED


MAY 14 2008

WATER RESOURCES DEPT
SALEM OREGON

THE PURPOSE OF THIS MAP IS TO IDENTIFY THE LOCATION OF THE WATER RIGHT. IT IS NOT INTENDED TO PROVIDE INFORMATION RELATIVE TO THE LOCATION OF PROPERTY OWNERSHIP BOUNDARY LINES.



T. 26S., R. 7W., W. M.

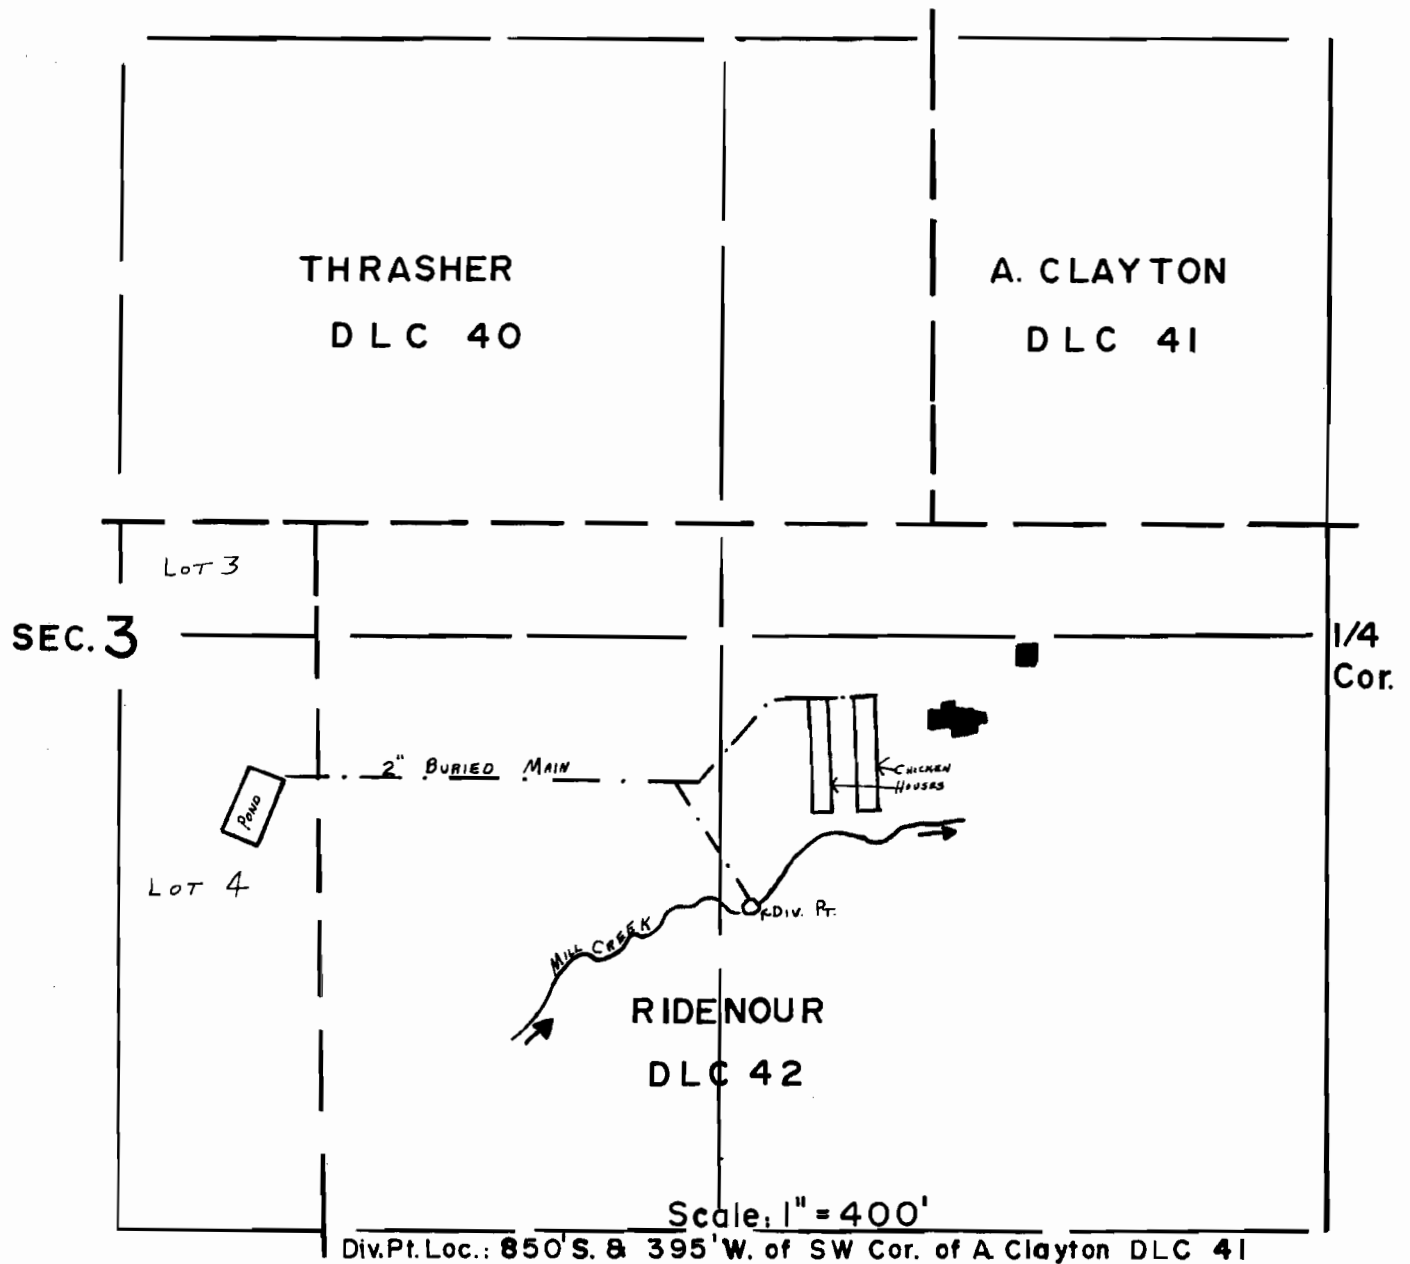

FINAL PROOF SURVEY
UNDER

R-55376 R-7148
Application No. 5537.7 Permit No. 4295.7....
IN NAME OF

JOE B. PAULETTO

Surveyed MAY.12... 1982, by ..L.....T.O.L.L.....

DOUGLAS COUNTY PHOTO
78-24-73

T.M.W.