

RECEIVED

MAY 23 2008

WATER RESOURCES DEPT.
SALEM, OREGON

T 10640.

T6N 33 34
T5N 4 3

Points of Appropriation

WELL 1: Authorized POA for Claim GR-1137. Hand-dug well located 875 feet S and 1310 feet E from W/4 Corner of Section 34. Well Log UMAT 5008. Draws water from gravel aquifer.

WELL 2: Proposed (additional) POA for Claim GR-1137. Drilled well located 925 feet S and 1205 feet E from W/4 Corner of Section 34. No available well log. Well diameter 10-inch and depth 200 feet (per Widner Electric). Draws water from gravel aquifer (per well log for Well 3).

WELL 3: Basalt well not involved in GR Claim Modification (Well Log UMAT 6053).

Place of Use

8.0 acres in NW/4 SW/4, S34, T6N, R35E, WM (TL 800)
No changes proposed for place of use.


T6N, R35E, S34, WM
Umatilla County



1 inch = 400 feet

The purpose of this map is to identify the location of a water right. It is not intended to provide information regarding the location of property ownership boundary lines.

FOUNTAINHEAD
1860 Blue Creek Road
Walla Walla, WA 99362
(509) 529-2646 phone

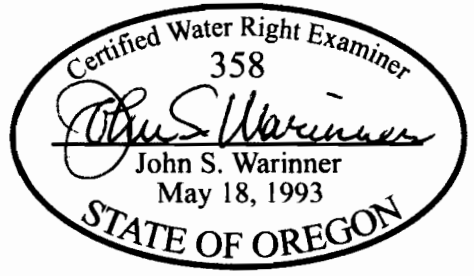

**GR CLAIM MODIFICATION
Claim GR-1137**

in the name of
PAUL ZEHR

Revised 14 MAY 2008