

# Swalley Irrigation District



Green dot: Swalley diversion, N. Canal Dam

Red dot: COID diversion, N. Canal Dam

- District Boundary
- Road Labels
- Township Range
- Sections
- Section Labels
- Quarters
- Quarter Labels
- Quarter Quarters
- Quarter Quarter Labels
- Taxlots
- Private Line
- Canal All
- Canal Open
- Canal Piped
- Rivers



Scale 1" = 400'  
Created: 6/10/2008


JUN 12 2008  
 WATER RESOURCES DEPT.  
 SALEM, OREGON

RECEIVED

DISCLAIMER: This map is intended for display purposes only and is not intended for any legal representations. There are no warranties, expressed or implied, that accompany this product.

TEMPORARY PIPE OVER  
GROUND X to Y = ABOUT 1700'

# Swalley Irrigation District

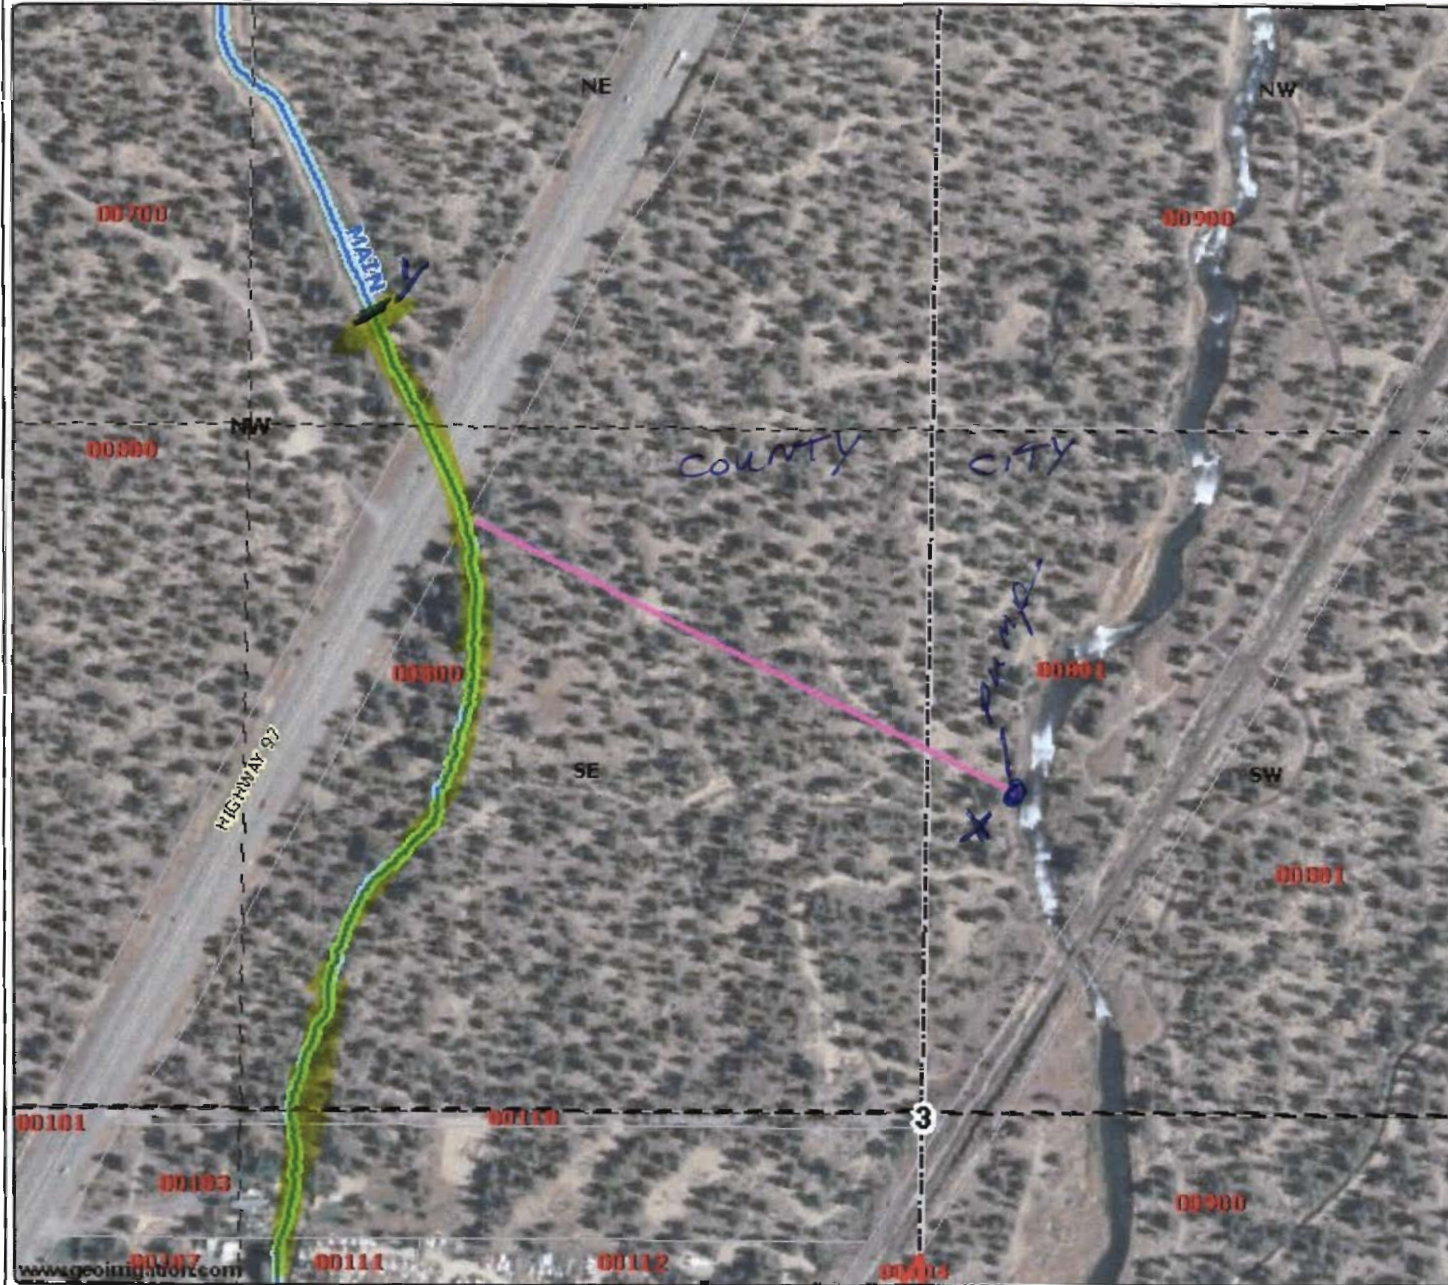

## Temporary Pumping Station

- District Boundary
- Road Labels
- Township Range
- Sections
- Section Labels
- Quarters
- Quarter Labels
- Quarter Quarters
- Quarter Quarter Labels
- Lot Labels
- Taxlots
- Private Line
- Canal All
- Canal Open
- Canal Piped
- Rivers

RECEIVED  
JUN 12 2008  
WATER RESOURCES DEPT.  
SALEM, OREGON



Scale 1" = 350'  
Created: 6/5/2008

DISCLAIMER: This map is intended for display purposes only and is not intended for any legal representations. There are no warranties, expressed or implied, that accompany this product.

YELLOW - PIPELINE  
 ↑ SWALLEY MAIN CANAL  
 BLUE - OPEN CANAL  
 ↑ COLD MAIN CANAL