




T. 15 S., R. 16 E. W.M.

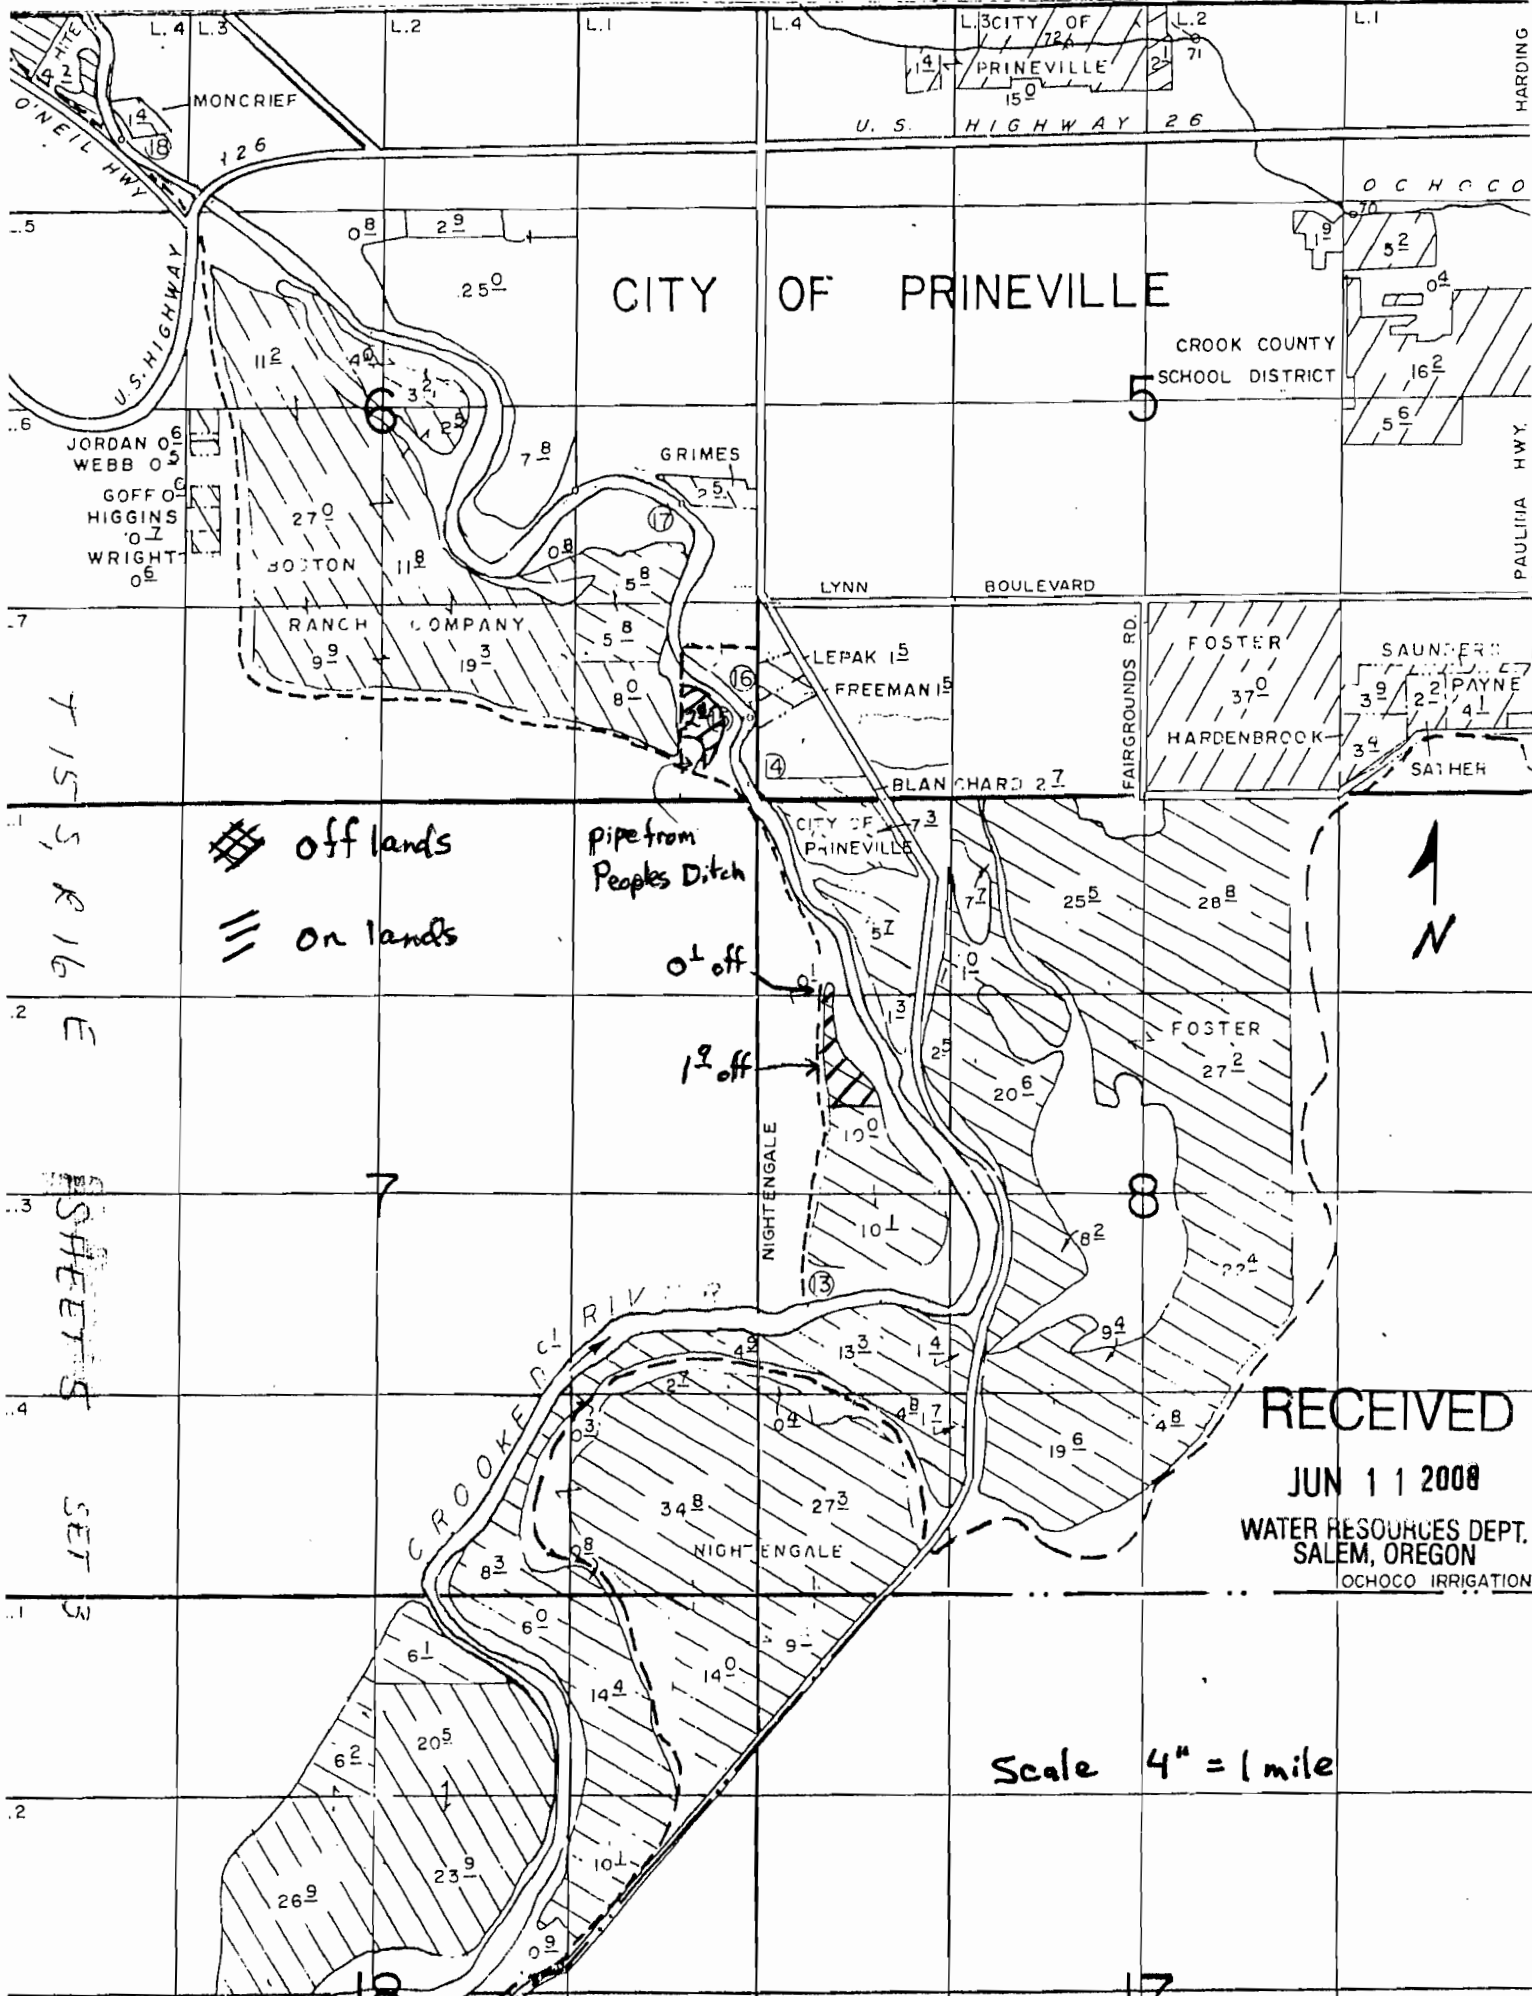

T 15 S, R 16 E SHEETS SET 3

 off lands
 on lands


Pipe from
 Peoples Ditch
 0' off
 1' off

RECEIVED
 JUN 11 2008
 WATER RESOURCES DEPT.
 SALEM, OREGON
 OCHOCO IRRIGATION

Scale 4" = 1 mile

15 - 1

NAIP_1_1_1n_5_0r013_2005-1 (September, 2005) Evidence of Use

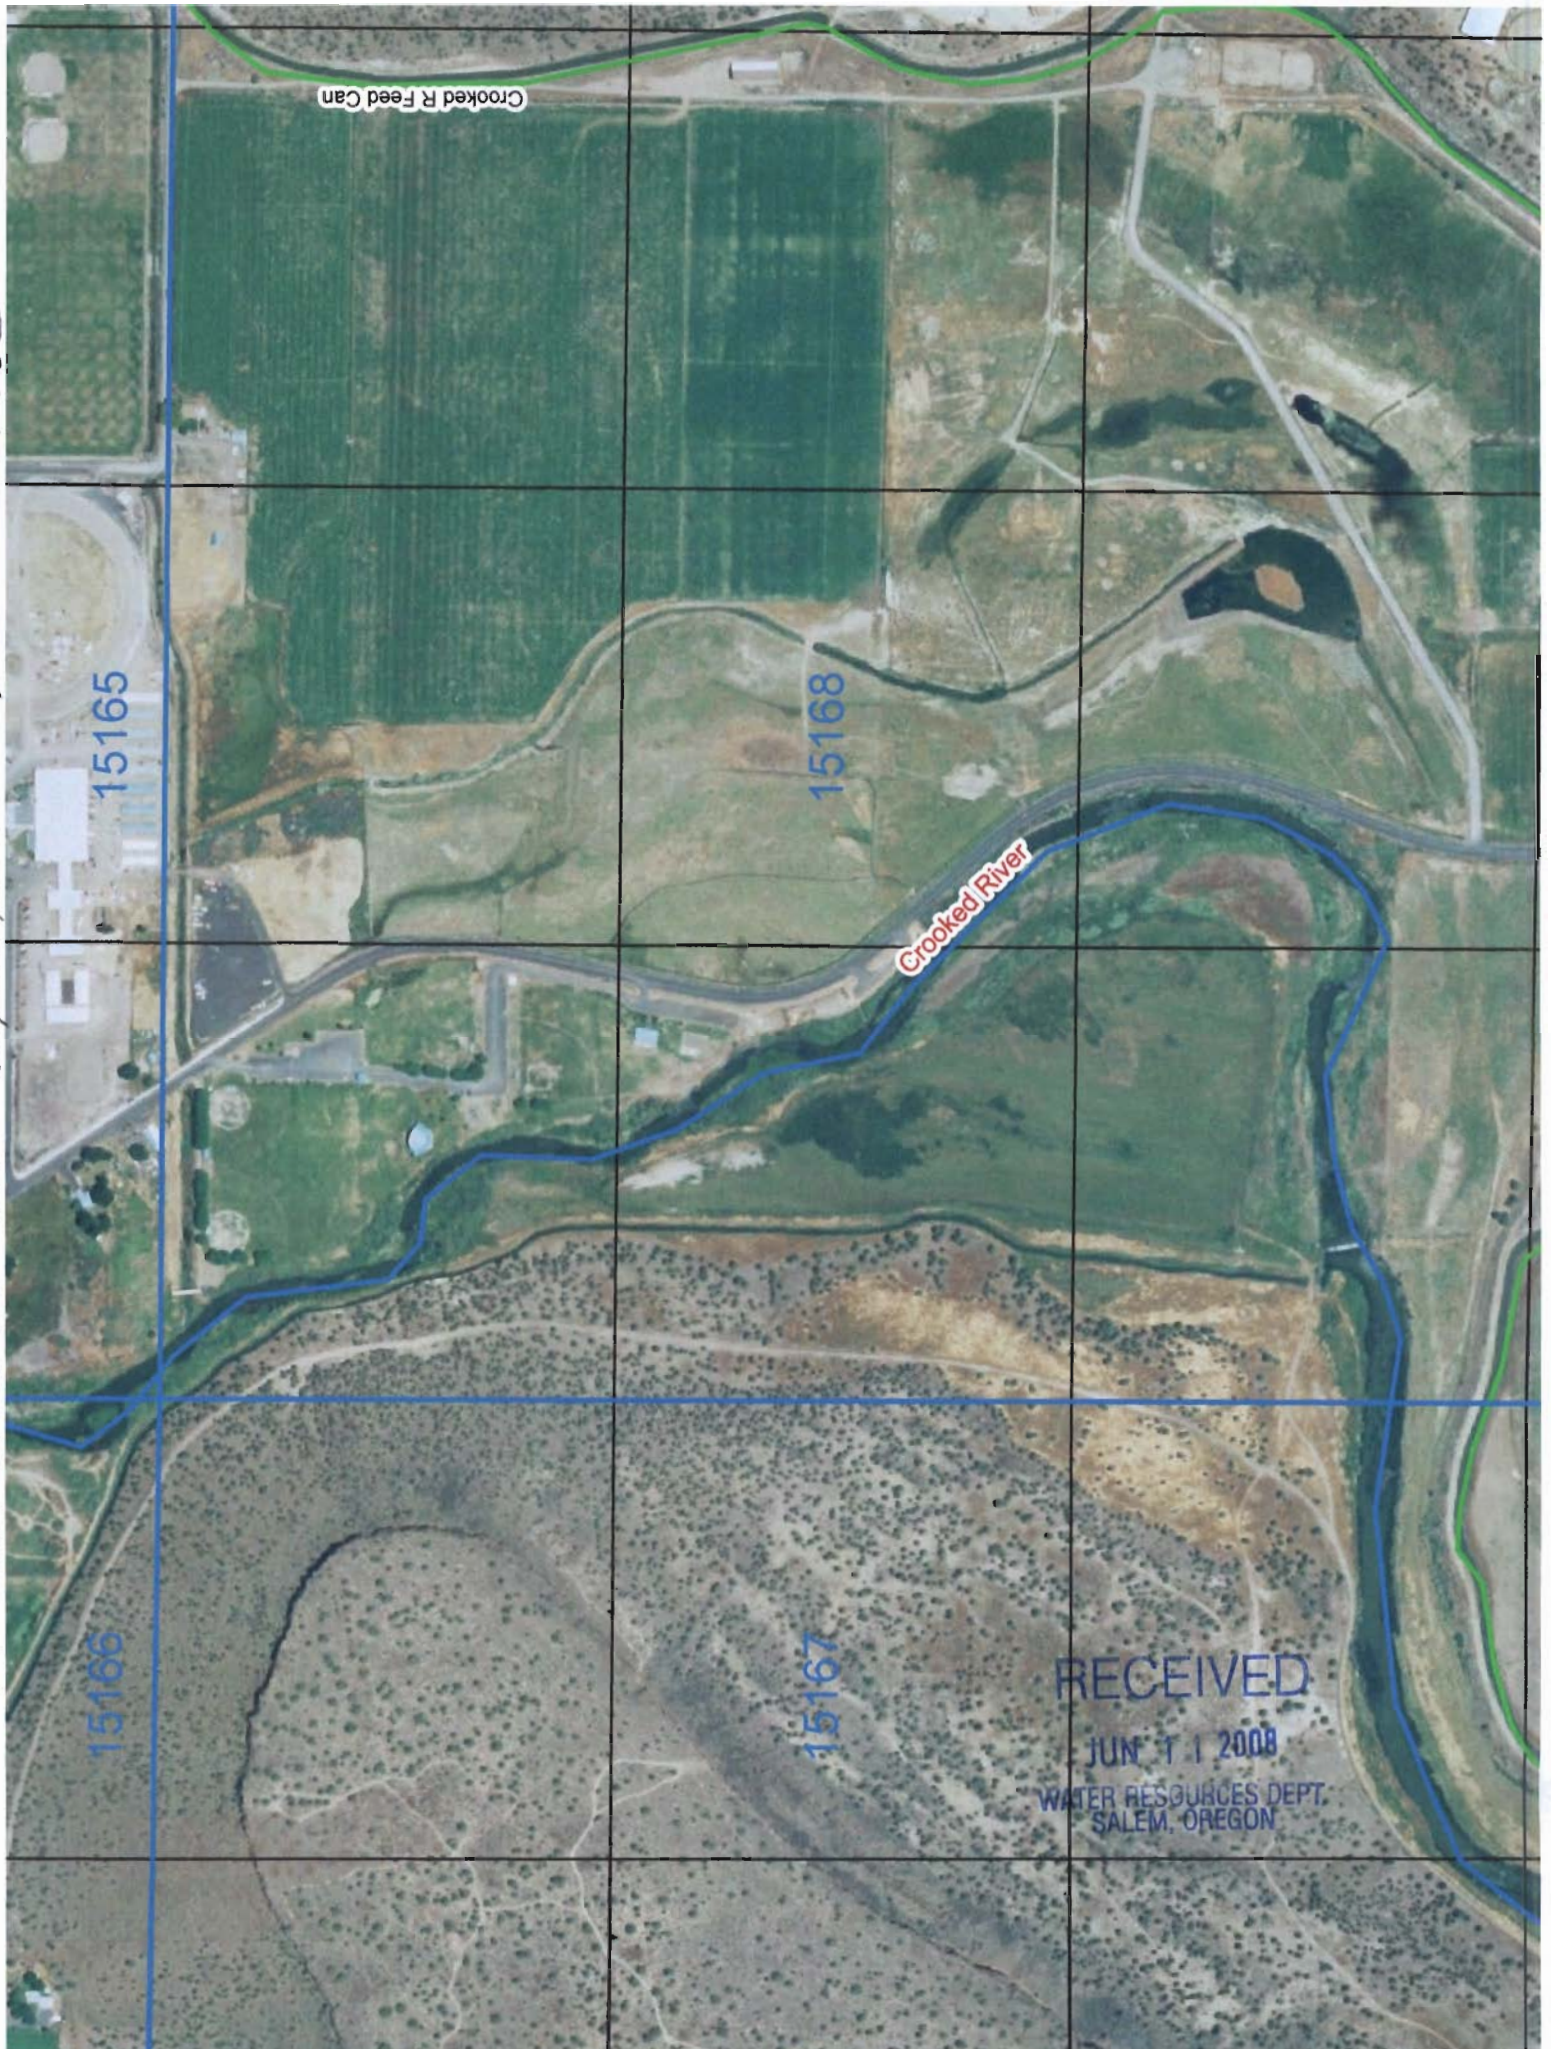

Crooked R Feed Can

15165

15168

Crooked River


15166

15167

RECEIVED

JUN 11 2008

WATER RESOURCES DEPT.
SALEM, OREGON

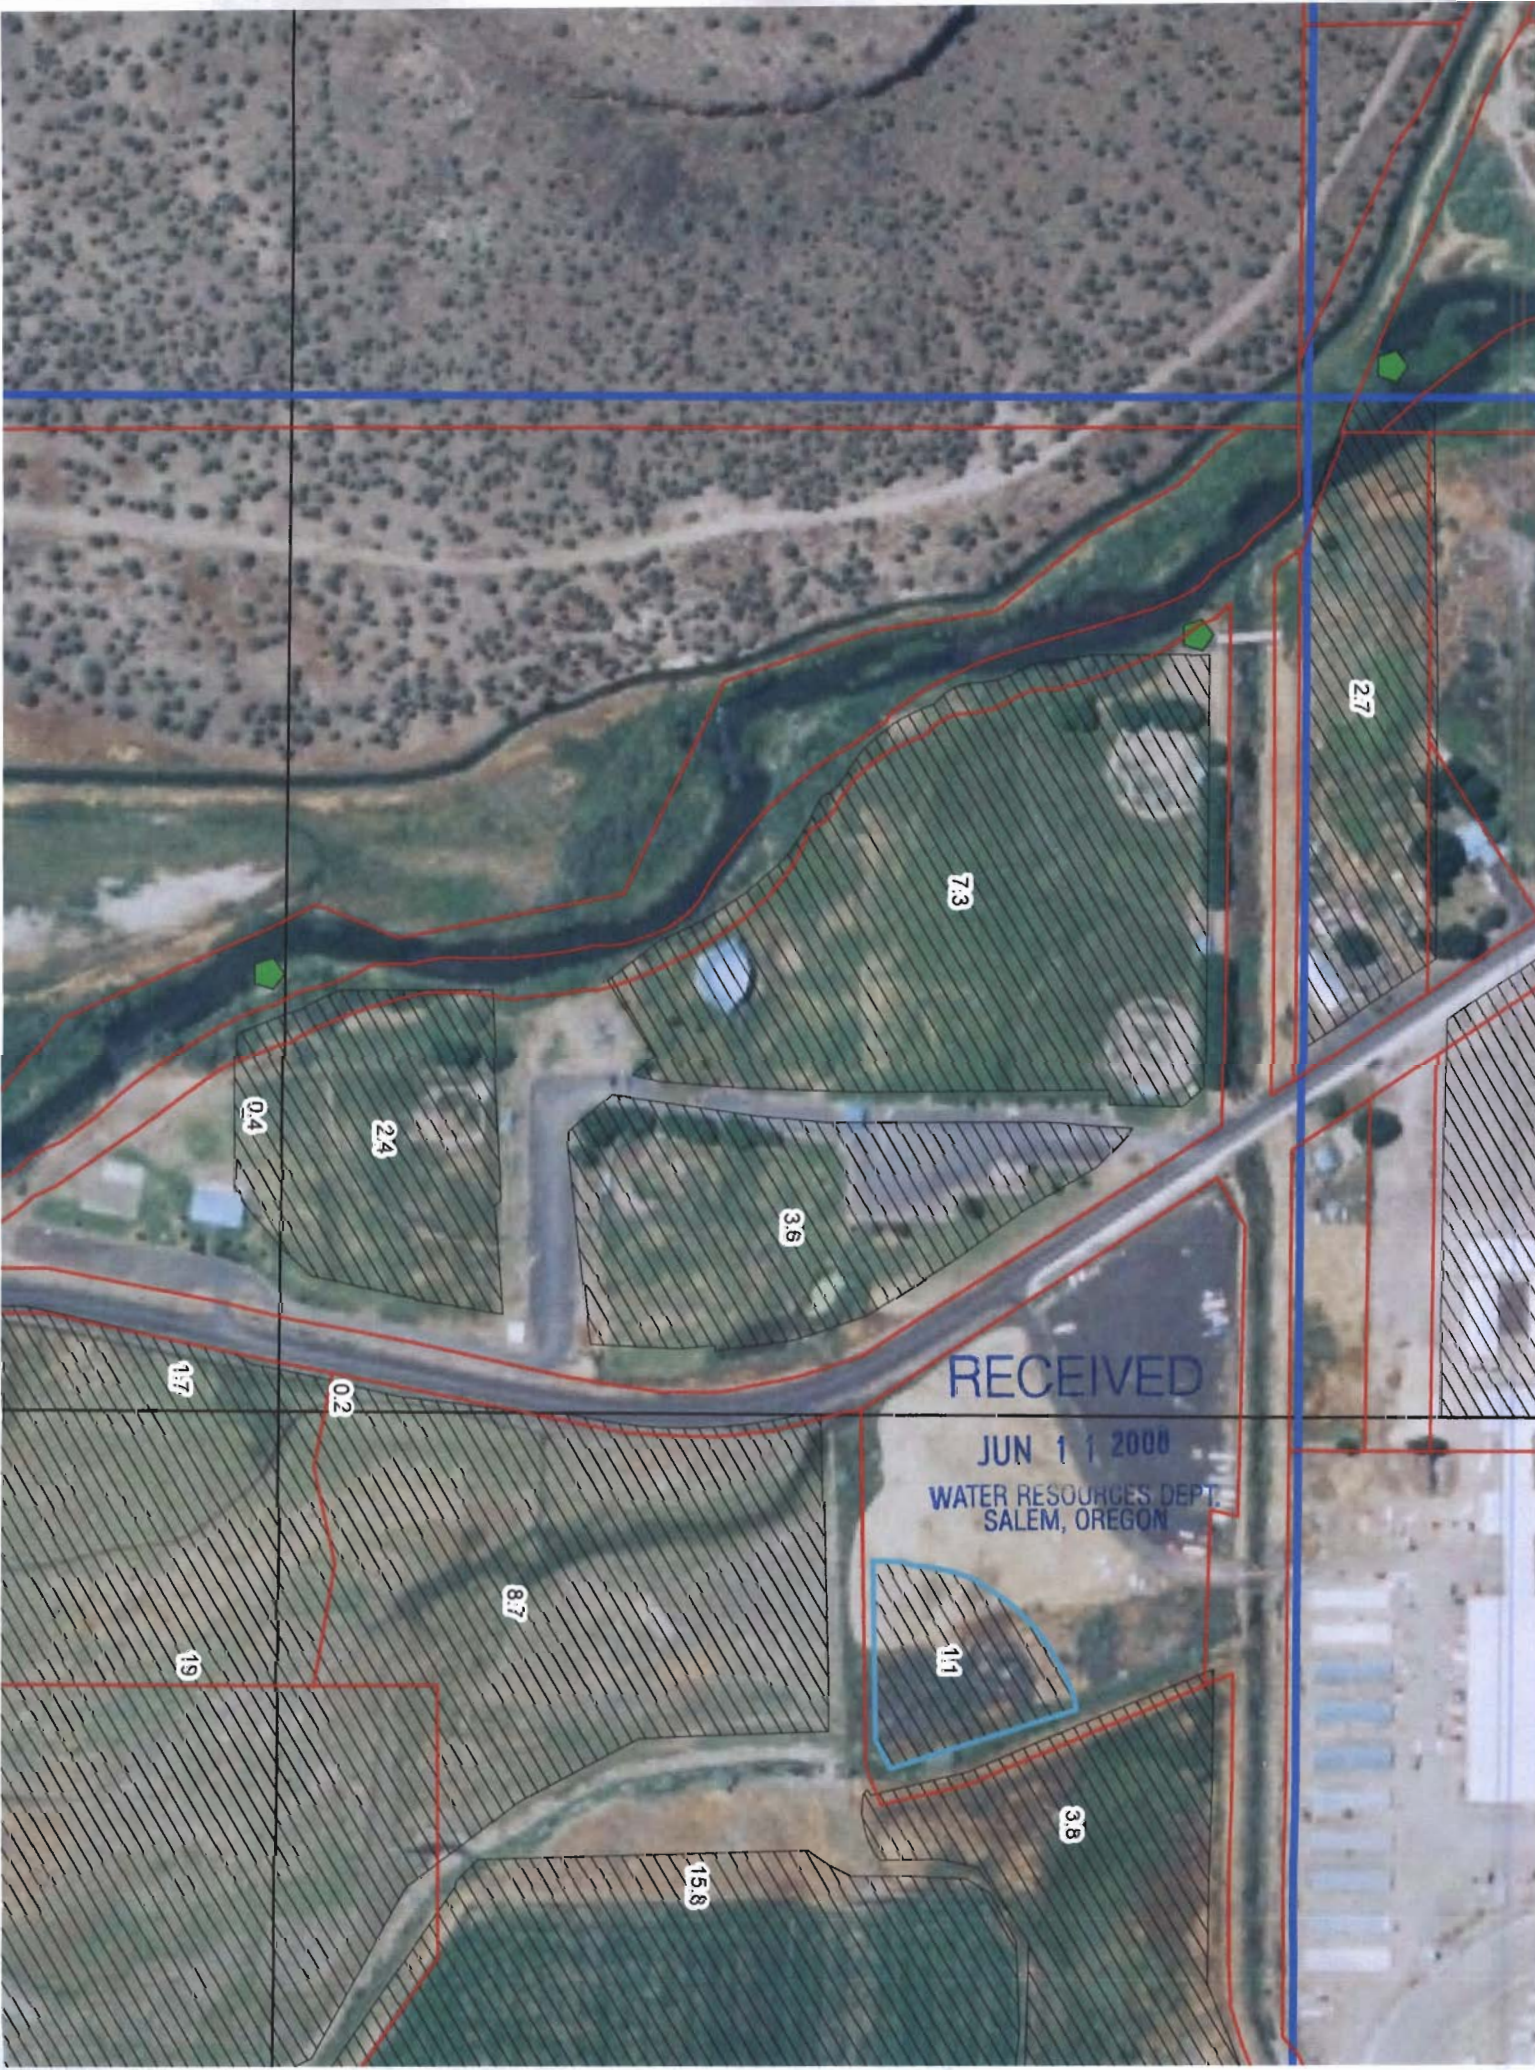

RECEIVED

JUN 11 2008

WATER RESOURCES DEPT.
SALEM, OREGON

04

24

3.6

7.3

27

17

02

8.7

19

1.1

3.8

15.8