

STATE ENGINEER  
Salem, Oregon

2934  
2934  
MARION Well Record

STATE WELL NO. 5/3W - 34J  
COUNTY MARION  
APPLICATION NO. GR-2224

OWNER: Henry White Jr.


MAILING ADDRESS: Rt. 1, Box 95

LOCATION OF WELL: Owner's No.

CITY AND STATE: Gervais, Oregon

NE 1/4 SE 1/4 Sec. 34 T. 5 N. S. R. 3 W., W.M.

Bearing and distance from section or subdivision corner 100' W. and 470' S.

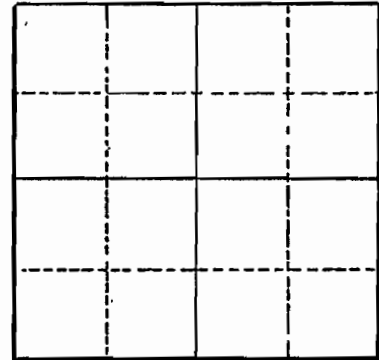

Section

Altitude at well

TYPE OF WELL: Drilled Date Constructed Prior 1955

Depth drilled 38 Depth cased 38

CASING RECORD:

10-Inch

FINISH:

Perforations from 18 to 38

AQUIFERS:

Sand and gravel

WATER LEVEL:

18-Feet

PUMPING EQUIPMENT: Type Fairbanks Morse Centrifugal H.P. 30  
Capacity 800 G.P.M.

WELL TESTS:

Drawdown 6 ft. after hours Pumping 6 G.P.M.

Drawdown ft. after hours G.P.M.

USE OF WATER Irrigation Temp. °F. 19

SOURCE OF INFORMATION GR-2130

DRILLER or DIGGER Fred Wymore, Willamette Well Drillers, Salem, Oregon

ADDITIONAL DATA:

Log Water Level Measurements Chemical Analysis Aquifer Test

REMARKS:

Sand and gravel

RECEIVED

JUN 18 2008

WATER RESOURCES DEPT  
SALEM, OREGON

# MARI 61643

STATE OF OREGON  
**GEOTECHNICAL HOLE REPORT**  
 (as required by OAR 690-240-0035)

**(1) OWNER/PROJECT** Hole Number B-1  
 First Name Byron & Eva Last Name Lafollette  
 Company \_\_\_\_\_  
 Address 11382 Wheatland Rd NE  
 City Gervais State OR Zip 97026

**(2) TYPE OF WORK**  New  Deepening  Abandonment  
 Alteration (repair/recondition)

**(3) CONSTRUCTION**  
 Rotary Air  Hand Auger  Hollow stem auger  
 Rotary Mud  Cable  Push Probe  
 Other \_\_\_\_\_

**(4) TYPE OF HOLE:**  
 Uncased Temporary  Cased Permanent  
 Uncased Permanent  Slope Stability  
 Other  
 Other: Cased Temporary

**(5) USE OF HOLE**  
 Determine thickness of gravel deposit

**(6) BORE HOLE CONSTRUCTION** Special Standard  Attach copy

Depth of Completed Hole 0.00 ft.

BORE HOLE			SEAL			sacks/	
Dia	From	To	Material	From	To	Amt	lbs
7.5	0	100					S
							S

Backfill placed from \_\_\_\_\_ ft. to \_\_\_\_\_ ft. Material \_\_\_\_\_  
 Filter pack from \_\_\_\_\_ ft. to \_\_\_\_\_ ft. Material \_\_\_\_\_ Size \_\_\_\_\_

**(7) CASING/SCREEN**

Casing	Screen	Dia	+	From	To	Gauge	Stl	Plstc	Wld	Thrd
<input type="checkbox"/>	<input type="checkbox"/>						<input type="checkbox"/>	<input type="checkbox"/>	<input type="checkbox"/>	<input type="checkbox"/>
**(8) WELL TESTS**  
 Pump  Bailer  Air  Flowing Artesian

Yield gal/min	Drawdown	Drill stem/Pump depth	Duration(hr)

Temperature \_\_\_\_\_ °F Lab analysis  Yes By \_\_\_\_\_  
 Supervising Geologist/Engineer \_\_\_\_\_  
 Water quality concerns?  Yes (describe below)  
 From \_\_\_\_\_ To \_\_\_\_\_ Description \_\_\_\_\_

**(9) LOCATION OF HOLE (legal description)**  
 County MARION Twp 5.00 S N/S Range 3.00 W E/W WM  
 Sec 35 SW 1/4 of the SW 1/4 Tax Lot 800  
 Tax Map Number \_\_\_\_\_ Lot \_\_\_\_\_  
 Lat \_\_\_\_\_ " or \_\_\_\_\_ DMS or DD  
 Long \_\_\_\_\_ " or \_\_\_\_\_ DMS or DD  
 Street address of hole  Nearest address  
11382 Wheatland Rd NE Gervais, OR 97026

**(10) STATIC WATER LEVEL**

Existing Well / Predeepening	Date	SWL(psi)	+ SWL(ft)
Completed Well	04-15-2008		19

Flowing Artesian?   
 Depth water was first found \_\_\_\_\_

SWL Date	From	To	Est Flow	SWL(psi)	+ SWL(ft)

**(11) SUBSURFACE LOG** Ground Elevation \_\_\_\_\_

Material	From	To
Clay Brown sticky	0	15
Sandy Silty Clay Brown soft	15	25
Sand-Silty Gravels small	25	30
Sands & Gravels med	30	40
Sand coarse w/ Gravels med	40	65
Clay Grey sticky	65	100

Date Started 04-15-2008 Completed 04-15-2008

**(12) ABANDONMENT LOG:**

Material	From	To	Amt	sacks/
Bentonite	0	20	15	S
Cement	20	100	12	S

Date Started 04-15-2008 Completed 04-16-2008

**Professional Certification** (to be signed by an Oregon licensed water or monitoring well constructor, or Oregon registered geologist or civil engineer).

I accept responsibility for the construction, deepening, alteration, or abandonment work performed during the construction dates reported above. All work performed during this time is in compliance with Oregon geotechnical hole construction standards. This report is true to the best of my knowledge and belief.

License/Registration Number \_\_\_\_\_ Date \_\_\_\_\_  
 First Name \_\_\_\_\_ Last Name \_\_\_\_\_  
 Affiliation \_\_\_\_\_

**RECEIVED**  
 ORIGINAL - WATER RESOURCES DEPARTMENT  
 THIS REPORT MUST BE SUBMITTED TO THE WATER RESOURCES DEPARTMENT WITHIN 30 DAYS OF COMPLETION OF WORK  
**WATER RESOURCES DEPT**  
**SALEM, OREGON**  
**JUN 18 2008**  
 WATER RESOURCES DEPT  
 SALEM, OREGON