

TRANSFER APPLICATION MAP
 FOR: JEFF C AND VIBEKE LAUGHLIN
 BY: DUANE W. KIRBY
 T28S, R5W., W.M. SECTION 22 & 23
 CERTIFICATE NO 82631
 TAX LOT 401

COUNTY RD NO 16


RECEIVED

JUN 12 2008

WATER RESOURCES DEPT.
 SALEM, OREGON



1" = 1320'

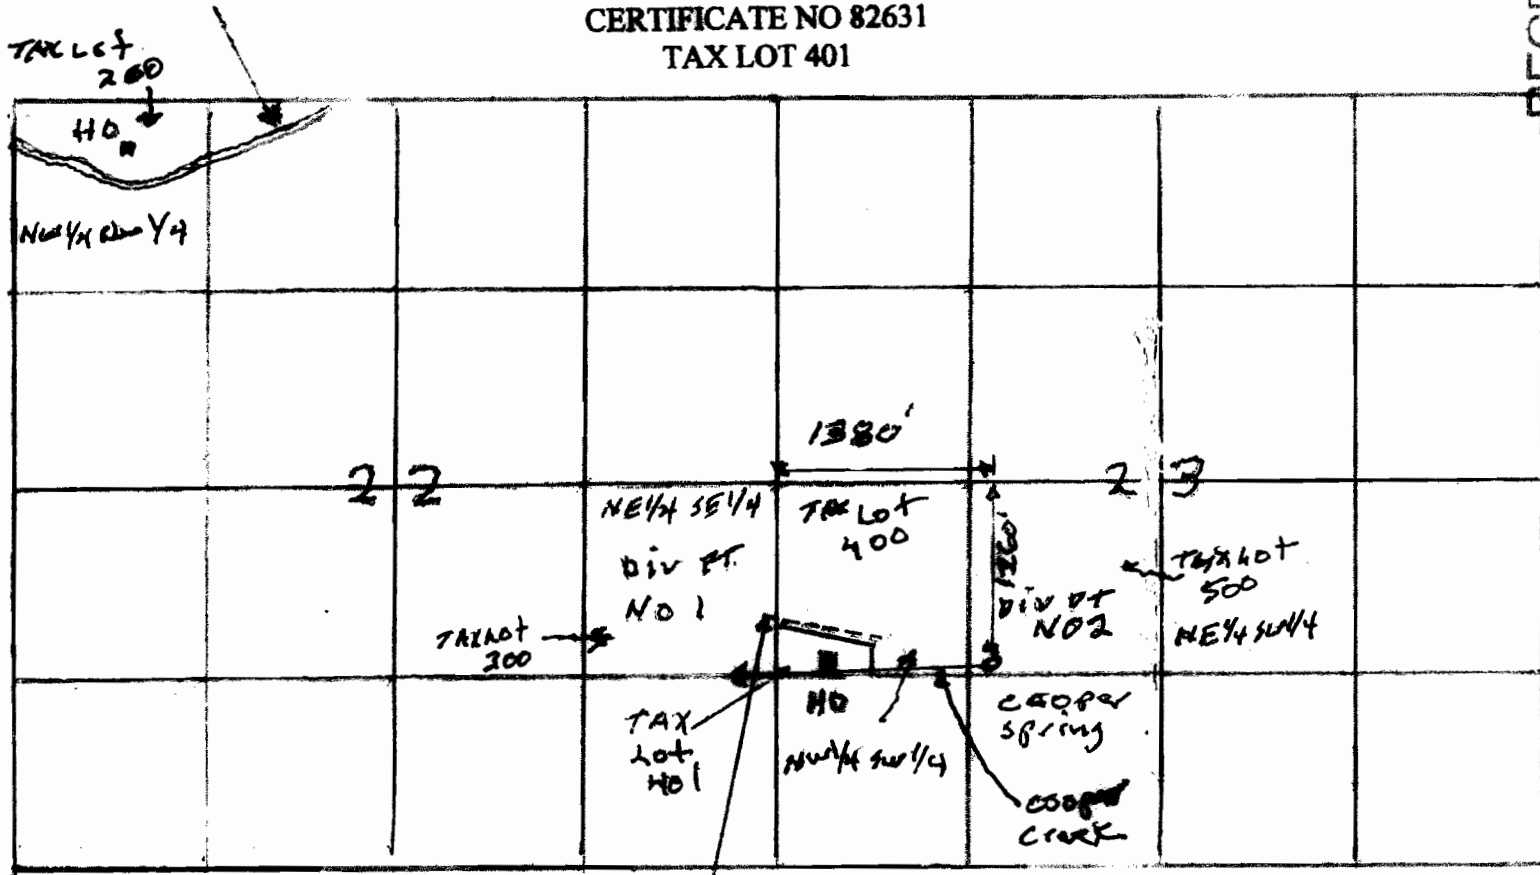


HAWKS MOUNTAIN RD.

OLD DIV. PT. NO 1 NE 1/4 SE 1/4 SEC 22 T28S, R5W. W.M.

NEW DIV. PT. NO. 2 NE 1/4 SW 1/4 SEC 23 T28S R5W. W.M.

THE PURPOSE OF THIS MAP IS TO
 IDENTIFY THE LOCATION OF THE
 WATER RIGHT. IT IS NOT INTENDED
 TO PROVIDE INFORMATION RELATIVE
 TO THE LOCATION OF PROPERTY
 OWNERSHIP BOUNDARY LINES.

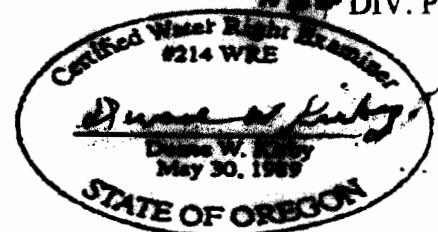


RECEIVED

JUN 25 2008


WATER RESOURCES DEPT.
 SALEM, OREGON

T. 28 S., R. 5 W., W. M.

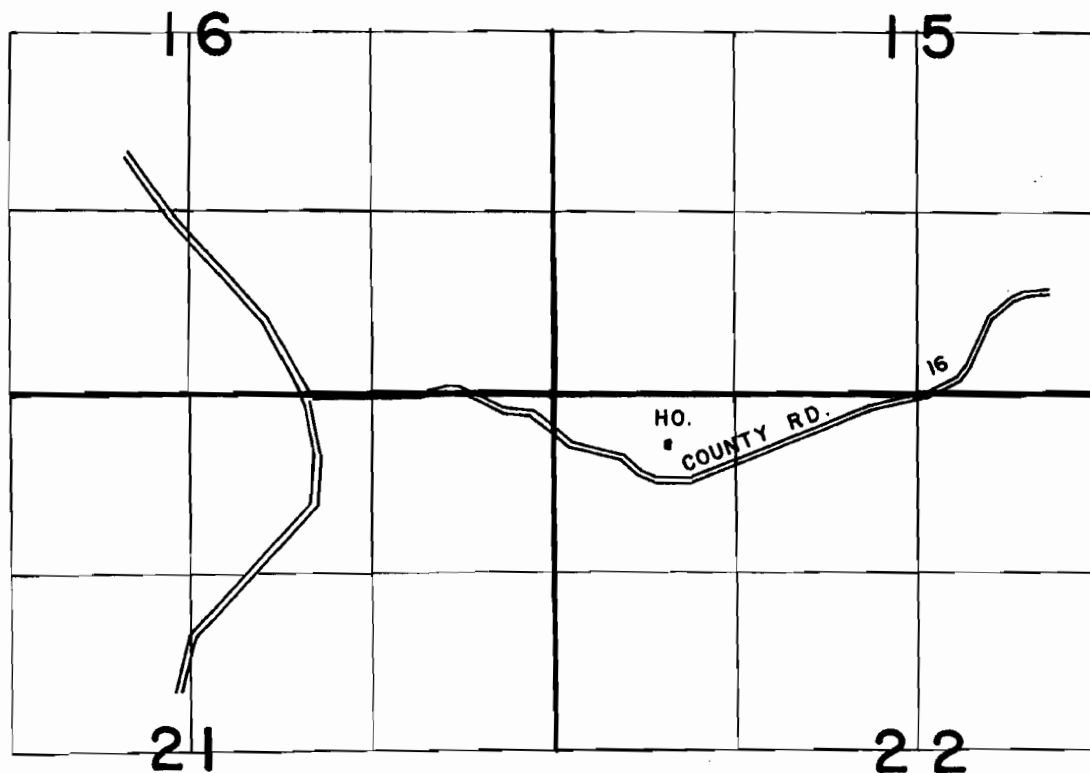

SCALE: 4" = 1 MILE

FINAL PROOF SURVEY
UNDER

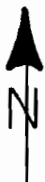

TRANSFER NUMBER: T-5658
IN NAME OF

MELVIN B. HARRIS

Surveyed AUG. 10, 1988, by J.M. SCHMORDE