

N
SCALE:
1" = 400'

NOTES
THIS MAP DOES NOT CONSTITUTE A BOUNDARY SURVEY. FOR BOUNDARY INFORMATION SEE MAP B-282, TILLAMOOK COUNTY SURVEY RECORDS.
THE PURPOSE OF THIS MAP IS TO SHOW THE LOCATION OF THE POINT OF DIVERSION FOR THE WATER RIGHTS TRANSFER.
THE BOUNDARY SHOW WAS DRAWN AS PER RECORD VALUES FROM MAP B-282.

LEGEND
● INDICATES FOUND MONUMENT AS NOTED.
() INDICATES RECORD VALUE FROM MAP B-282.
{ } INDICATES RECORD VALUE FROM MAP B-479.
NO () OR { } INDICATES MEASURED VALUE.

Certified Water Right Examiner
377 WRE
Terry L. Jones
Terry L. Jones
STATE OF OREGON
RENEWAL DATE: JUNE 30, 2009

APPLICATION # G-16687
TRANSFER OF WATER RIGHTS CERTIFICATE
VOLUME 5, PAGE 2164
±126.0 ACRES TOTAL ACREAGE
- ±5.7 ACRES AREA OF EXISTING BUILDINGS
±120.3 ACRES NET AREA TO BE IRRIGATED

RECEIVED
AUG 14 2008
WATER RESOURCES DEPT.
SALEM, OREGON

SITE\CALLENWR.DWG
C-ALLEN.CR5


SURVEY BY:
BAYSIDE SURVEYING
11765 HWY 101 SOUTH
TILLAMOOK, OR. 97141
(503) 842-5551

WATER RIGHTS MAP FOR:
CASEY ALLEN
PORTIONS OF THE
NW 1/4 & NE 1/4 SECTION 13, T1S, R10W, W.M.
SW 1/4 & SE 1/4 SECTION 12, T1S, R10W, W.M.
TILLAMOOK COUNTY, OREGON

DATE	EQUIPMENT	FIELD	DRAWN	CHECKED	JOB NO.
FEB. 21, 2008	TOPCON GPT-3003W TDS NOMAD	TLJ/RJC	GAC	TLJ	

FROM PLACE OF USE MAP
"OLD PLACE OF USE"

TIS R9W.

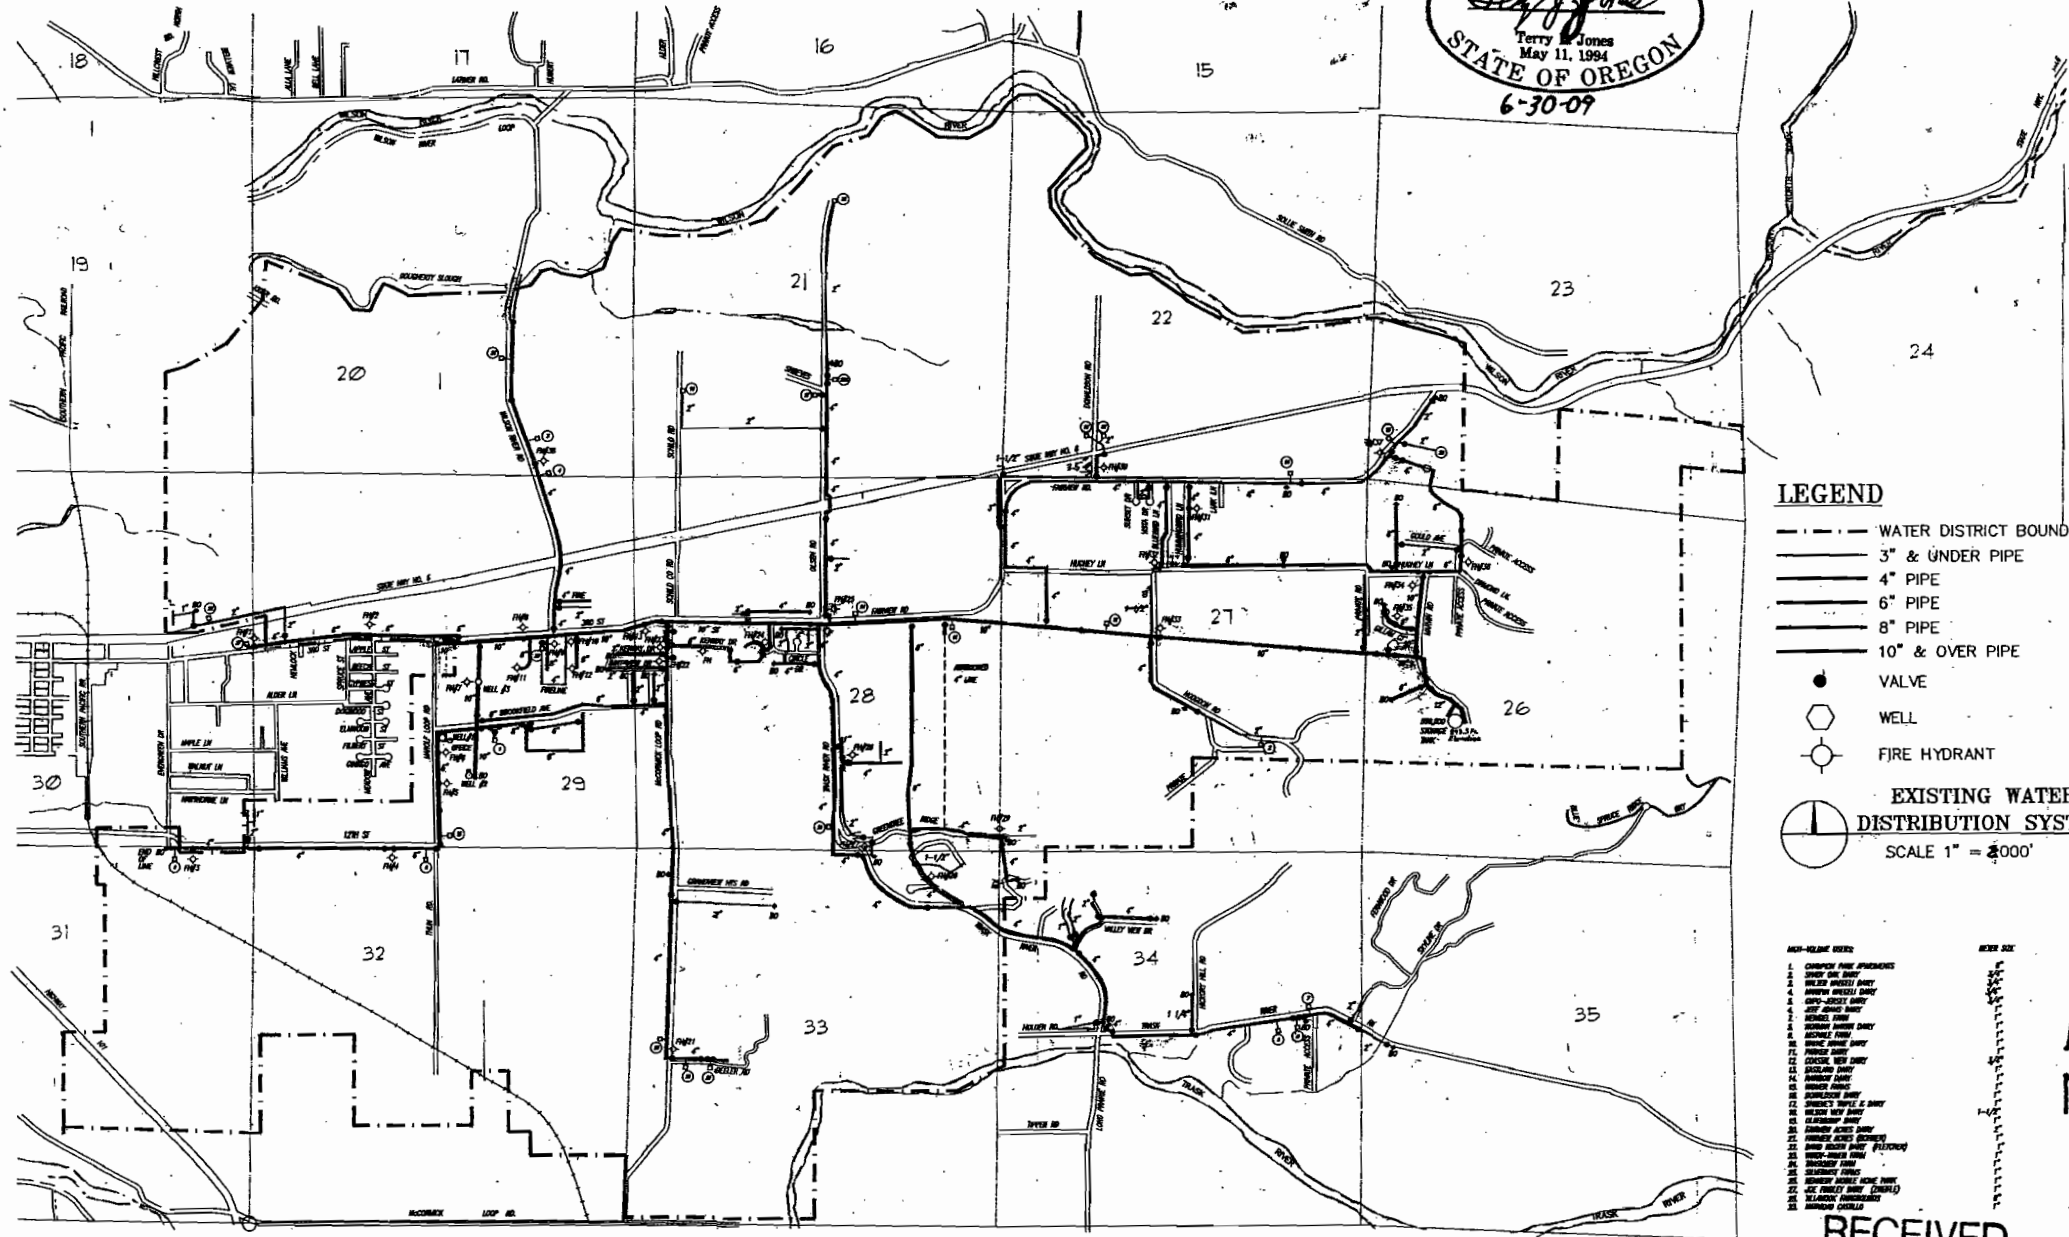

LEGEND

- WATER DISTRICT BOUNDARY
- 3" & UNDER PIPE
- 4" PIPE
- 6" PIPE
- 8" PIPE
- 10" & OVER PIPE
- VALVE
- WELL
- FIRE HYDRANT

EXISTING WATER DISTRIBUTION SYSTEM

- ADD-ON SHEET**
1. CHANGE PIPE APPROXIMATE
 2. CHANGE PIPE APPROXIMATE
RECEIVED
AUG 14 2008
WATER RESOURCES DEPT.
SALEM, OREGON

Fairview Water District
Tillamook, OR

FAIRVIEW WATER DISTRICT
WATER SYSTEM ANALYSIS
Tillamook County, Oregon

Water Distribution Map

Master Plan
January, 2001


Design Group
Klein Consulting Engineers Inc.
2300 N.W. 55TH AVENUE
PHONE: (503) 889-4242
FAX: (503) 845-0900
www.klein-engineers.com

3-9920
1

FROM POINT OF DIVERSION

G.E. DONALDSON
 WATER RIGHT
 S26-T15R0W-WM
 TILLAMOOK CO. OREG.

Certified Water Right Examiner
 377 WRE
Terry L. Jones
 Terry L. Jones
 May 11, 1994
 STATE OF OREGON
 6-30-09

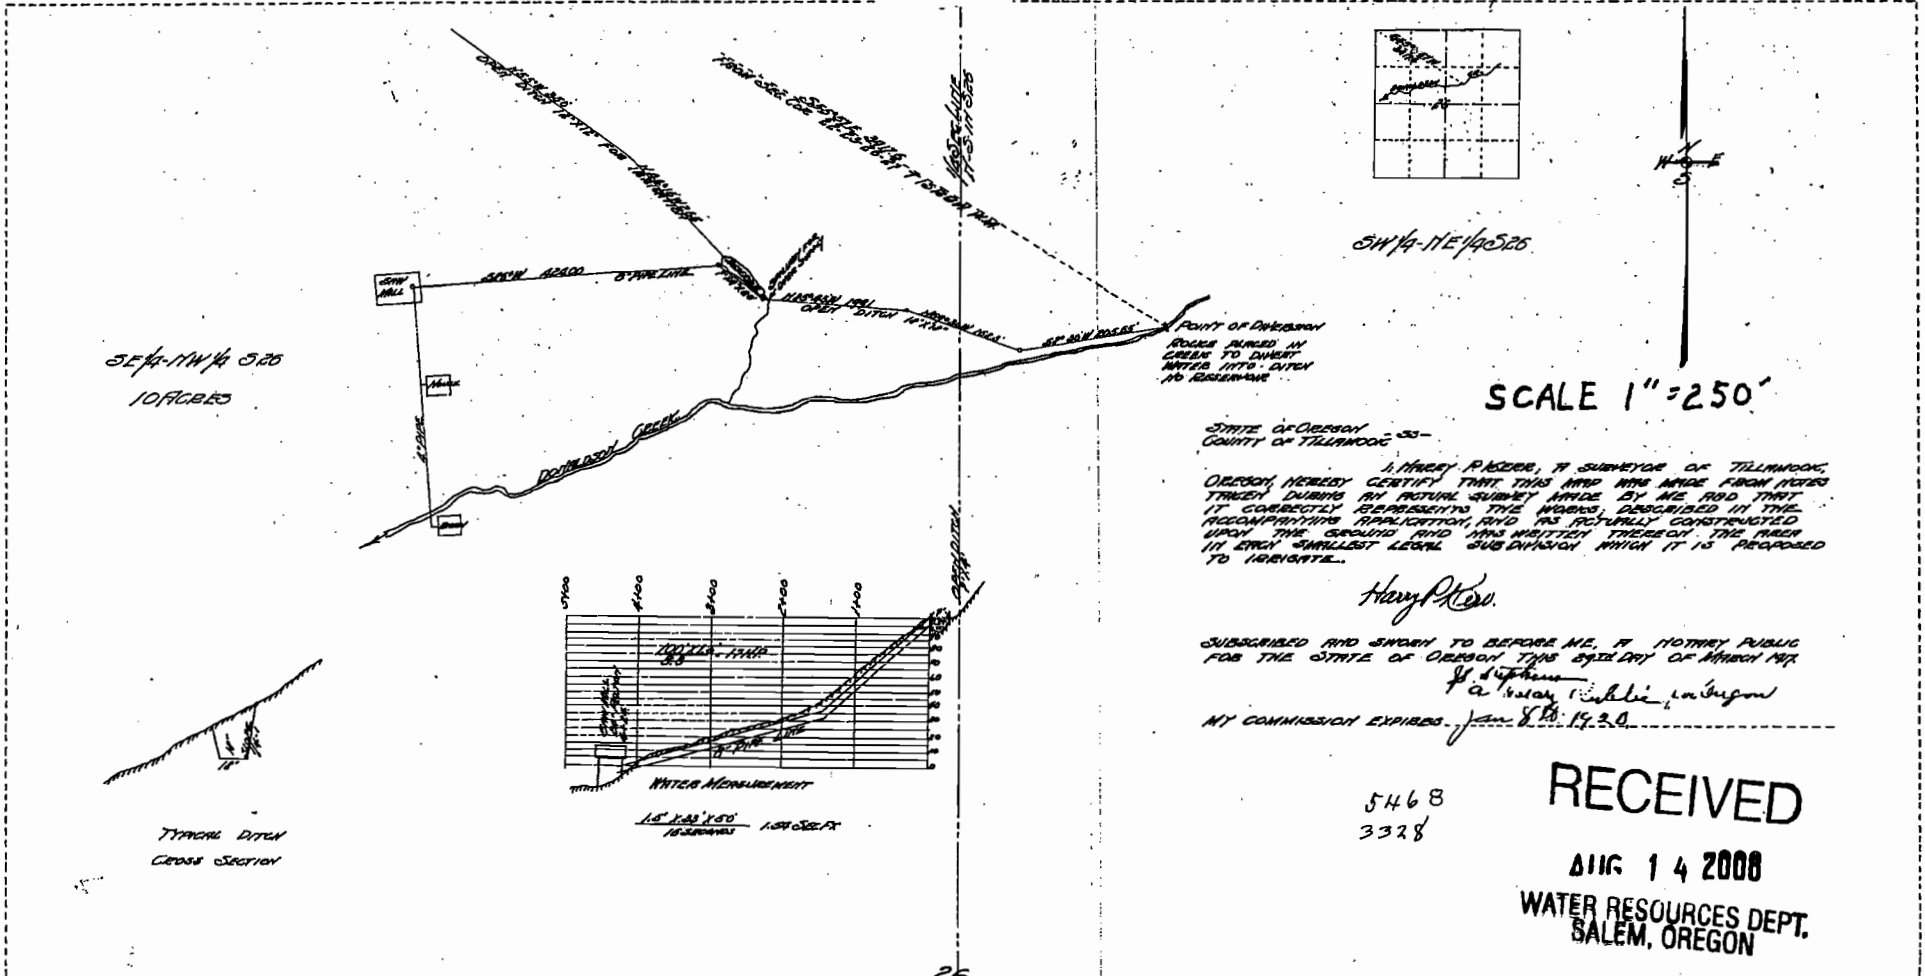

STATE OF OREGON - 35 -
 COUNTY OF TILLAMOOK




5468
 3328

RECEIVED

 WATER RESOURCES DEPT.
 SALEM, OREGON

G.E. DONALDSON
WATER RIGHT
526-TISBROW WM
TILLAMOOK CO. OREG.
1"=100'

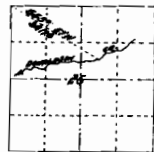

SW 1/4 - NE 1/4 526



STATE OF OREGON - 53 -
 COUNTY OF TILLAMOOK






MY COMMISSION EXPIRES Jan 8th 1920.

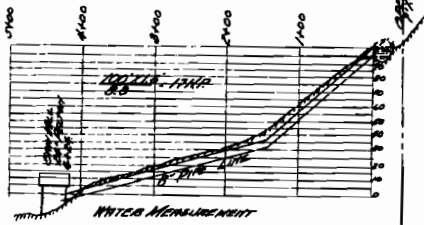


SE 1/4 - NW 1/4 526
 10 ACRES

RECEIVED

AUG 14 2008

WATER RESOURCES DEPT.
 SALEM, OREGON

TYPICAL DITCH
 CROSS SECTION


5468
 3328

S. ANDERSON
 WATER - RIGHT
 526 TLE R. 9W 4N
 TILLAMOOK CO OREGON

SCALE
 1" = 500'



N. ANDERSON
 TILLAMOOK CO OREGON

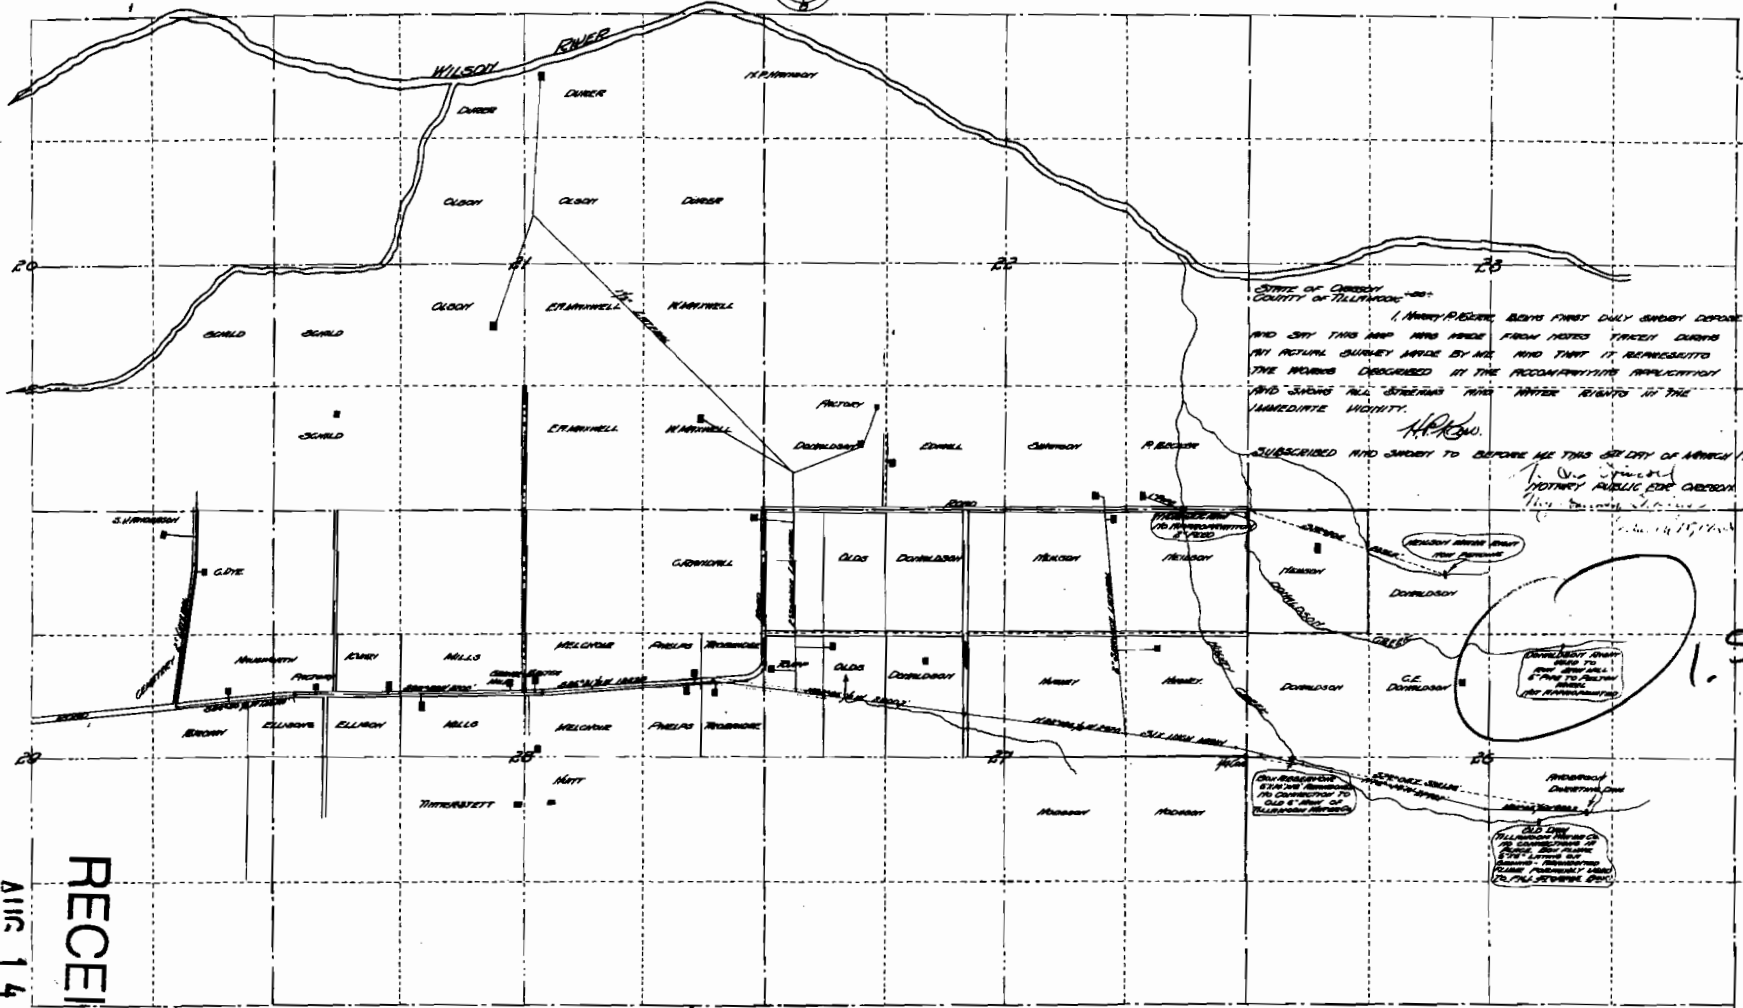



STATE OF OREGON - ss:
 COUNTY OF TILLAMOOK - ss:

 Notary Public for Oregon

RECEIVED

AUG 14 2008

WATER RESOURCES DEPT.
 SALEM, OREGON

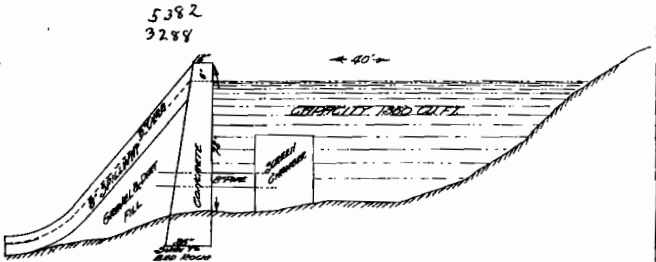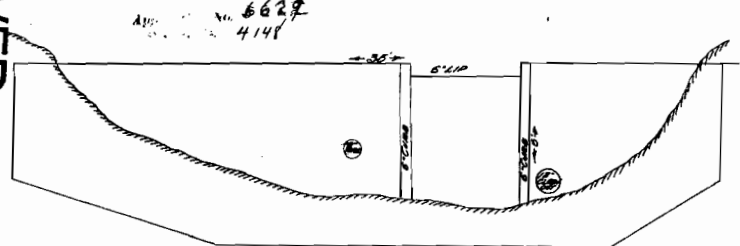

DATE	R	CALCULATED DIST.
1910		347.00
1911		347.00
TOTAL FLOW 2784' AT TOWNSEND.