


T. 7 S., R. 3 W., W. M.

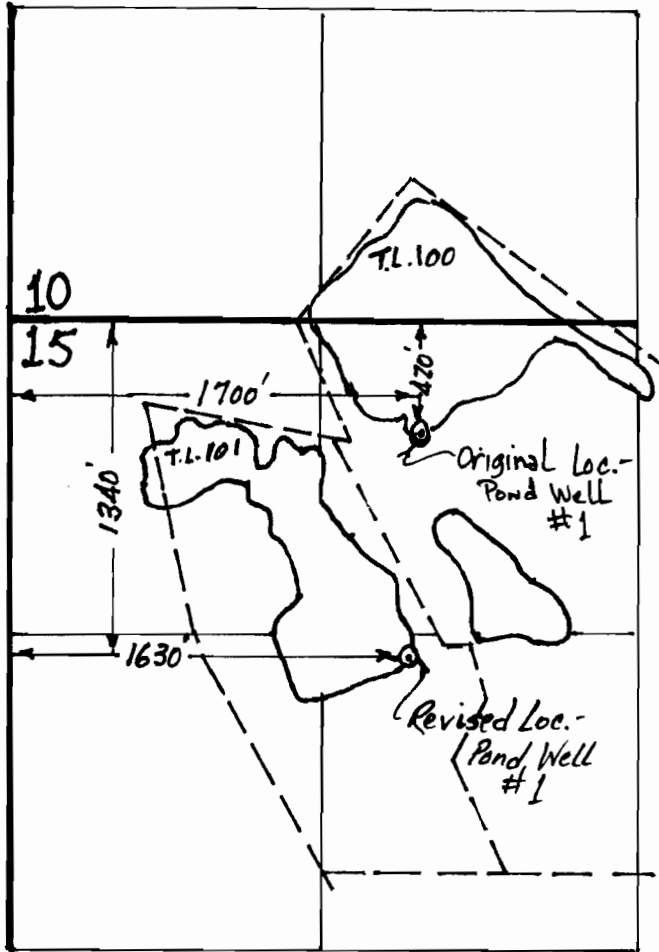

PERMIT AMENDMENT APPLICATION MAP

WALLING PROPERTIES, LLC


APPLICATION G-15685 PERMIT G-15596

RECEIVED

AUG 27 2008

WATER RESOURCES DEPT
SALEM, OREGON

AK
Aug. 2008

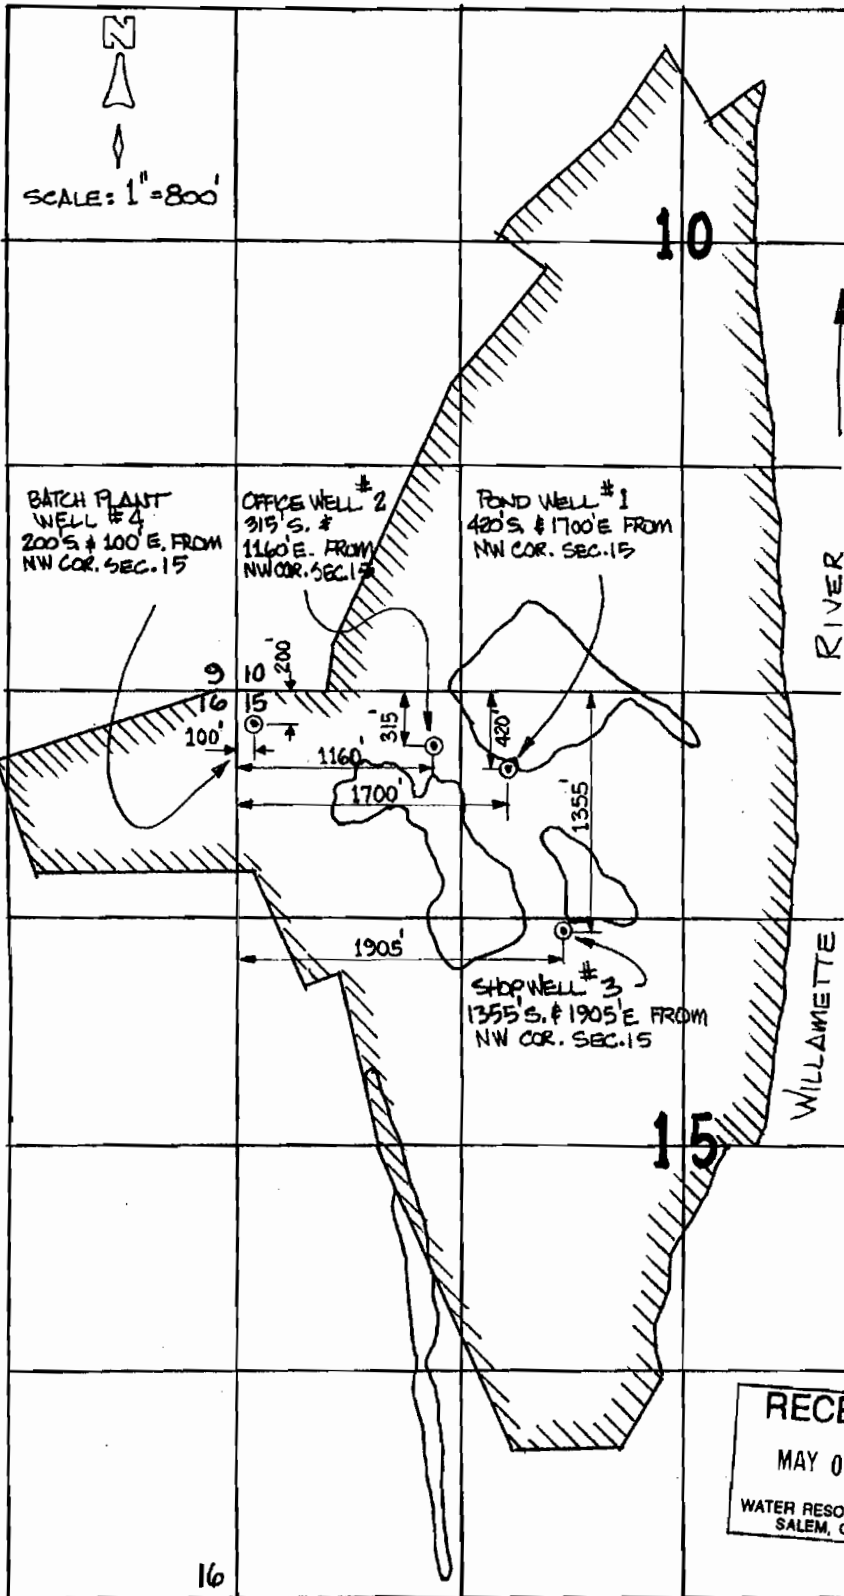

RECEIVED
 MAY 04 2004
 WATER RESOURCES DEPT
 SALEM, OREGON

SECTION 15 T.7S, R.3W
 APPLICATION MAP FOR
 WALLING SAND & GRAVEL CO.
 Permit NO. G-15596
 App. NO. G-15685