


RECEIVED

SEP 07 2000

WATER RESOURCES DEPT
SALEM, OREGON

T 10714

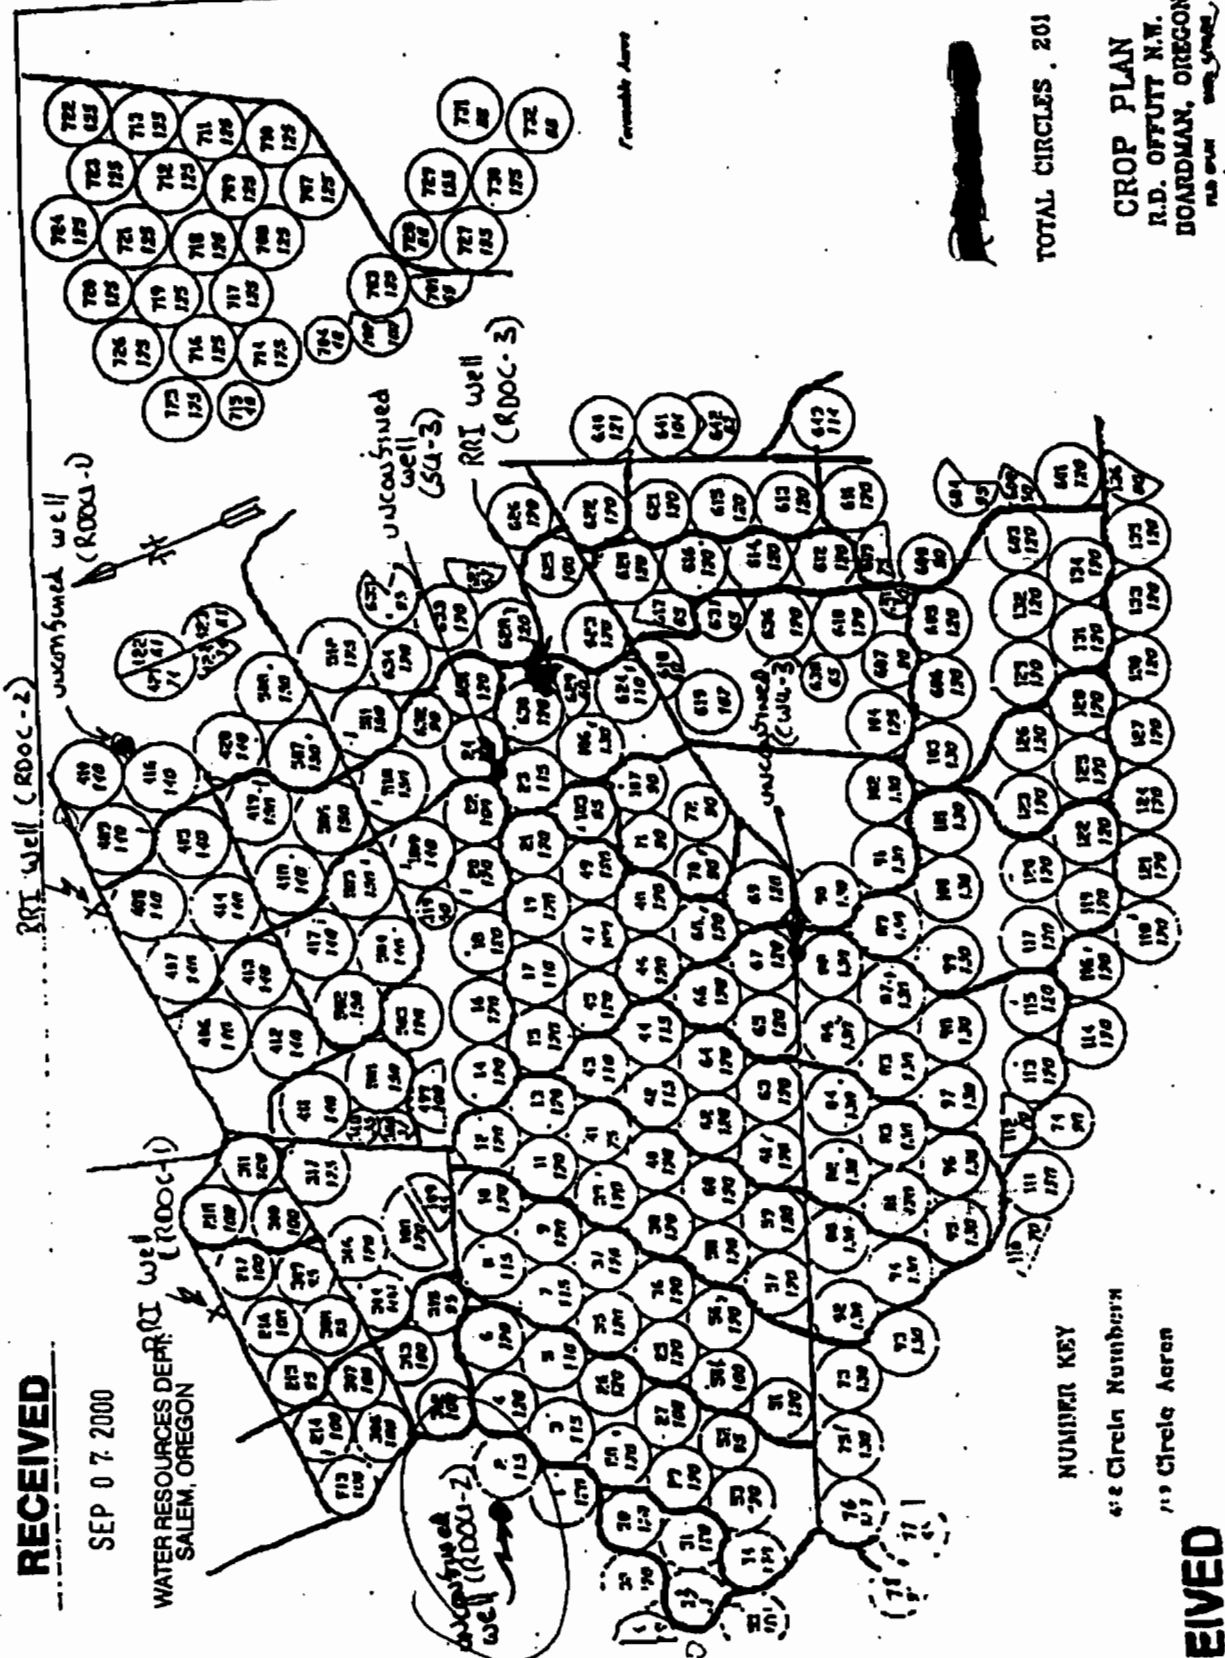

TOTAL CIRCLES 201

CROP PLAN
R.D. OFFUTT N.W.
BOARDMAN, OREGON

NUMBER KEY

6's Circle Number

7's Circle Area

RECEIVED

SEP 30 2008

WATER RESOURCES DEPT
SALEM, OREGON

RECEIVED

FEB 18 2005

WATER RESOURCES DEPT
SALEM, OREGON

