


# TOWNSHIP 30 SOUTH, RANGE 17 EAST, W.M.

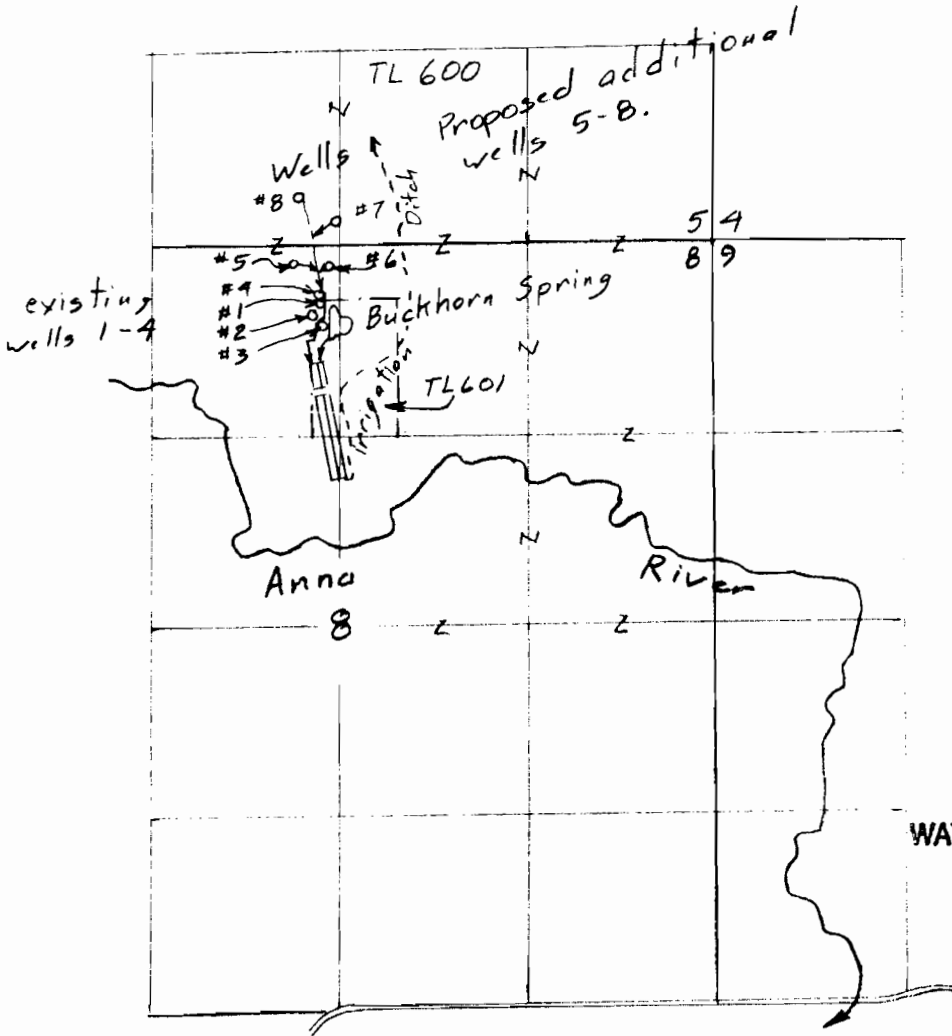

- Wells located from 1/4 corner between sections 5 & 8:
- # 1 390'S & 150'W
  - # 2 480'S & 190'W
  - # 3 525'S & 140'W
  - # 4 340'S & 145'W
  - # 5 150'S & 300'W
  - # 6 160'S & 80'W
  - # 7 150'N & 30'W
  - # 8 340'N & 280'W

**RECEIVED**


SEP 30 2008

WATER RESOURCES DEPT  
SALEM, OREGON

Scale 1" = 1320'  
(4" = 1 mile)

Permit Amendment Map  
for  
Tom MacDonald  
(Desert Springs Trout Farm)

App G-11640  
Per G-11024

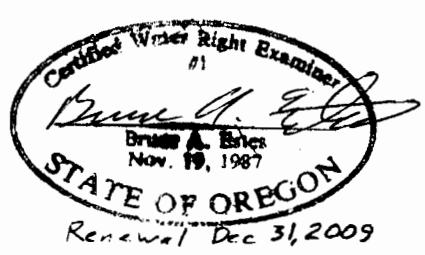

T 10716

This map is for the purpose of locating a water right only and has no intent to provide legal dimensions or the location of property lines.

**ESTES SURVEYS, LLC**

PO Box 17510      80352 Arnold Rd  
 Salem, OR 97306-7510      Bend, OR 97702  
 (503) 585-7500      (541) 382-7391