


Location of Hering Irrigated lands

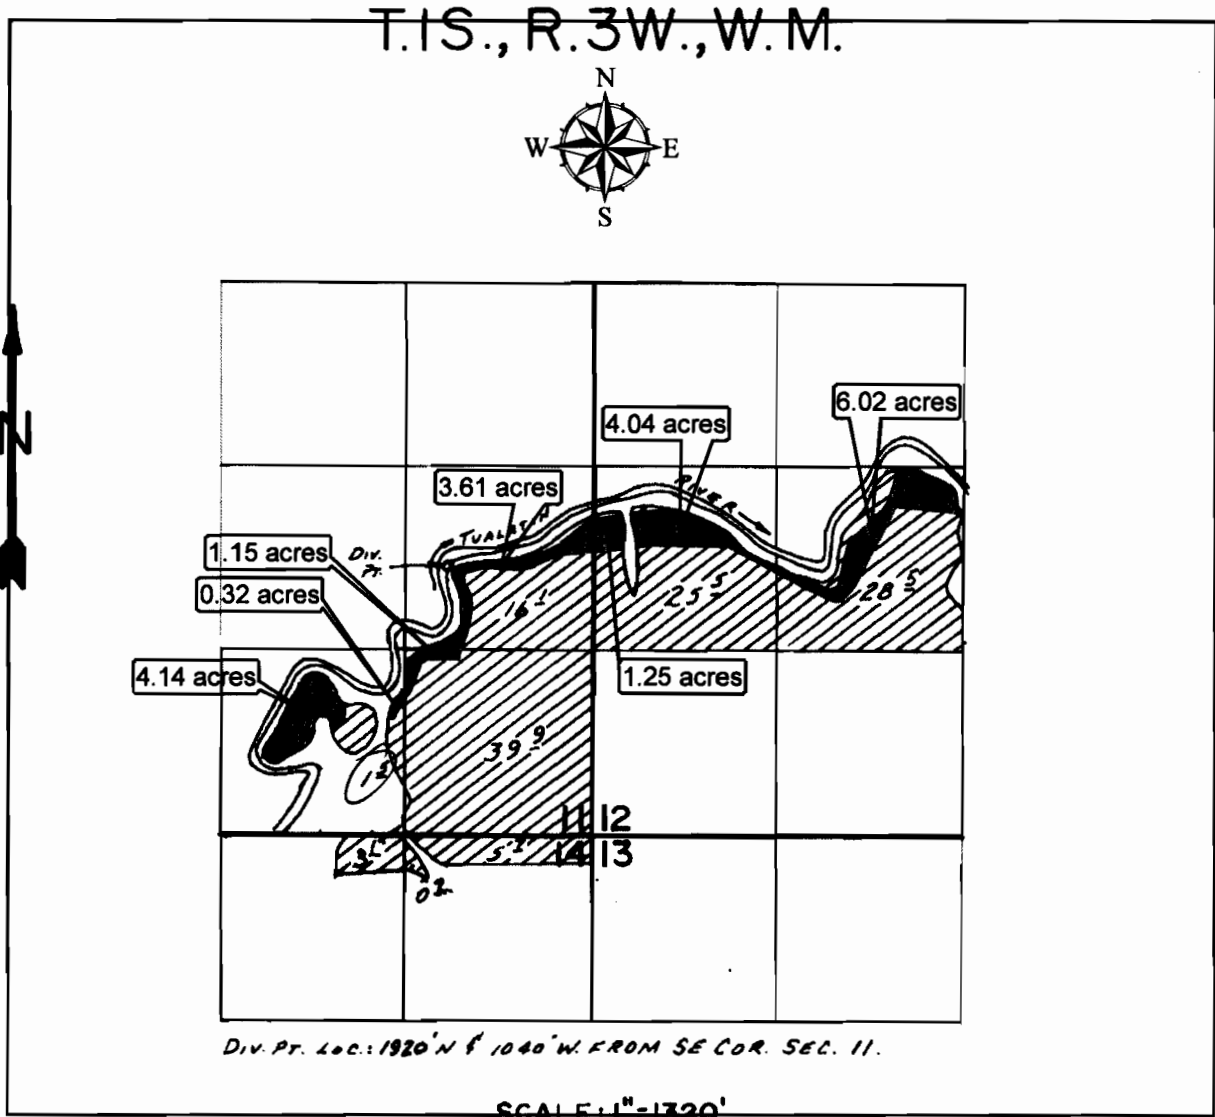

FINAL PROOF SURVEY UNDER

Application No. .63387. Permit No. .46950....
IN NAME OF

 Hering Project Area

1 inch equals 1320 feet

..... DANIEL F. HERING

Surveyed .Aug. 12. 1986. by R.W. BISHOP.....
T. 1S., R. 3W., W.M.