







10722

RECEIVED

NOV 07 2008

WATER RESOURCES DEPT
 SALEM, OREGON

Surveyed Sept. 17 to 19, 1924.

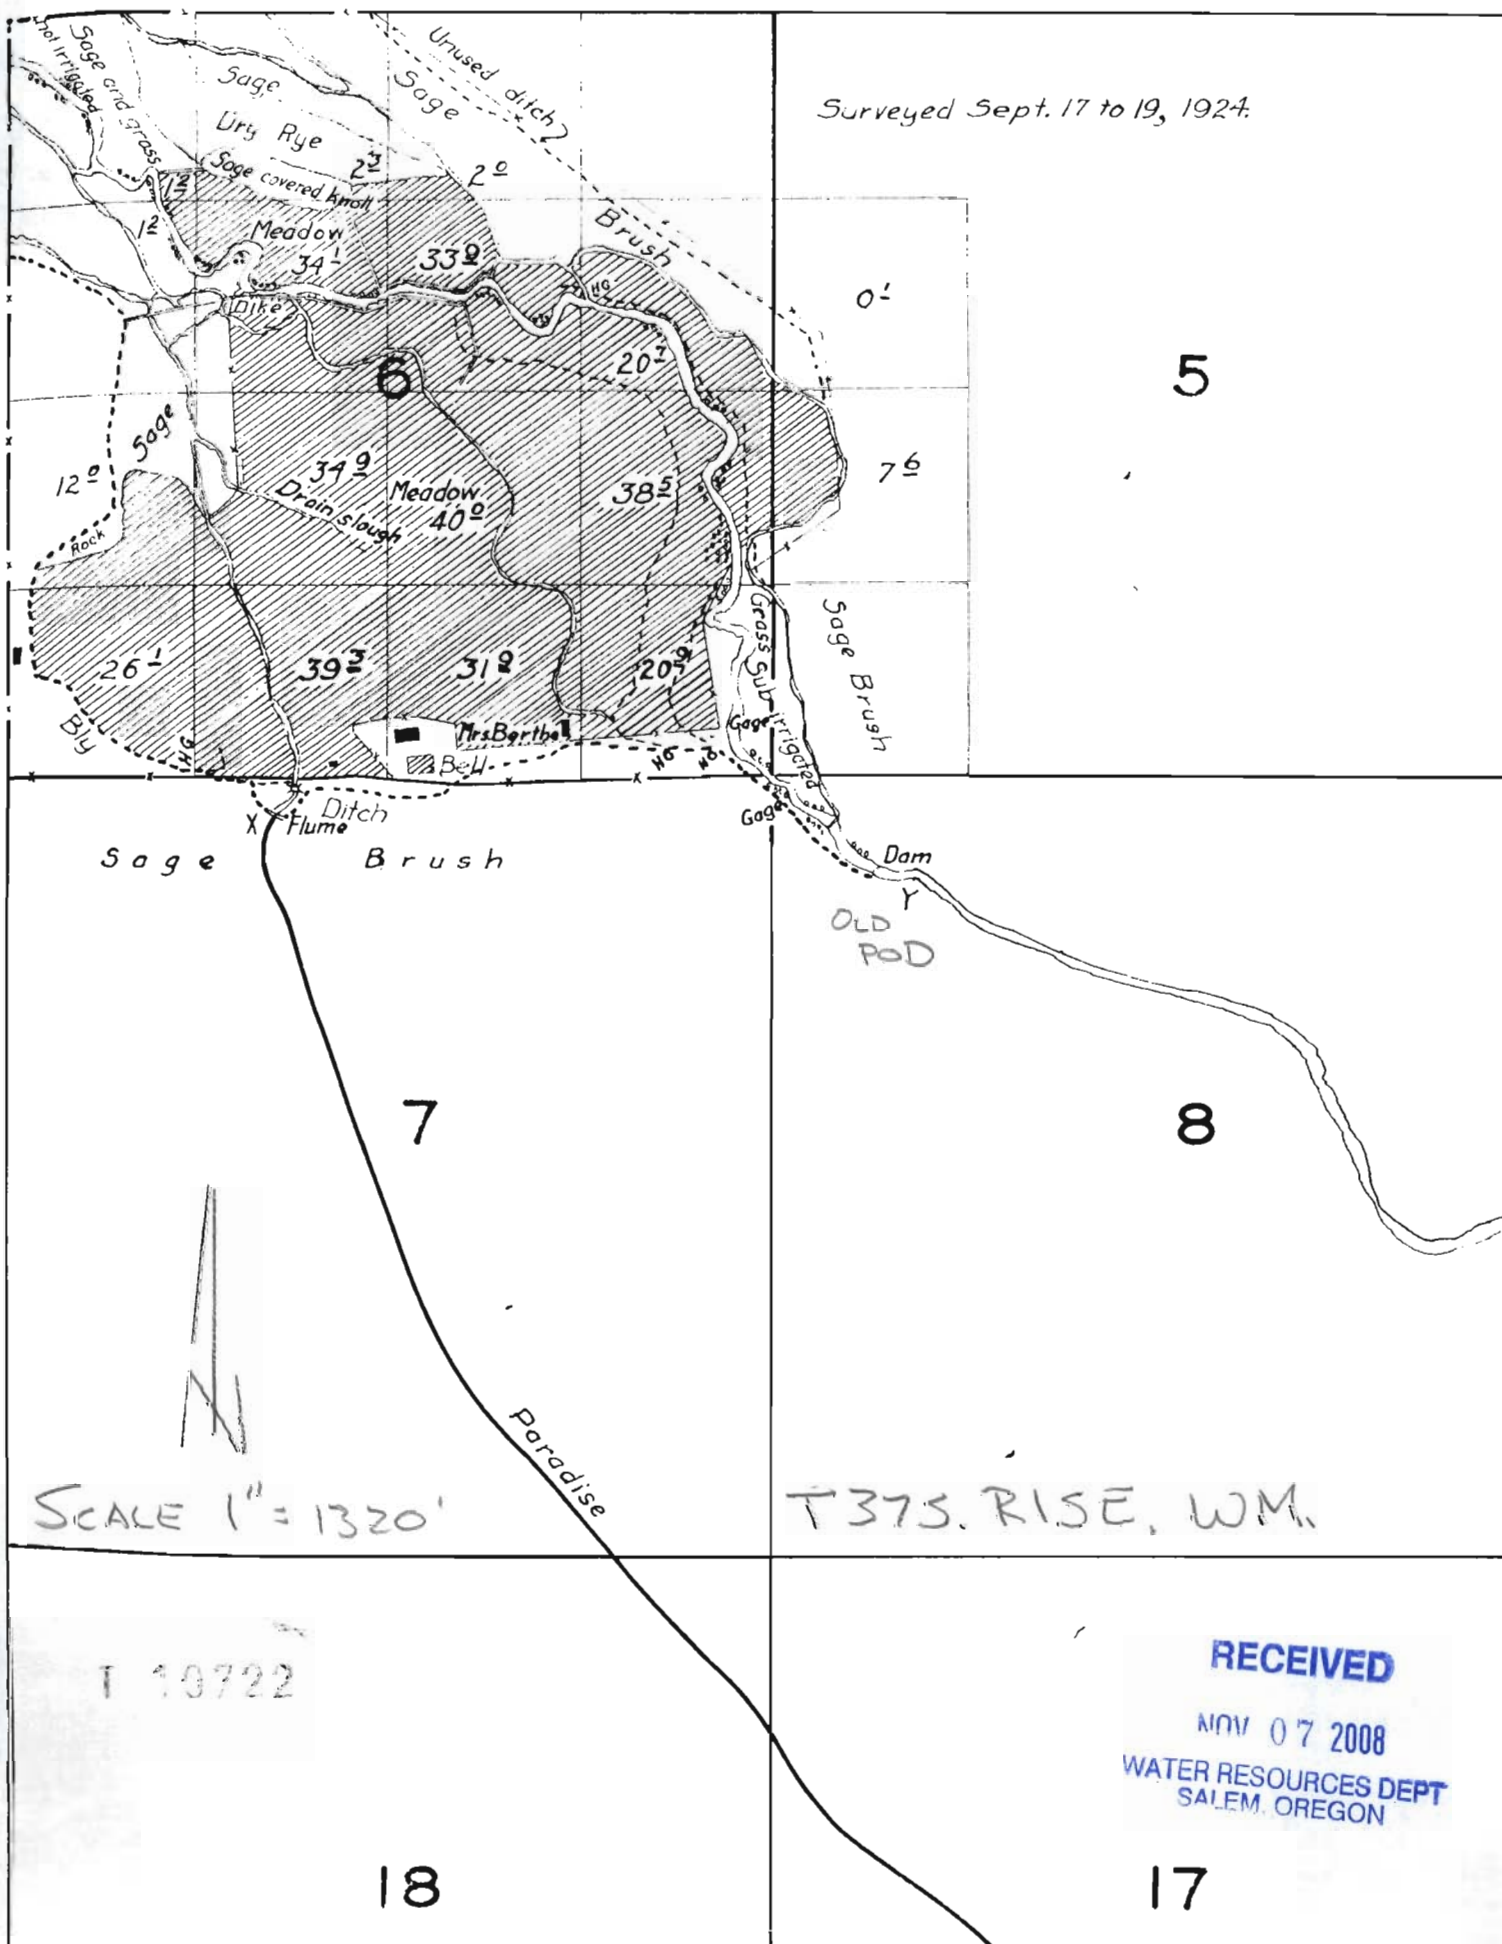

SCALE 1" = 1320'

T37S. RISE, WM.

T 10722

RECEIVED
 NOV 07 2008
 WATER RESOURCES DEPT
 SALEM, OREGON

18

17

