




Triple Springs Ranch LLC
Water Right Transfer
T36S, R1E, Section 18
Tax Lot 900


08-01
Proposed Place of Use

Highway 140

Legend

-  Area to receive water rights
-  Section Line
-  Quarter-quarter Line

1 inch equals 400 feet

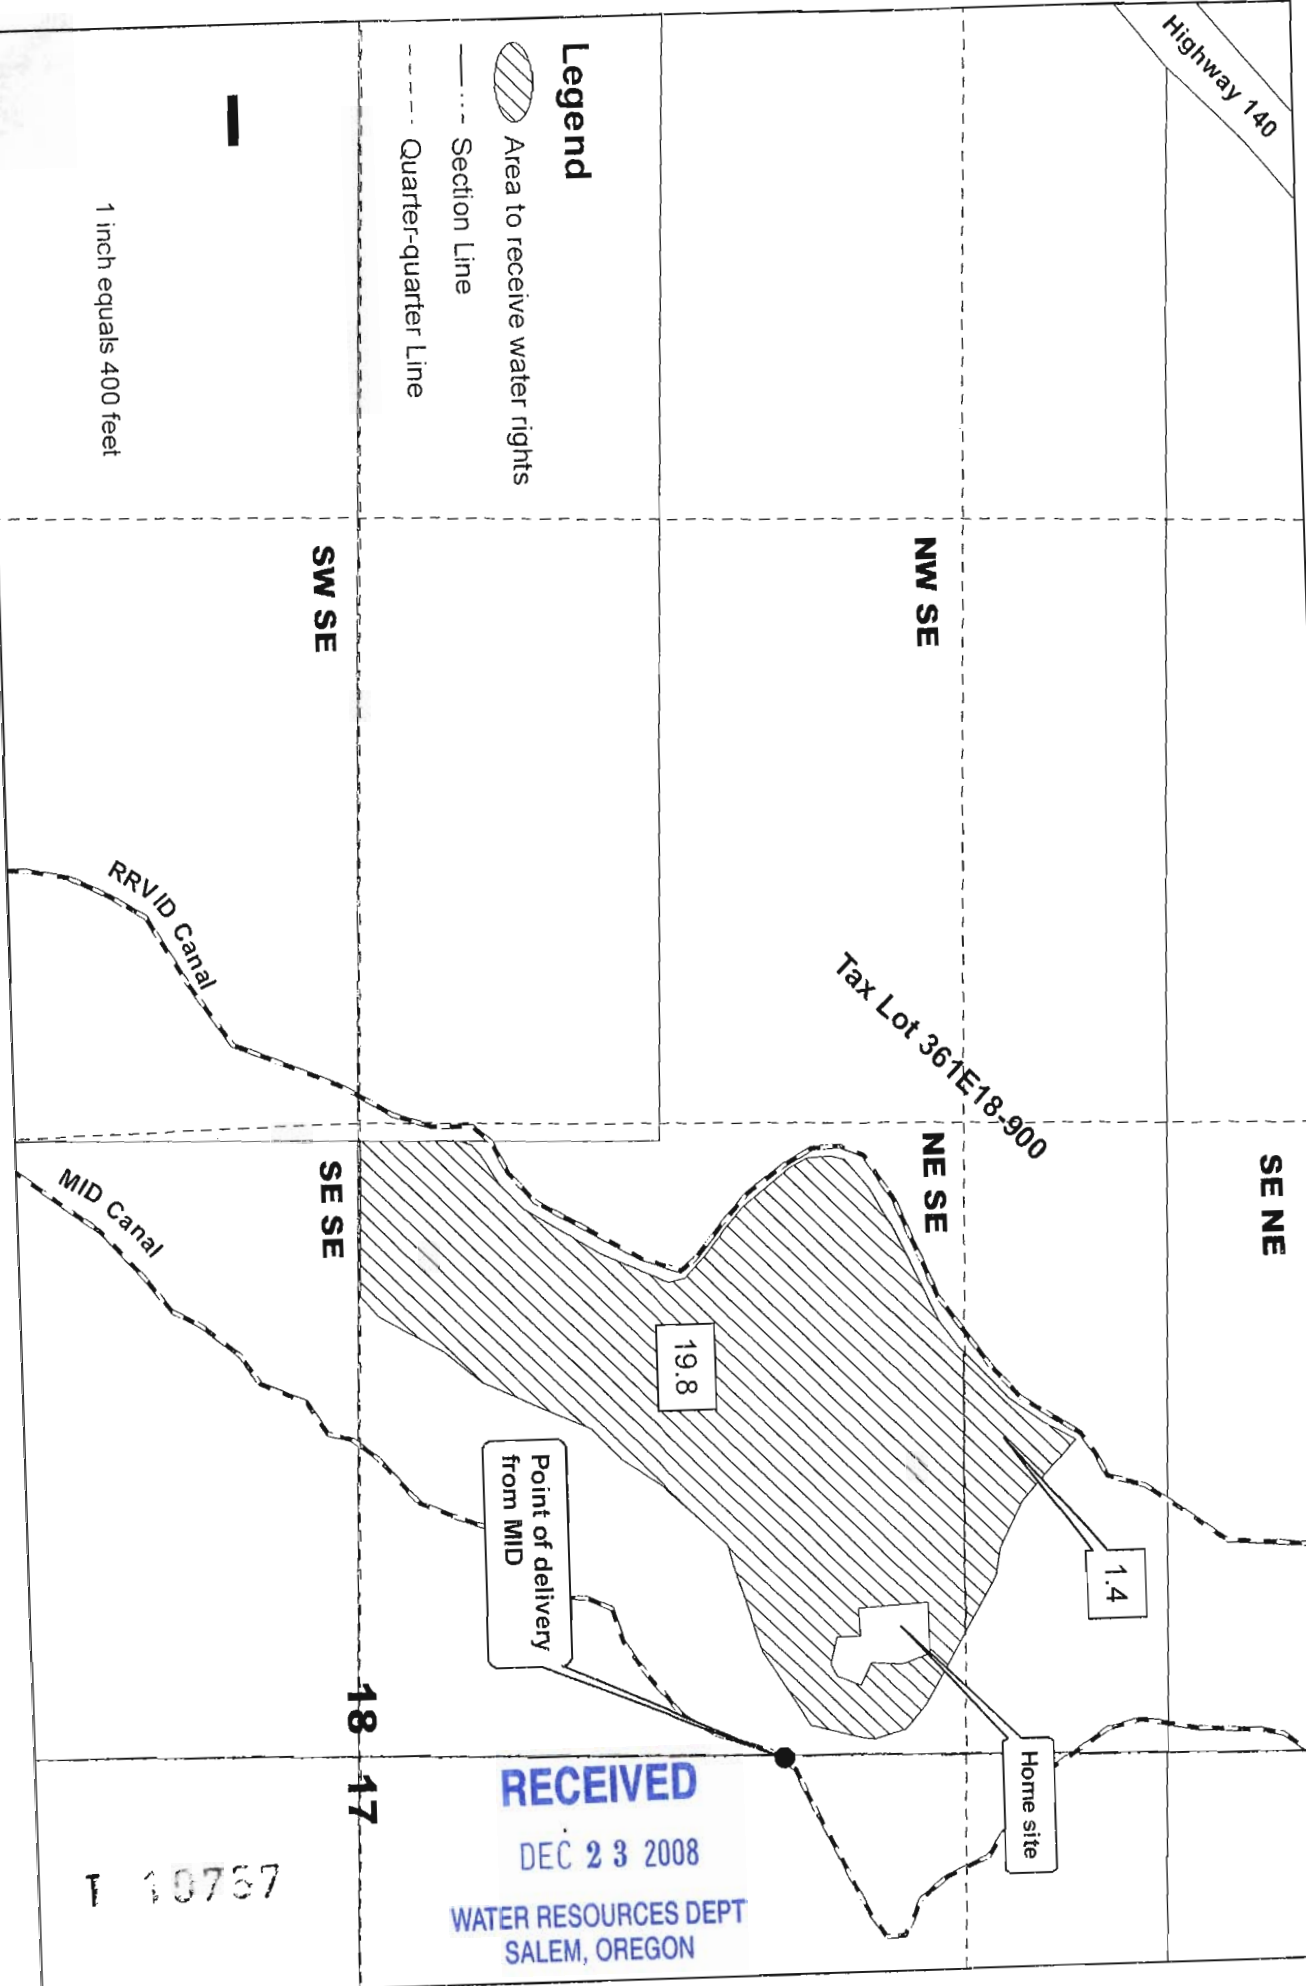


RECEIVED

DEC 23 2008

WATER RESOURCES DEPT
SALEM, OREGON


Authorized Piece of Mt. 08-01

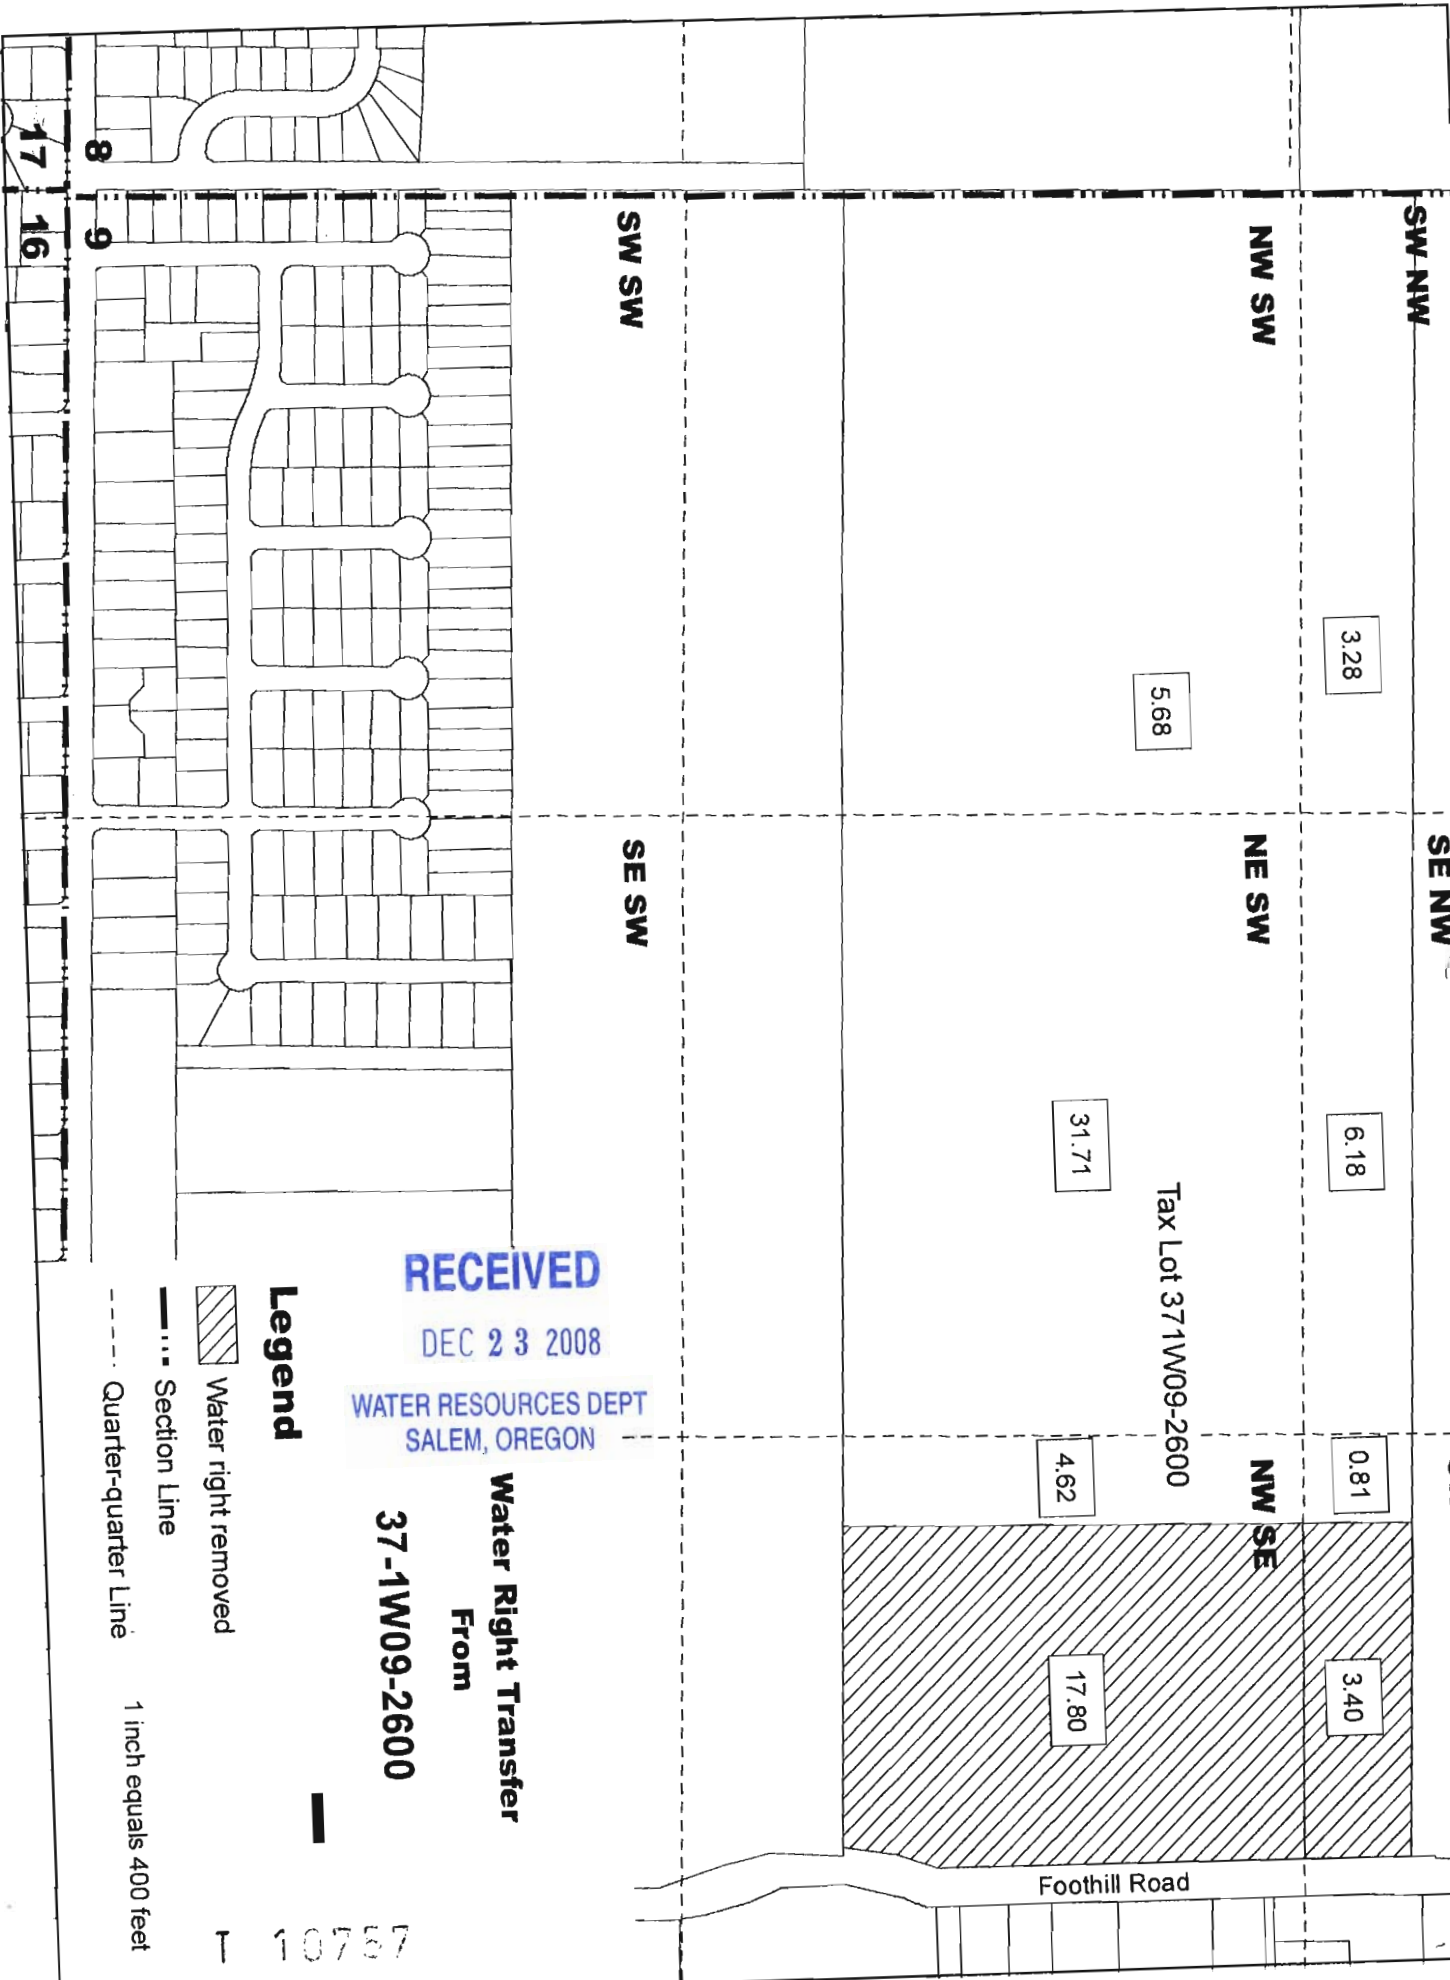

SW NW

NW SW

SE NW

NE SW

SW SW

SE SW

SW NE

NW SE

Tax Lot 371W09-2600

Foothill Road

3.28

5.68

6.18

31.71

0.81

3.40

4.62

17.80

RECEIVED

DEC 23 2008

WATER RESOURCES DEPT
SALEM, OREGON

Legend

Water right removed

Section Line

Quarter-quarter Line

Water Right Transfer

From

37-1W09-2600

1 inch equals 400 feet


T 10757

8

9

17

16

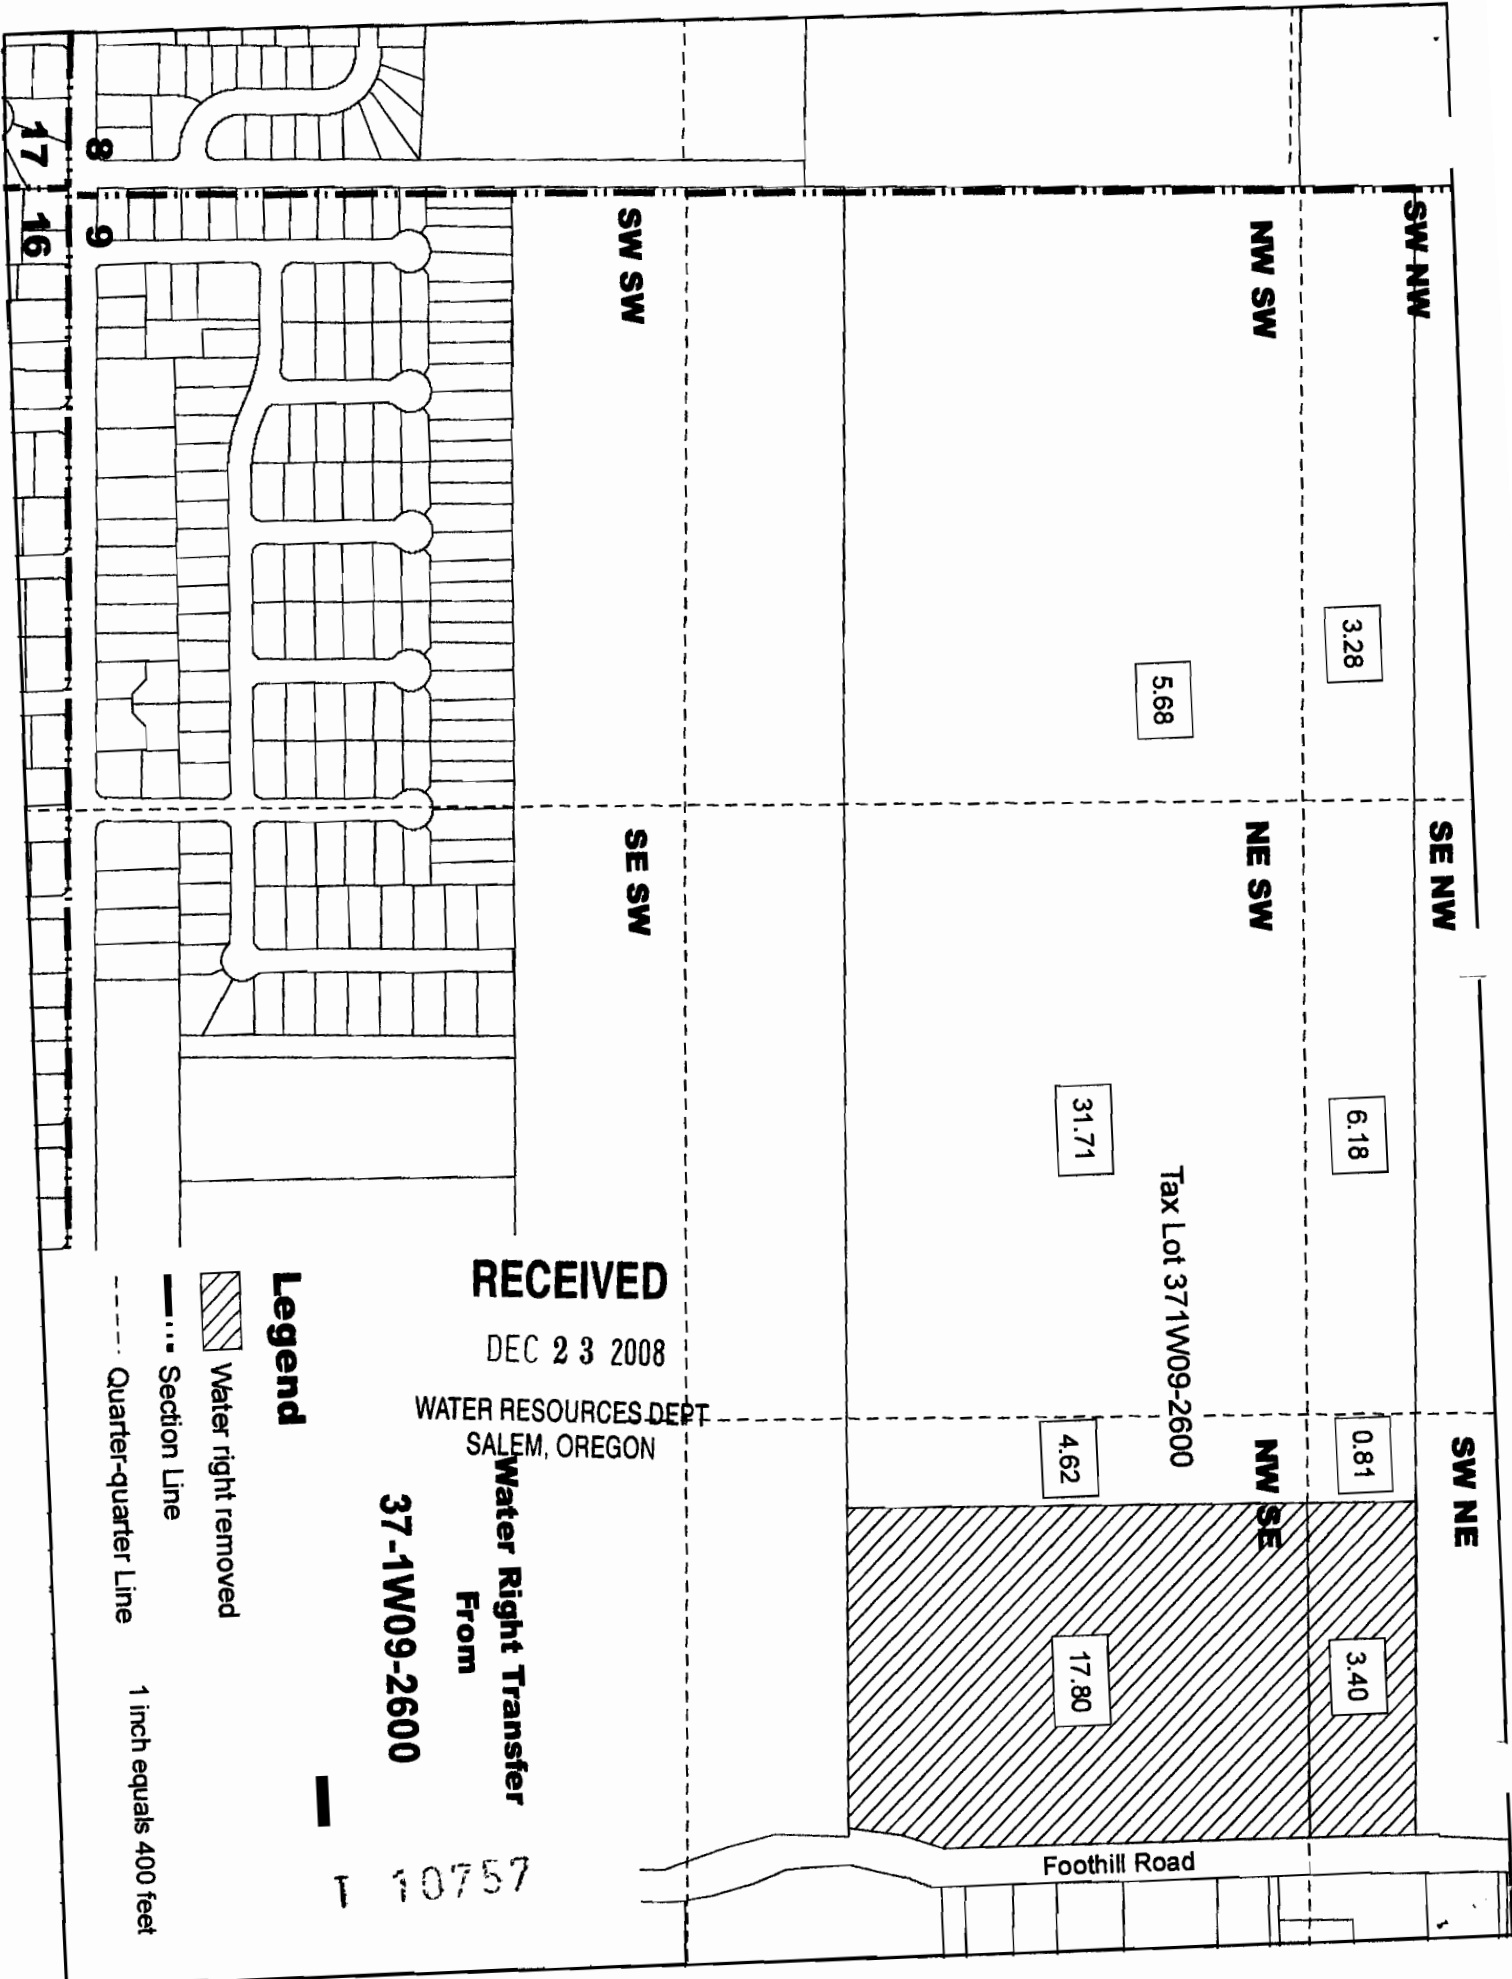

SW NW

SE NW

SW NE

3.28

6.18

0.81

3.40

NW SW

NE SW

NW SE

5.68

31.71

4.62


17.80

Tax Lot 371W09-2600


SW SW

SE SW

Legend

 Water right removed

 Section Line

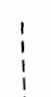 Quarter-quarter Line

1 inch equals 400 feet

RECEIVED

DEC 23 2008

WATER RESOURCES DEPT
SALEM, OREGON

Water Right Transfer
From

37-1W09-2600

T 10757


Foothill Road

17

16

8

9

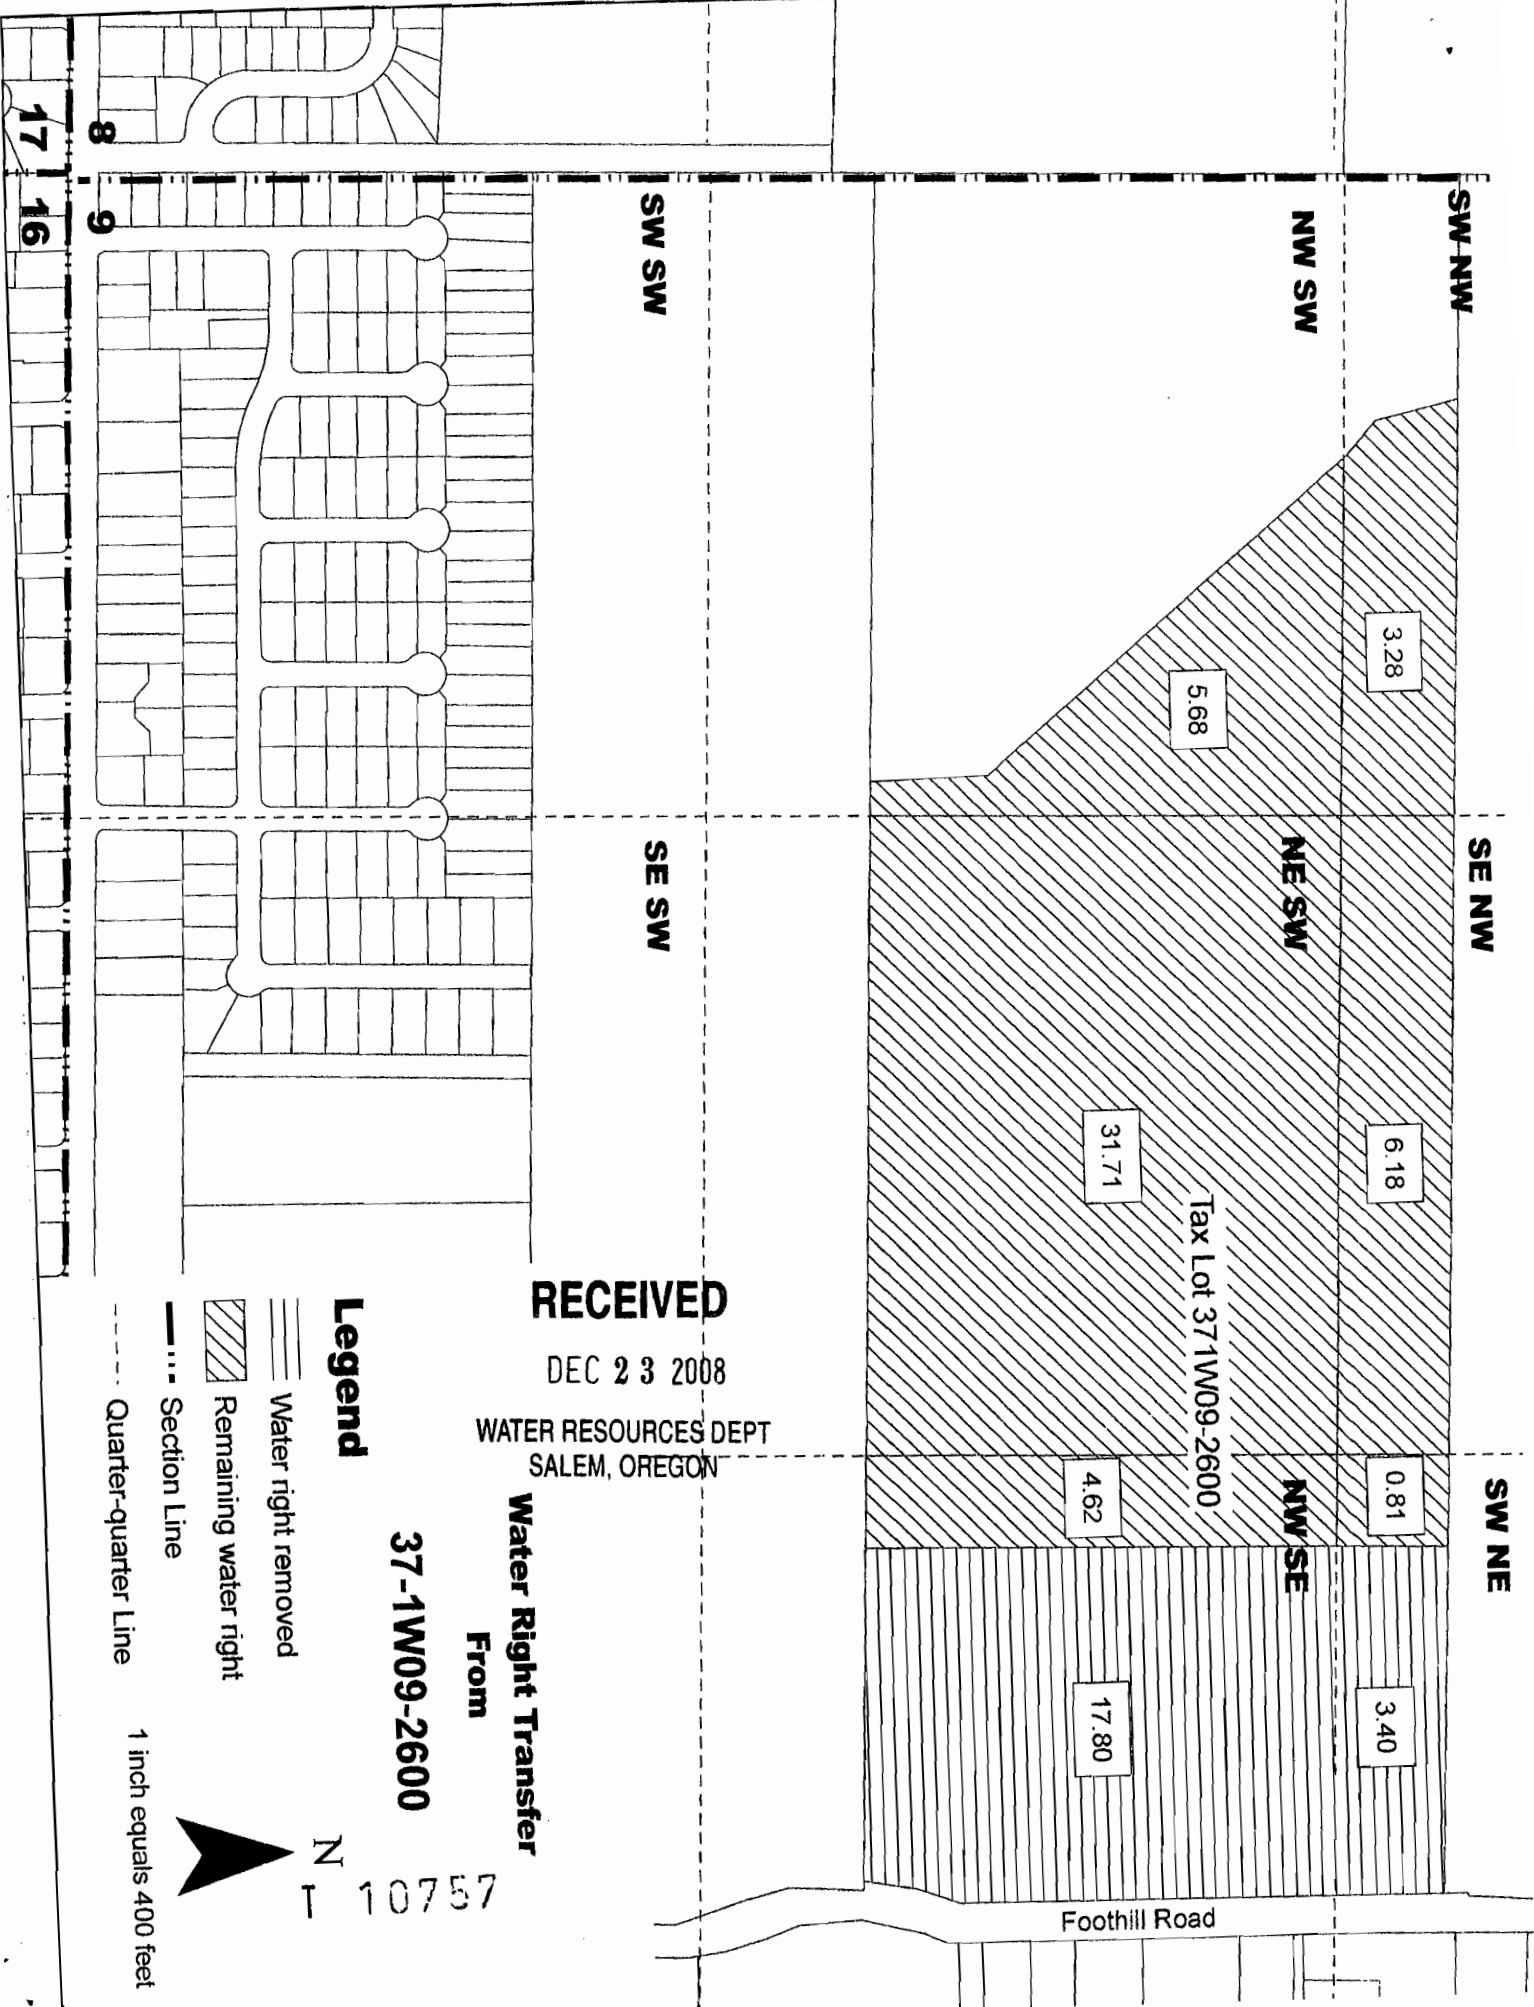

SW NW

NW SW

SW SW

SE NW

NE SW

SE SW

SW NE

NW SE

Tax Lot 37-1W09-2600


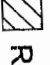


Foothill Road

RECEIVED

DEC 23 2008

WATER RESOURCES DEPT
SALEM, OREGON

Legend

-  Water right removed
-  Remaining water right
-  Section Line
-  Quarter-quarter Line

1 inch equals 400 feet



T 10757

Water Right Transfer
From

37-1W09-2600

8

9

17

16


Authorized Place of Use 08-02

06-18 Transfer From:
Medford Irrigation District
37 South, Range 1 West,
Section 9 SWSE 5.02 Acres
2700

- District Boundary USBF
- Road Labels
- Township Range
- Sections
- Section Labels
- Quarters
- Quarter Labels
- Quarter Quarters
- Quarter Quarters Labels
- Lot Labels
- Taxlots
- Waterbodies JACK CO
- Irrigation Ditches JACK CO
- Place of Use WORKING

Transfer from
AG

10757
scale 1" = 40000'
created: 6/15/2006

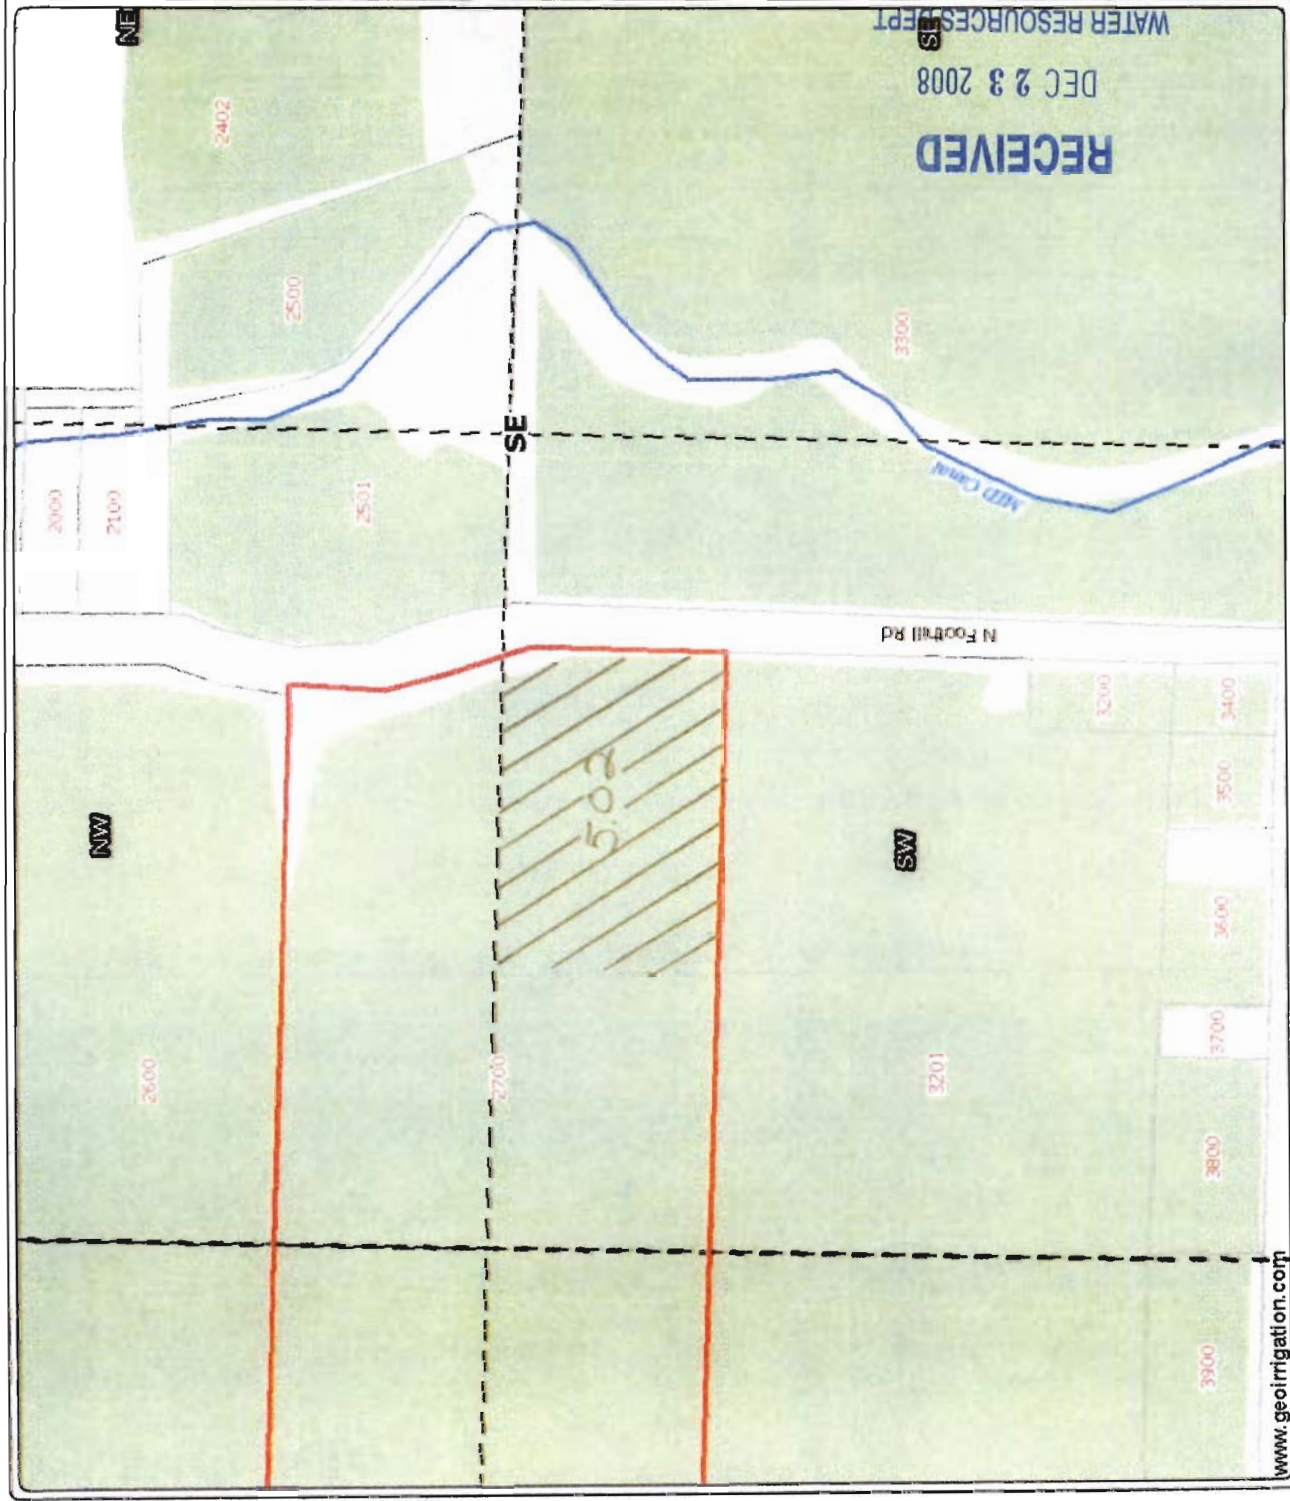

Powered By
geoirrigation

DISCLAIMER: This map is intended for display purposes only and is not intended for any legal representations.
There are no warranties, expressed or implied, that accompany this product.

www.geoirrigation.com

Authorized Place of Use
08-02

06-18 Transfer From:
Medford Irrigation District

37 South, Range 1 West,
Section 21 SWNW 1.95 Acres
TAX Lots 2000, 2001
& 2002

- District Boundary USBR
- Road Labels
- Township Range
- Sections
- Section Labels
- Quarters
- Quarter Labels
- Quarter Quarters
- Quarter Quarters Labels
- Taxlots
- Waterbodies JACK CO
- Irrigation Ditches JACK CO
- RYCOG Laterals
- Place of Use WORKING

Transfer from
AC.

RECEIVED
DEC 23 2008
scale 1:400,000
created: 5/19/2006
10757



Powered By
geointegration

DISCLAIMER: This map is intended for display purposes only and is not intended for any legal representations.
There are no warranties, expressed or implied, that accompany this product.

www.geointegration.com

Proposed Place of Use
08-02

06-18 Transfer To:
Lambert

36 South, 1 West, Section 36
SWSE 7.0 Acres
1500

- District Boundary USBR
- Road Labels
- Township Range
- Sections
- Section Labels
- Quarters
- Quarter Labels
- Quarter Quarters
- Quarter Quarters Labels
- Taxlots
- Waterbodies JACK CO
- Irrigation Ditches JACK CO
- RYCOG Laterals
- Place of Use WORKING

Transfer To
Ac.

WATER RESOURCES DEPT
SALEM, OREGON

RECEIVED
DEC 23 2008

1 10757

scale 1" = 400.00'
created: 6/16/2006



Powered By
geoirrigation

DISCLAIMER: This map is intended for display purposes only and is not intended for any legal representations.
There are no warranties, expressed or implied, that accompany this product.

www.geoirrigation.com

08-03

Place of Use

Transfer To:
RIBAL

37S 2W 20 AA TL 300

NEVE

300

- District Boundary USBR
- Road Labels
- Township Range
- Sections
- Section Labels
- Quarters
- Quarter Labels
- Quarter Quarters
- Quarter Quarters Labels
- Lot Labels
- Taxlots
- Waterholes JACK CO
- Irrigation Ditches JACK CO
- Place of Use WORKING




2.54 ir. ACs

WATER RESOURCES DEPT
SALEM, OREGON

RECEIVED
DEC 23 2008

10757

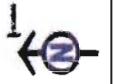

scale 1" = 400.00'
created: 3/27/2006



Powered By
geolrrigation

DISCLAIMER: This map is intended for display purposes only and is not intended for any legal representations.
There are no warranties, expressed or implied, that accompany this product.

www.geolrrigation.com - NE -

08-03
Authorized Place of Use

Transfer From:
WINGLER


37S 2W 26 B TL 1501

- District Boundary USBR
- Road Labels
- Township Range
- Sections
- Section Labels
- Quarters
- Quarter Labels
- Quarter Quarters
- Quarter Quarters Labels
- Lot Labels
- Taxlots
- Waterbodies JACK CO
- Irrigation Ditches JACK CO
- Place of Use WORKING

2.54 INT. AC.

RECEIVED
DEC 23 2008
WATER RESOURCES DEPT
SALEM, OREGON

scale 1" = 400.00'
created: 3/27/2006

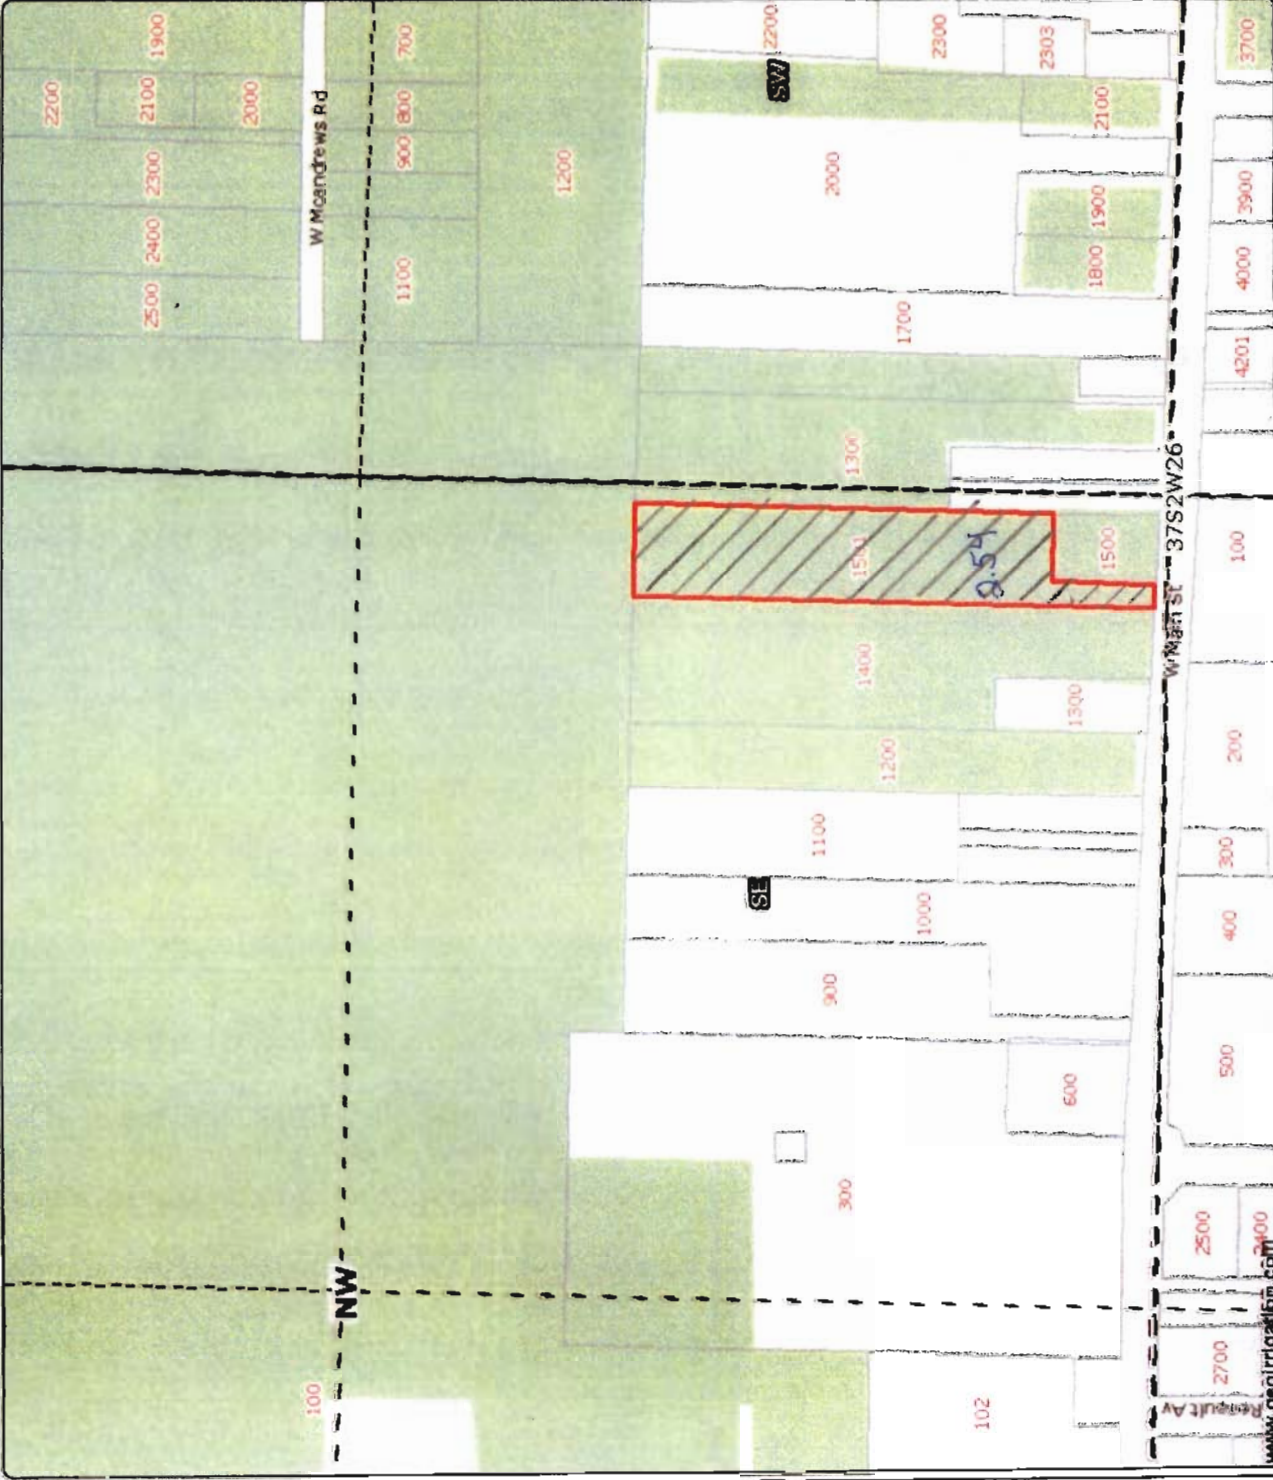

Powered By
geoirrigation

DISCLAIMER: This map is intended for display purposes only and is not intended for any legal representations.
There are no warranties, expressed or implied, that accompany this product.

Authorized Place of Use
08-04

Transfer From Land:
37S 1W 09 TL 2700
48.28 AC.

- District Boundary USBR
- Road Labels
- Township Range
- Sections
- Section Labels
- Quarters
- Quarter Labels
- Quarter Quarters
- Quarter Quarters Labels
- Lot Labels
- Tractlets
- Waterbodies JACK CO
- Irrigation Ditches JACK CO
- Place of Use WORKING


Transfer From
PC.

9 SECTION

RECEIVED
DEC 23 2008
WATER RESOURCES DEPT
SALEM, OREGON

10757

scale 1" = 1,092.30'
created: 4/13/2006

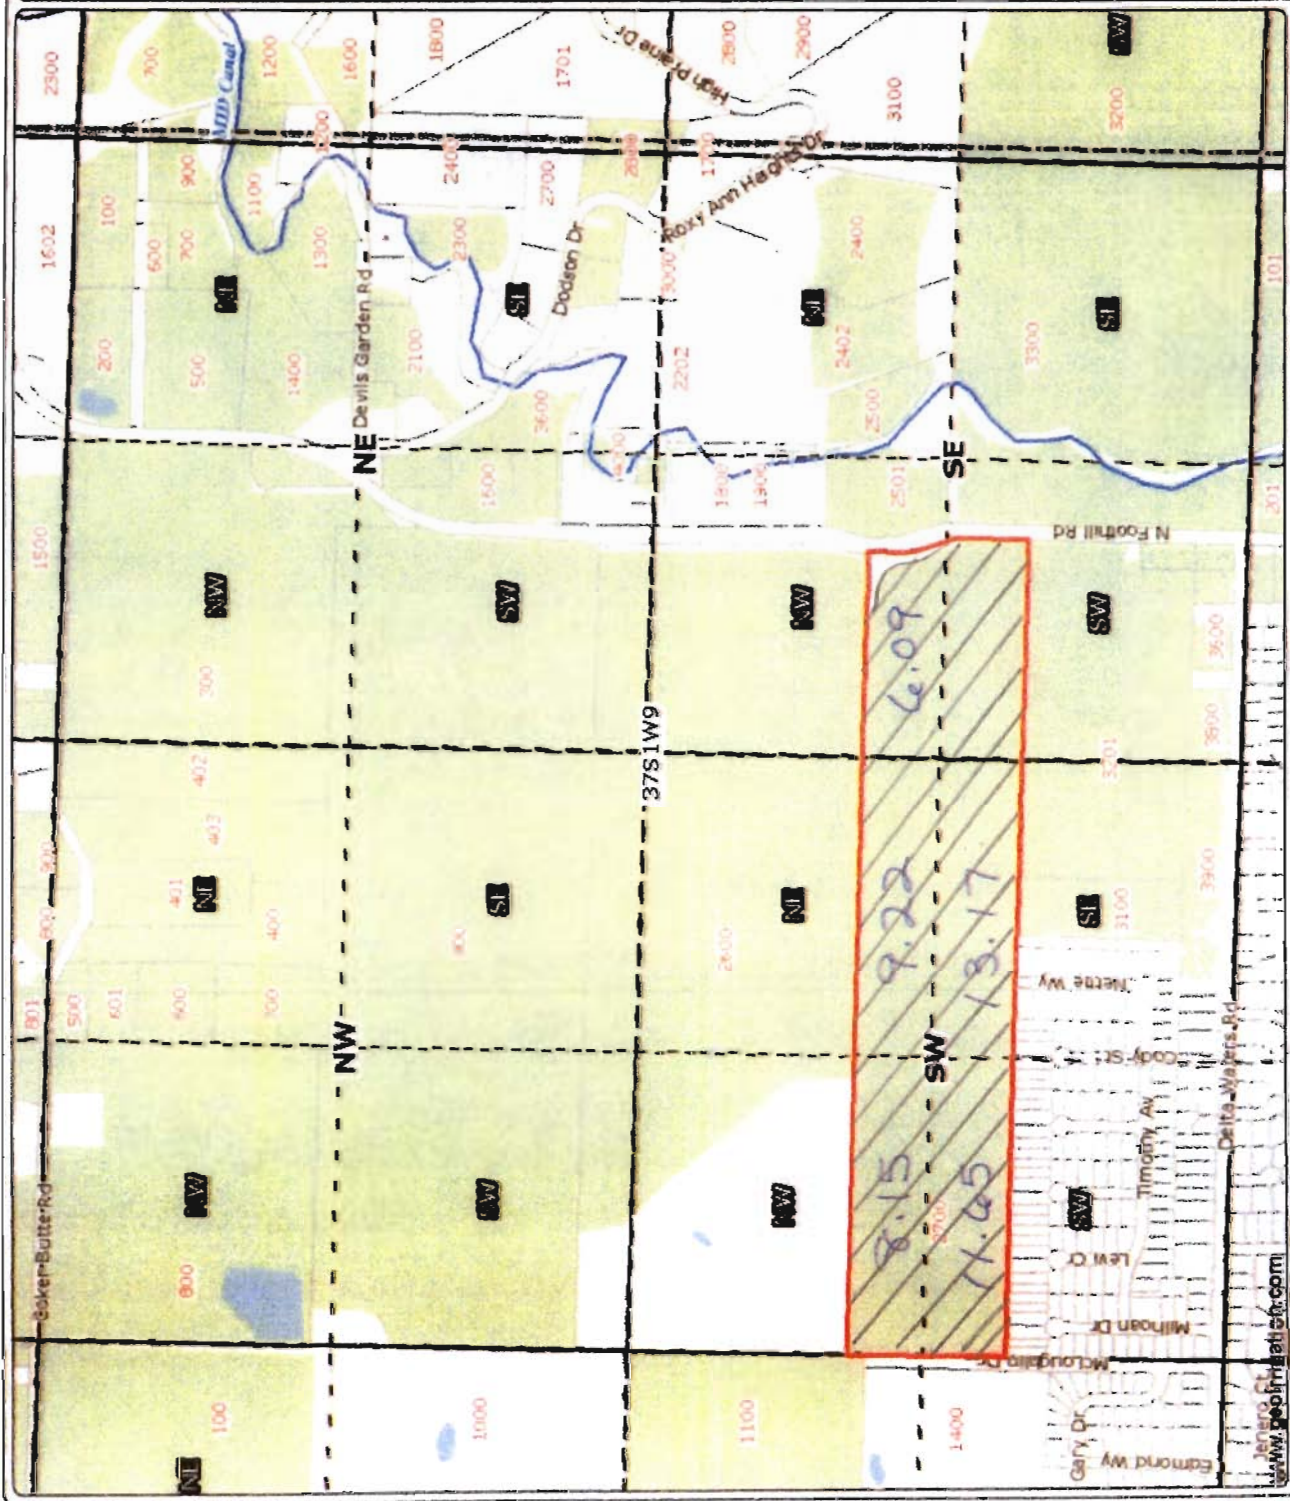

Powered By
geoirrigation

DISCLAIMER: This map is intended for display purposes only and is not intended for any legal representations. There are no warranties, expressed or implied, that accompany this product.

Authorized Place of Use
08-04

06-15 Transfer From:
Medford Irrigation District

37 South, Range 1 West,
Section 9 NWSW & SWSW

- District Boundary USBR
- Road Labels
- Township Range
- Sections
- Section Labels
- Quarters
- Quarter Labels
- Quarter Quarters
- Quarter Quarters Labels
- Lot Labels
- Taxlots
- Waterbodies JACK CO
- Irrigation Ditches JACK CO
- Place of Use WORKING

page 1 of 3 of
TAX LOT 2100.
Transfer from

T 10757

scale 1" = 400.00'
created: 6/14/2006



RECEIVED
DEC 23 2008
WATER RESOURCES DEPT
SALEM, OREGON

NW

SW

8.15

11 6.5

509	512	513	514	515	516	517	400	301	302	303	

DISCLAIMER: This map is intended for display purposes only and is not intended for any legal representations.
There are no warranties, expressed or implied, that accompany this product.

Powered By
geolirrigation

Authorized Place of Use

08-04

Transfer From:
Medford Irrigation District

37 South, Range 1 West,
Section 9 NESW & SESW

- District Boundary USBR
- Road Labels
- Township Range
- Sections
- Section Labels
- Quarters
- Quarter Labels
- Quarter Quarters
- Quarter Quarters Labels
- Lot Labels
- Taxlots
- Waterbodies JACK CO
- Irrigation Ditches JACK CO
- Place of Use WORKING

page 2 of 3
of Tax Lot
2700

Transfer From

T 10757


scale 1" = 400.00'
created: 6/14/2006



RECEIVED
DEC 23 2008
WATER RESOURCES DEPT
SALEM, OREGON

Powered By
geotirrigation

DISCLAIMER: This map is intended for display purposes only and is not intended for any legal representations.
There are no warranties, expressed or implied, that accompany this product.

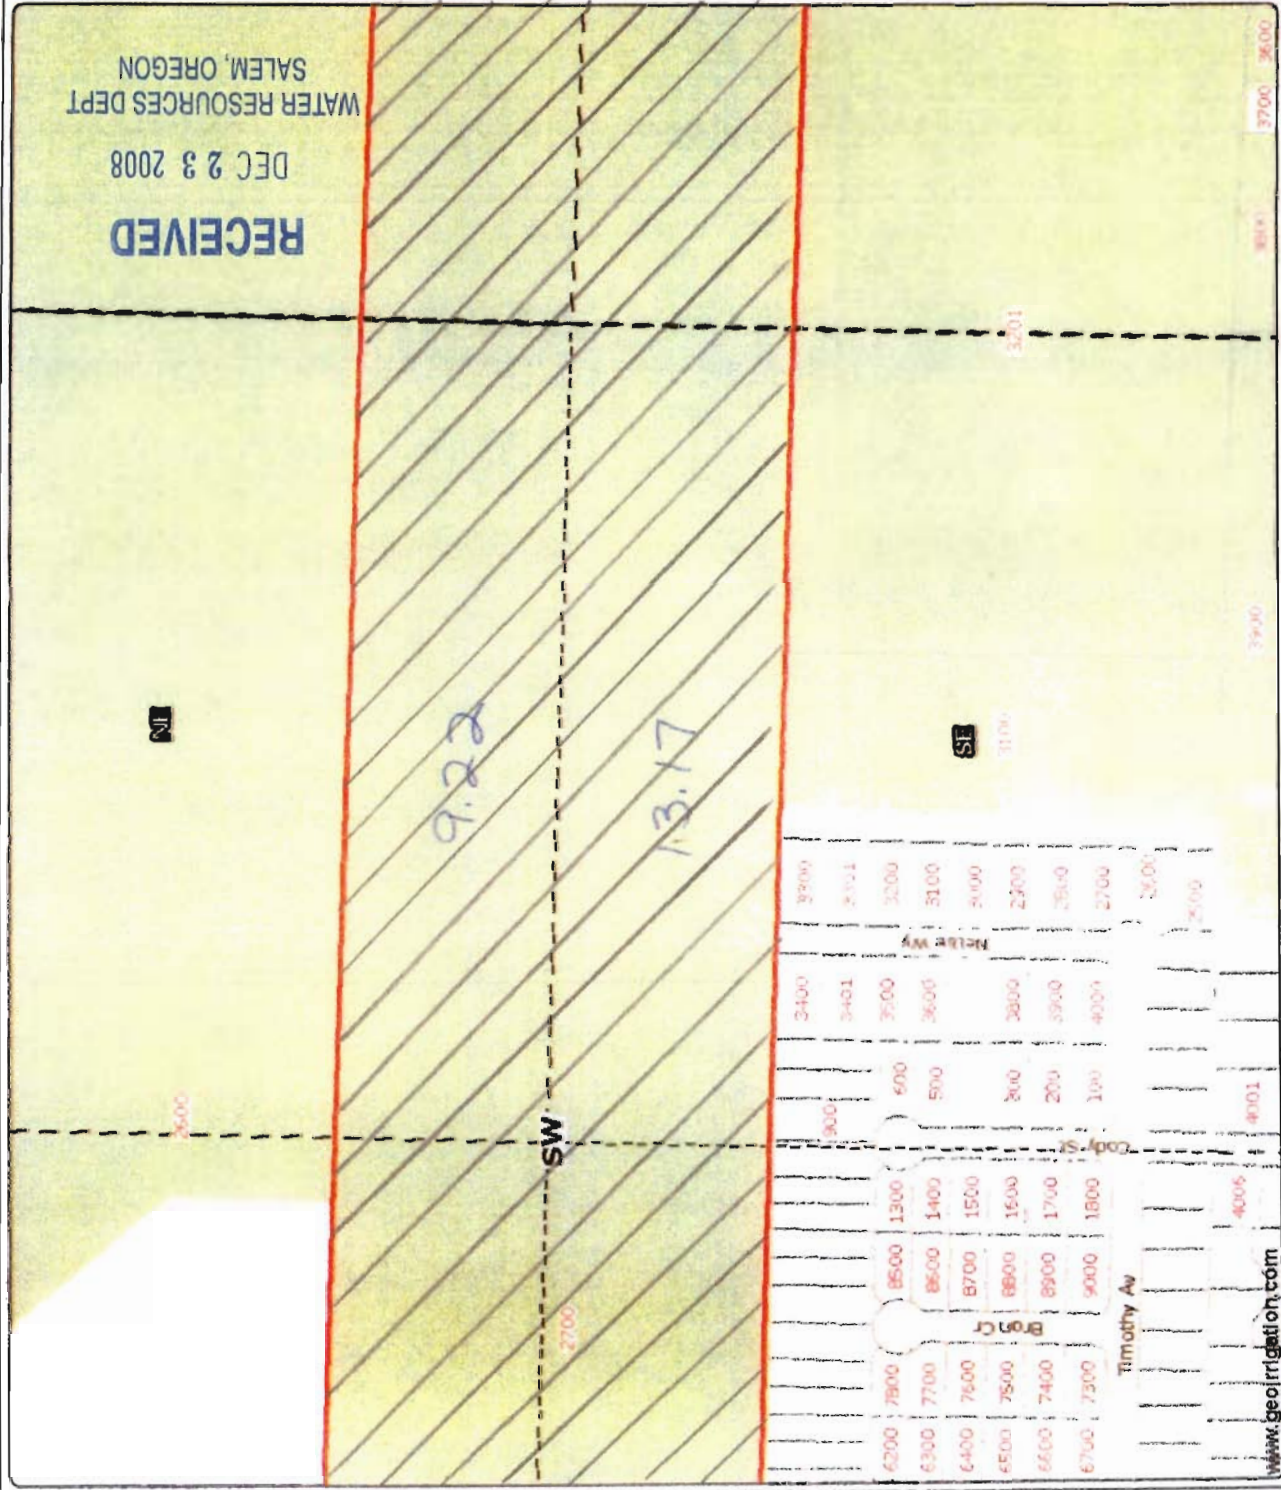

08-04
 Transfer From:
 Medford Irrigation District

37 South, Range 1 West,
 Section 9 NWSE & SWSE

2700


- District Boundary USBR
- Road Labels
- Township Range
- Sections
- Section Labels
- Quarters
- Quarter Labels
- Quarter Quarters
- Quarter Quarters Labels
- Lot Labels
- Taxlots
- Waterfodies JACK CO
- Irrigation Ditches JACK CO
- Place of Use WORKING

page 3 of 3
of Tax Lot
2700

Transfer From

T 10757

scale 1" = 400.00'
created: 6/14/2006

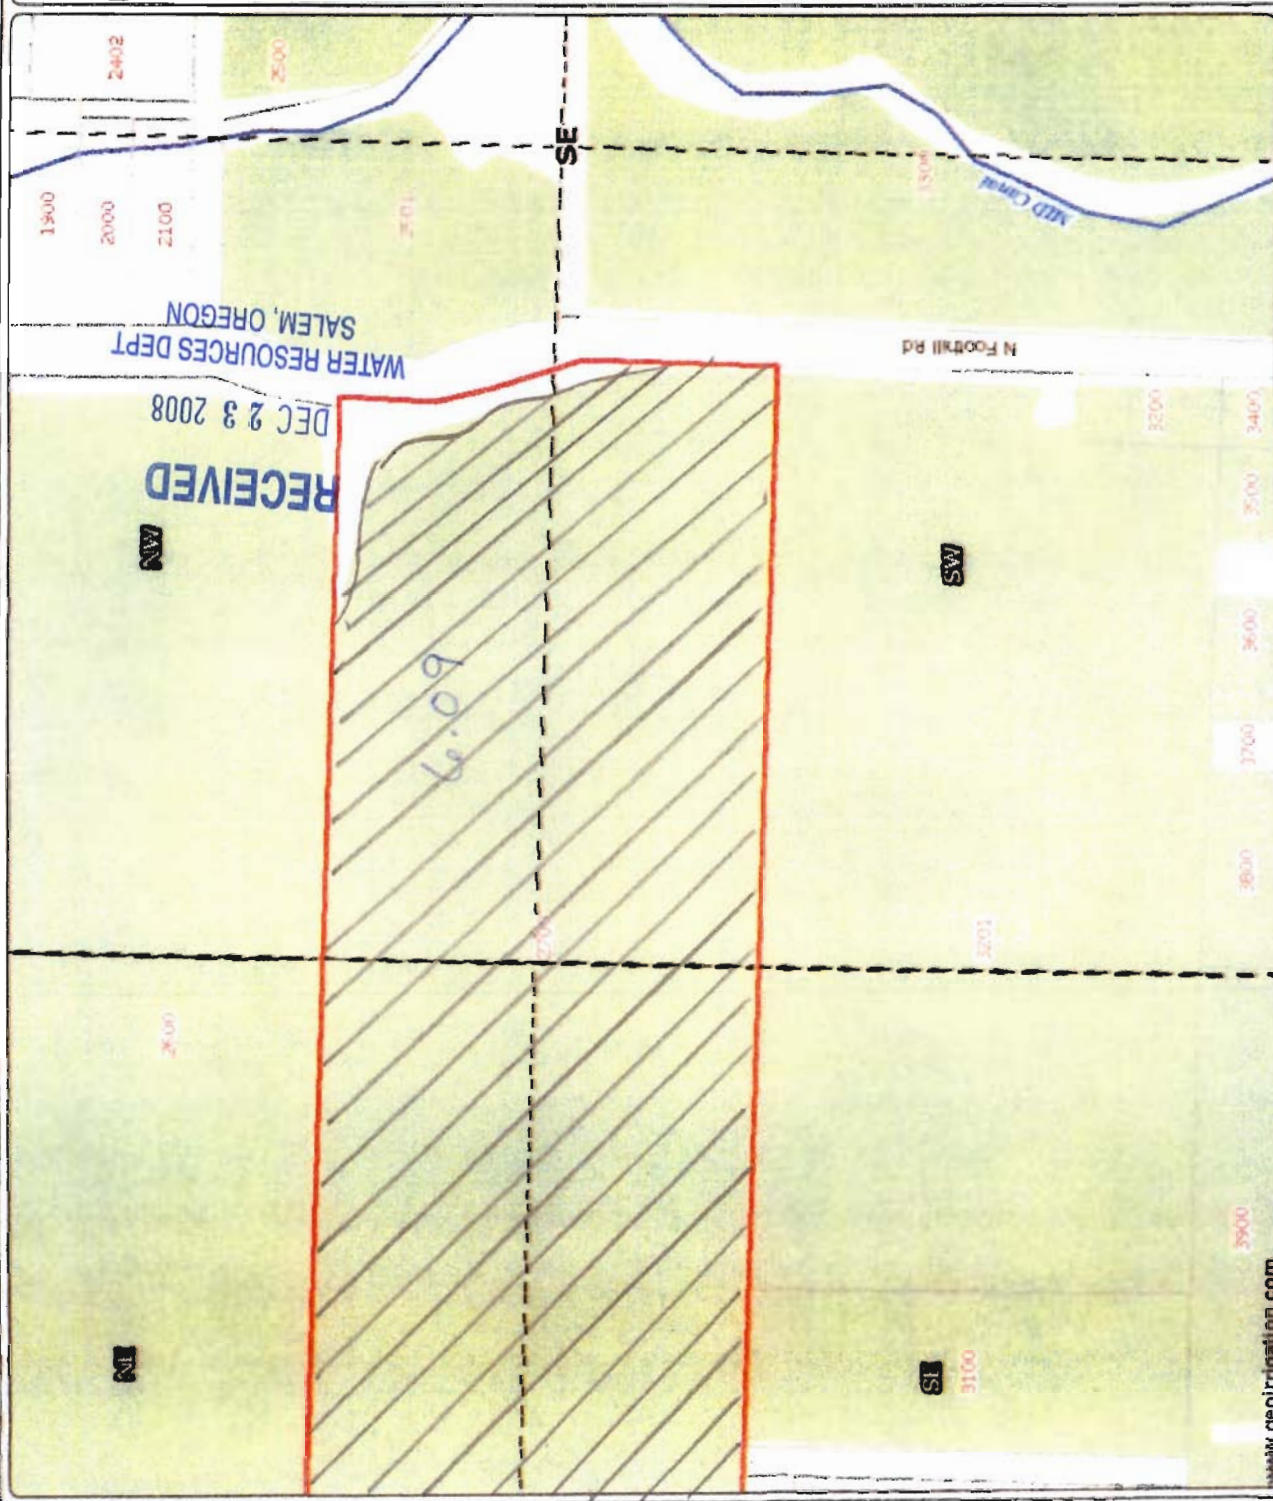

Powered By
geoirrigation

DISCLAIMER: This map is intended for display purposes only and is not intended for any legal representations. There are no warranties, expressed or implied, that accompany this product.

www.geoirrigation.com

Proposed Place of Use

08-04

Medford Irrigation District

Proposed Place of Use
Elliott

361E tax lot 12900
48 ac

- District Boundary USBR
- County Boundary
- Road Labels
- Township Range
- Sections
- Section Labels
- Quarters
- Quarter Labels
- Quarter Quarters
- Quarter Quarters Labels
- Taxlots
- Rivers JACK CO
- Waterbodies JACK CO
- Irrigation Ditches JACK CO
- RVCOD Laterals
- Water Rights OLD
- Water Rights NEW


Proposed Ac.
To irrigate

Irrigated Ac.

T 10757



Scale 1" = 900'
Created: 6/5/2008

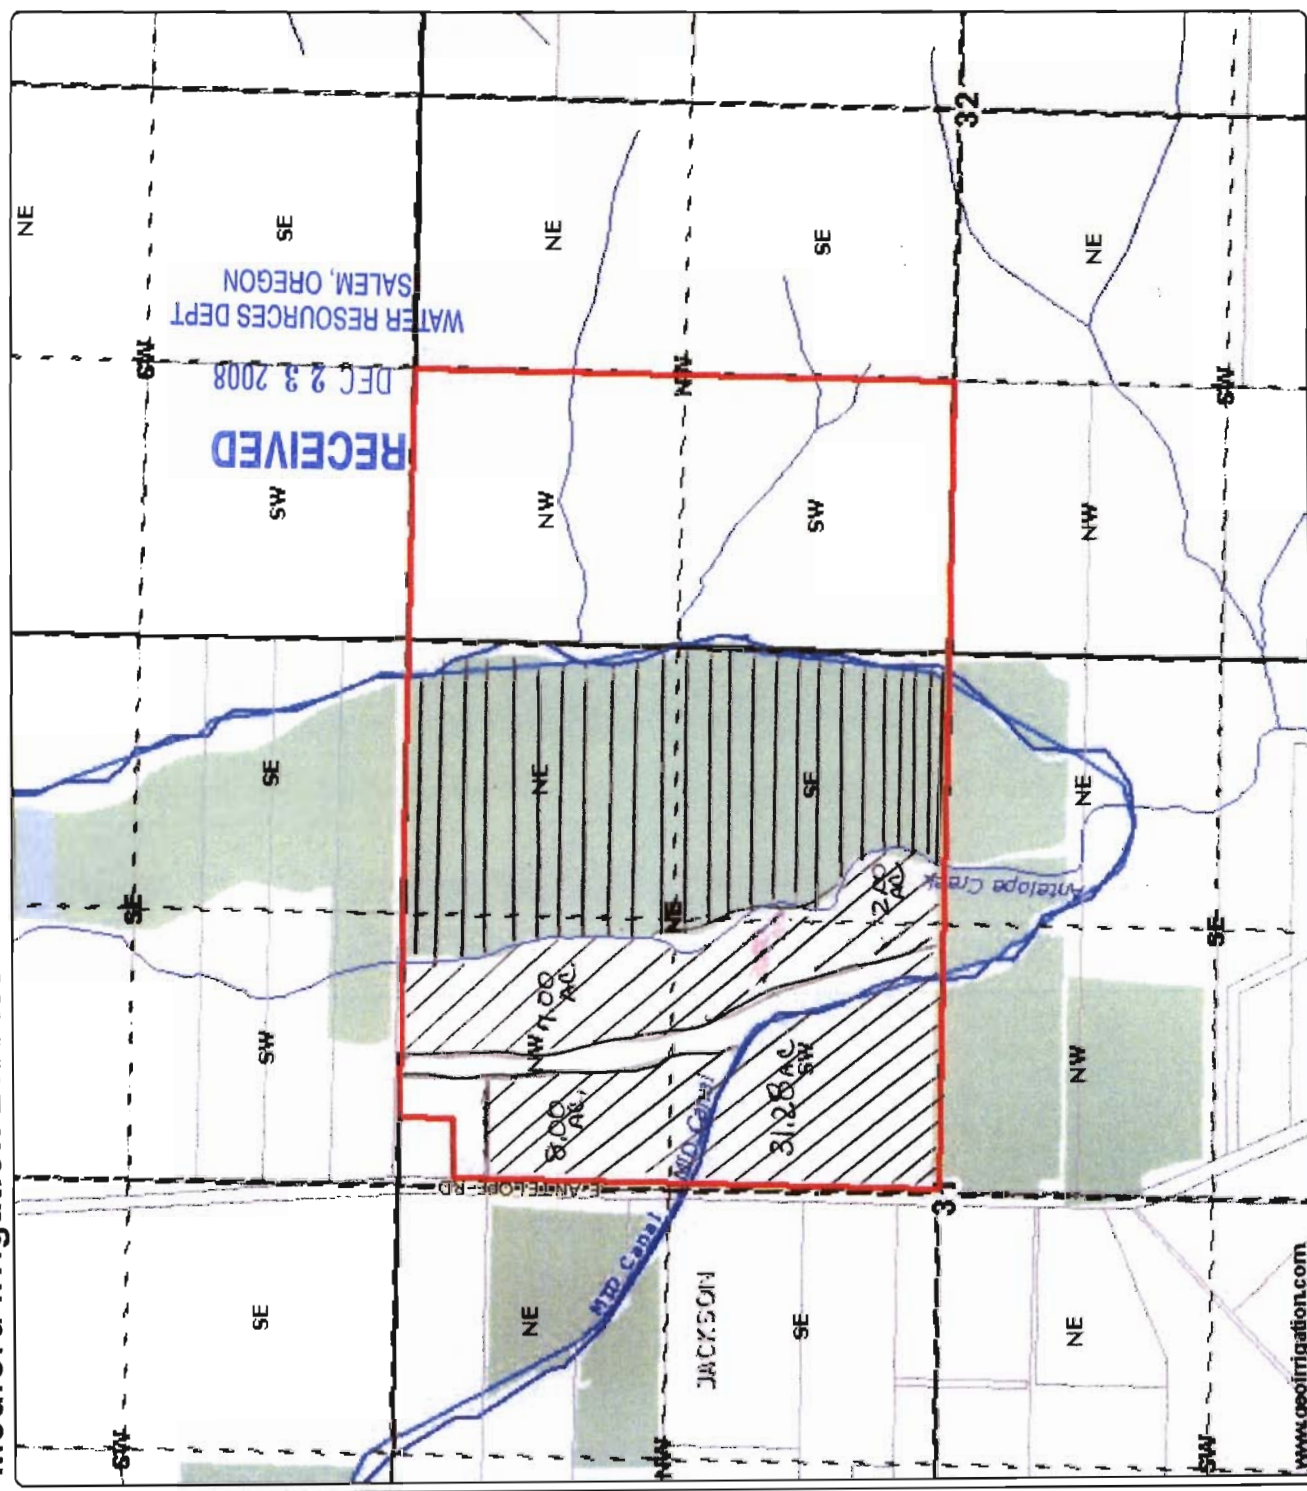

DISCLAIMER: This map is intended for display purposes only and is not intended for any legal representations. There are no warranties, expressed or implied, that accompany this product.

Proposed Place of Use

08-04


Transfer To:
ELLIOTT

36-1E Tax Lot 12900 15.00
Acres Section 31 NWNE

15.0 Acres


- District Boundary USBR
- Road Labels
- Township Range
- Sections
- Section Labels
- Quarters
- Quarter Labels
- Quarter Quarters
- Quarter Quarters Labels
- Lot Labels
- Taxlots
- Waterodies JACK CO
- Irrigation Ditches JACK CO
- Place of Use WORKING

page 1 of 3

 Proposed Ac
To Investigate.

T 10757

scale 1" = 400.00'
created: 4/28/2006

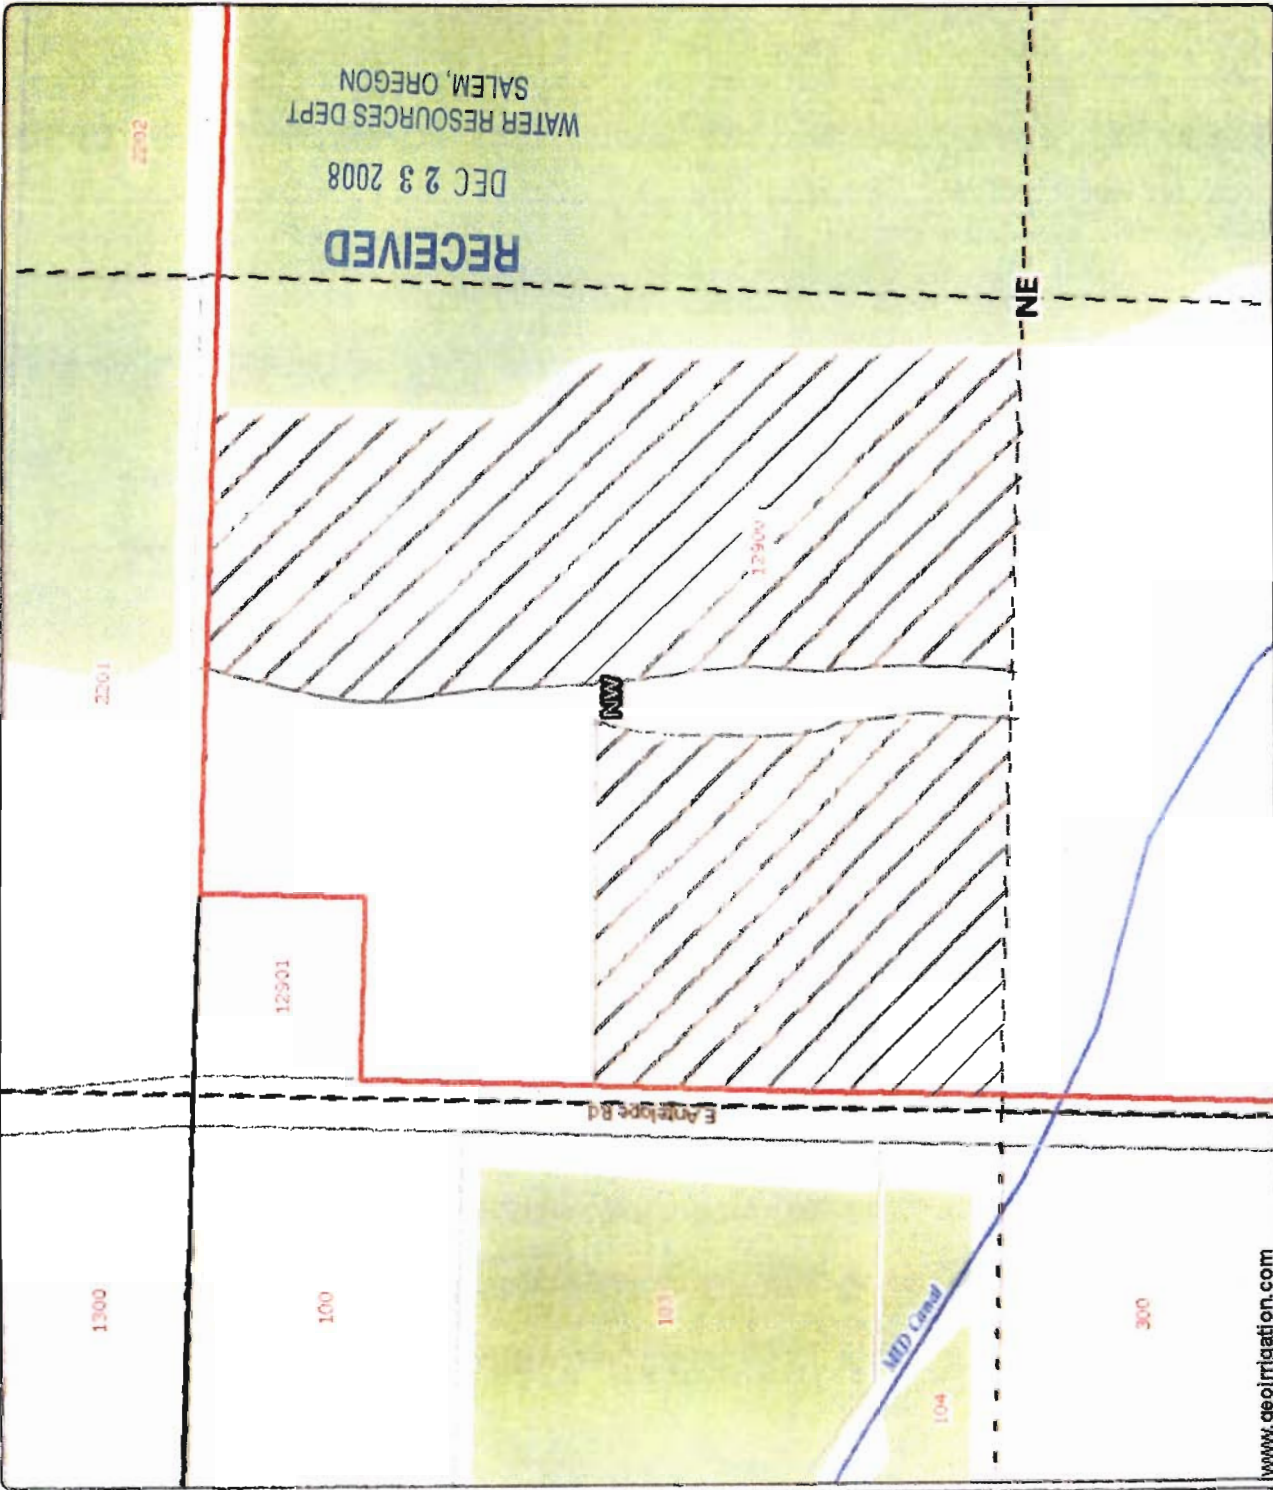

Powered By
geoirrigation

DISCLAIMER: This map is intended for display purposes only and is not intended for any legal representations. There are no warranties, expressed or implied, that accompany this product.

www.geoirrigation.com

Proposed Place of Use
08.04

~~06-43~~

Transfer To:
ELLIOTT

36-1E Tax Lot 12900 31.00
Acres Section 31 SWNE

31.28 Acres

- District Boundary USBR
- Road Labels
- Township Range
- Sections
- Section Labels
- Quarters
- Quarter Labels
- Quarter Quarters
- Quarter Quarters Labels
- Lot Labels
- Texts
- Waterbodies JACK CO
- Irrigation Ditches JACK CO
- Place of Use WORKING


page 2 of 3

Proposed Place of Use.

T 10757



scale 1" = 400.00'
created: 4/28/2006

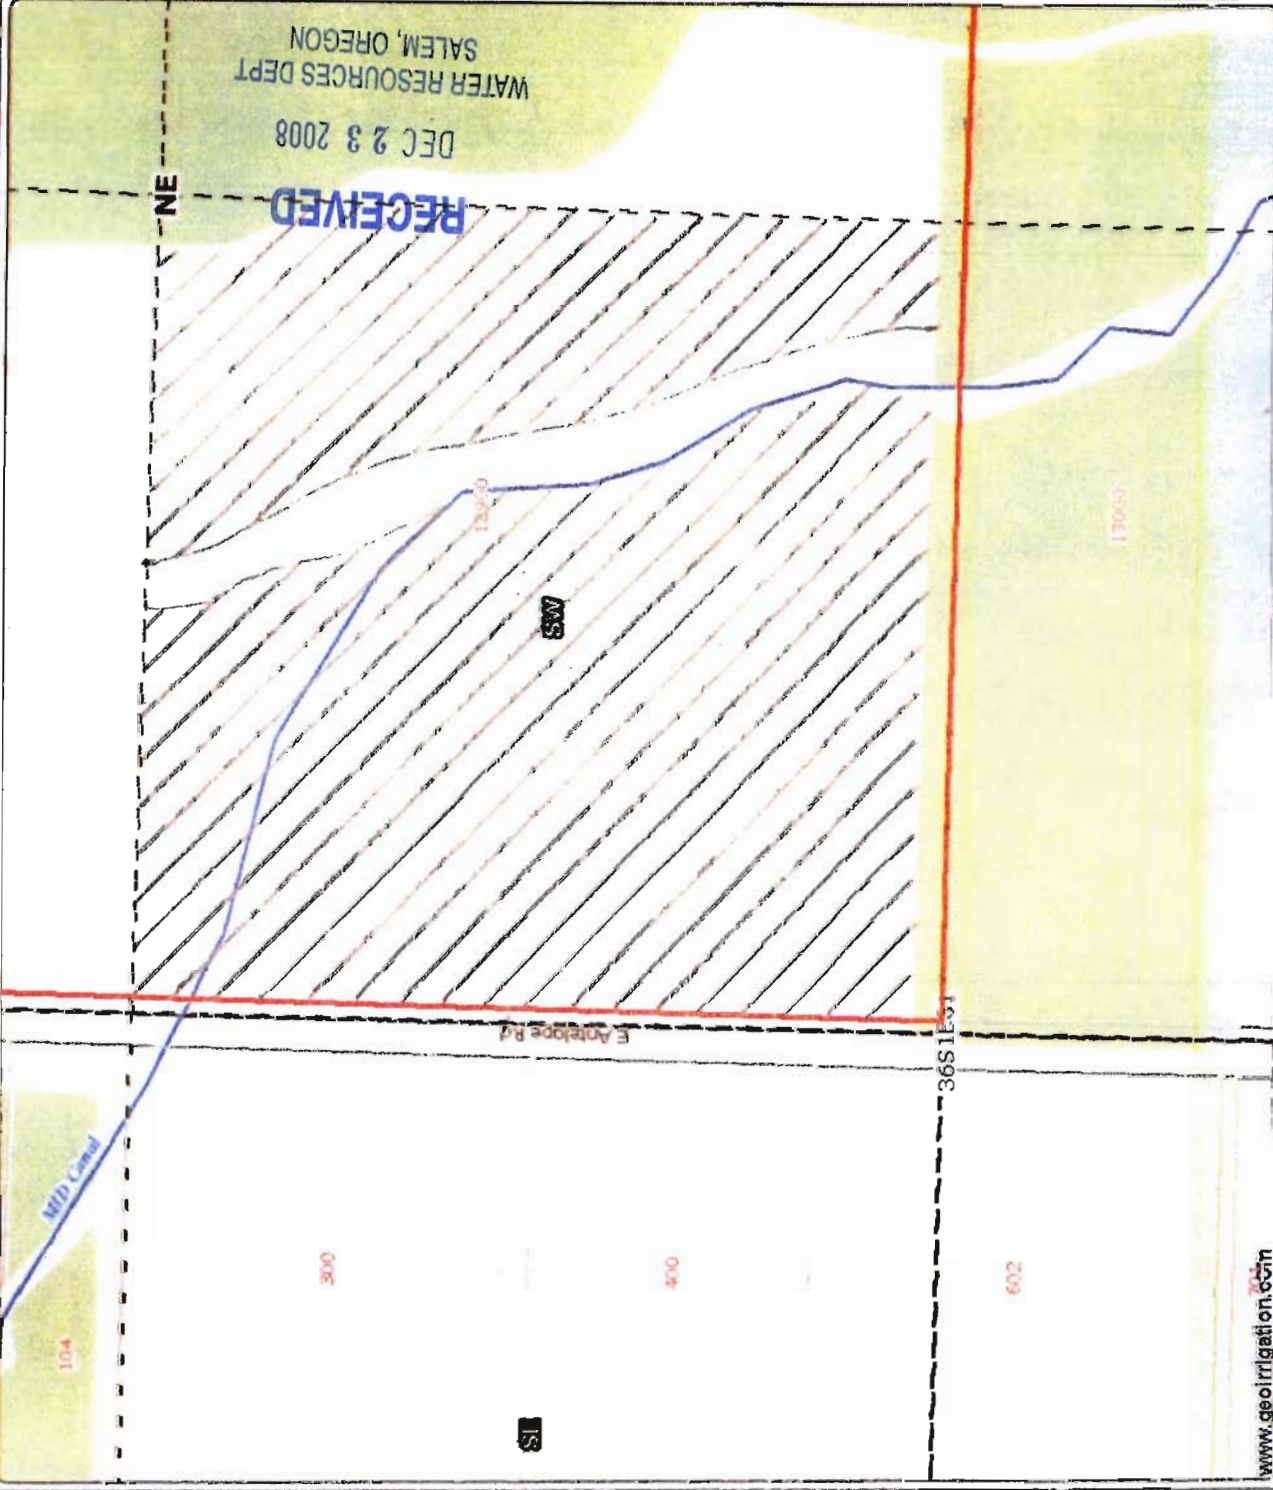

Powered By
geolirrigation

DISCLAIMER: This map is intended for display purposes only and is not intended for any legal representations. There are no warranties, expressed or implied, that accompany this product.

www.geolirrigation.com

Proposed Placed of Use
08-04

06-15

Transfer To:
ELLIOTT

36-1E Tax Lot 12900 (Section
31) 2.00 Acres SENE

2.0 Acres

- District Boundary USBR
- Road Labels
- Township Range
- Sections
- Section Labels
- Quarters
- Quarter Labels
- Quarter Quarters
- Quarter Quarters Labels
- Lot Labels
- Taxlots
- Waterbodies JACK CO
- Irrigation Ditches JACK CO
- Place of Use WORKING

page 3 of 3


Proposed
Place
of
Use

110757



scale 1" = 400.00'
created: 4/28/2006

RECEIVED
DEC 23 2008
WATER RESOURCES DEPT
SALEM, OREGON

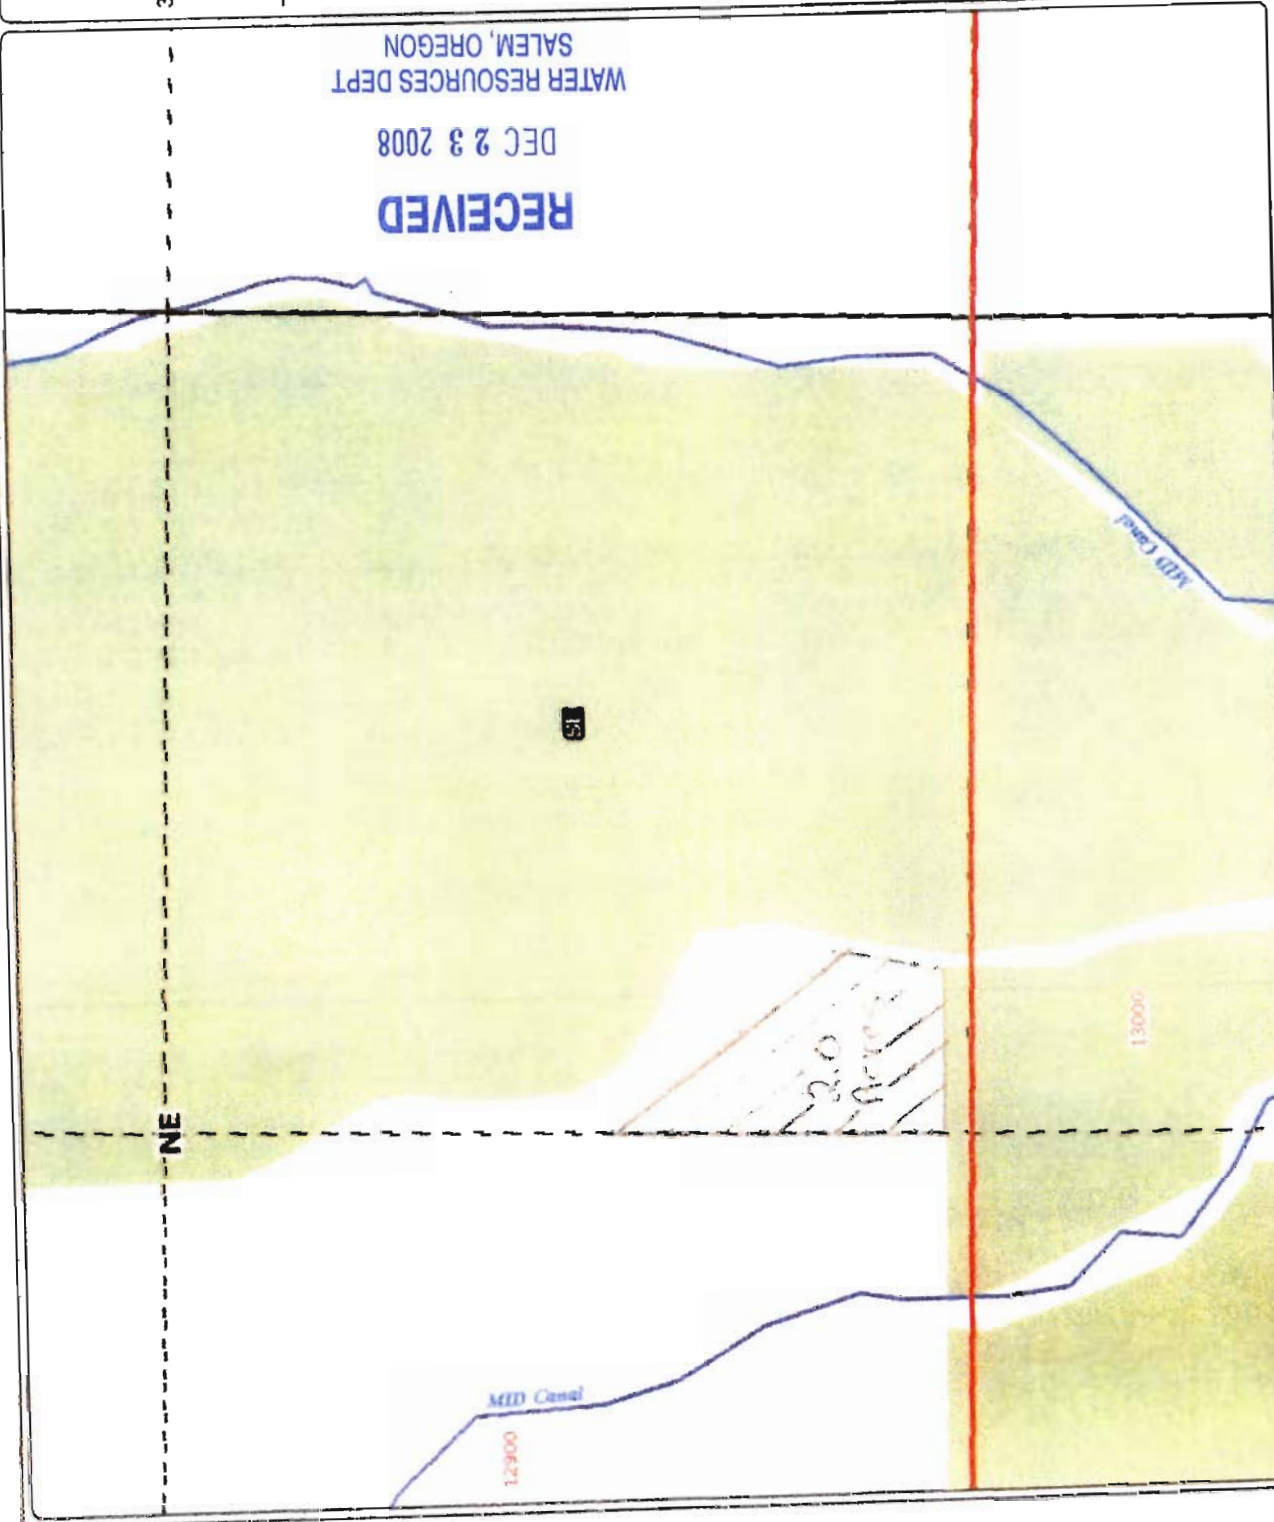

Powered By
geotirrigation

DISCLAIMER: This map is intended for display purposes only and is not intended for any legal representations.
There are no warranties, expressed or implied, that accompany this product.

www.geotirrigation.com

Authorized Place of Use
08-05

06-13 Transfer From:
Medford Irrigation District

37 South, Range 2 West,
Section 26

Tax Lots # 2600,
2000, 2800

- District Boundary USBR
- Road Labels
- Township Range
- Sections
- Section Labels
- Quarters
- Quarter Labels
- Quarter Quarters
- Quarter Quarters Labels
- Lot Labels
- Taxlots
- Waterfloods JACK CO
- Irrigation Ditches JACK CO
- Place of Use WORKING

Transfer From

26 Section

10757



scale 1" = 1,320.00'
created: 6/14/2008



Powered By
geoinformation

DISCLAIMER: This map is intended for display purposes only and is not intended for any legal representations. There are no warranties, expressed or implied, that accompany this product.

Authorized Place of Use
08-05

**66-13 Transfer From:
Medford Irrigation District**


37 South, Range 2 West,
Section 26 NWSE & SESE

- District Boundary USBR
- Road Labels
- Township Range
- Sections
- Section Labels
- Quarters
- Quarter Labels
- Quarter Quarters
- Quarter Quarters Labels
- Lot Labels
- Taxlots
- Waterbodies JACK CO
- Irrigation Ditches JACK CO
- Place of Use WORKING

Transfer From
 # 2600 = 1.21 AC
 # 2000 = .34 AC
 # 2800 = .48 AC
 Total 1.03 AC

10757

scale 1" = 400.00'
created: 6/14/2006

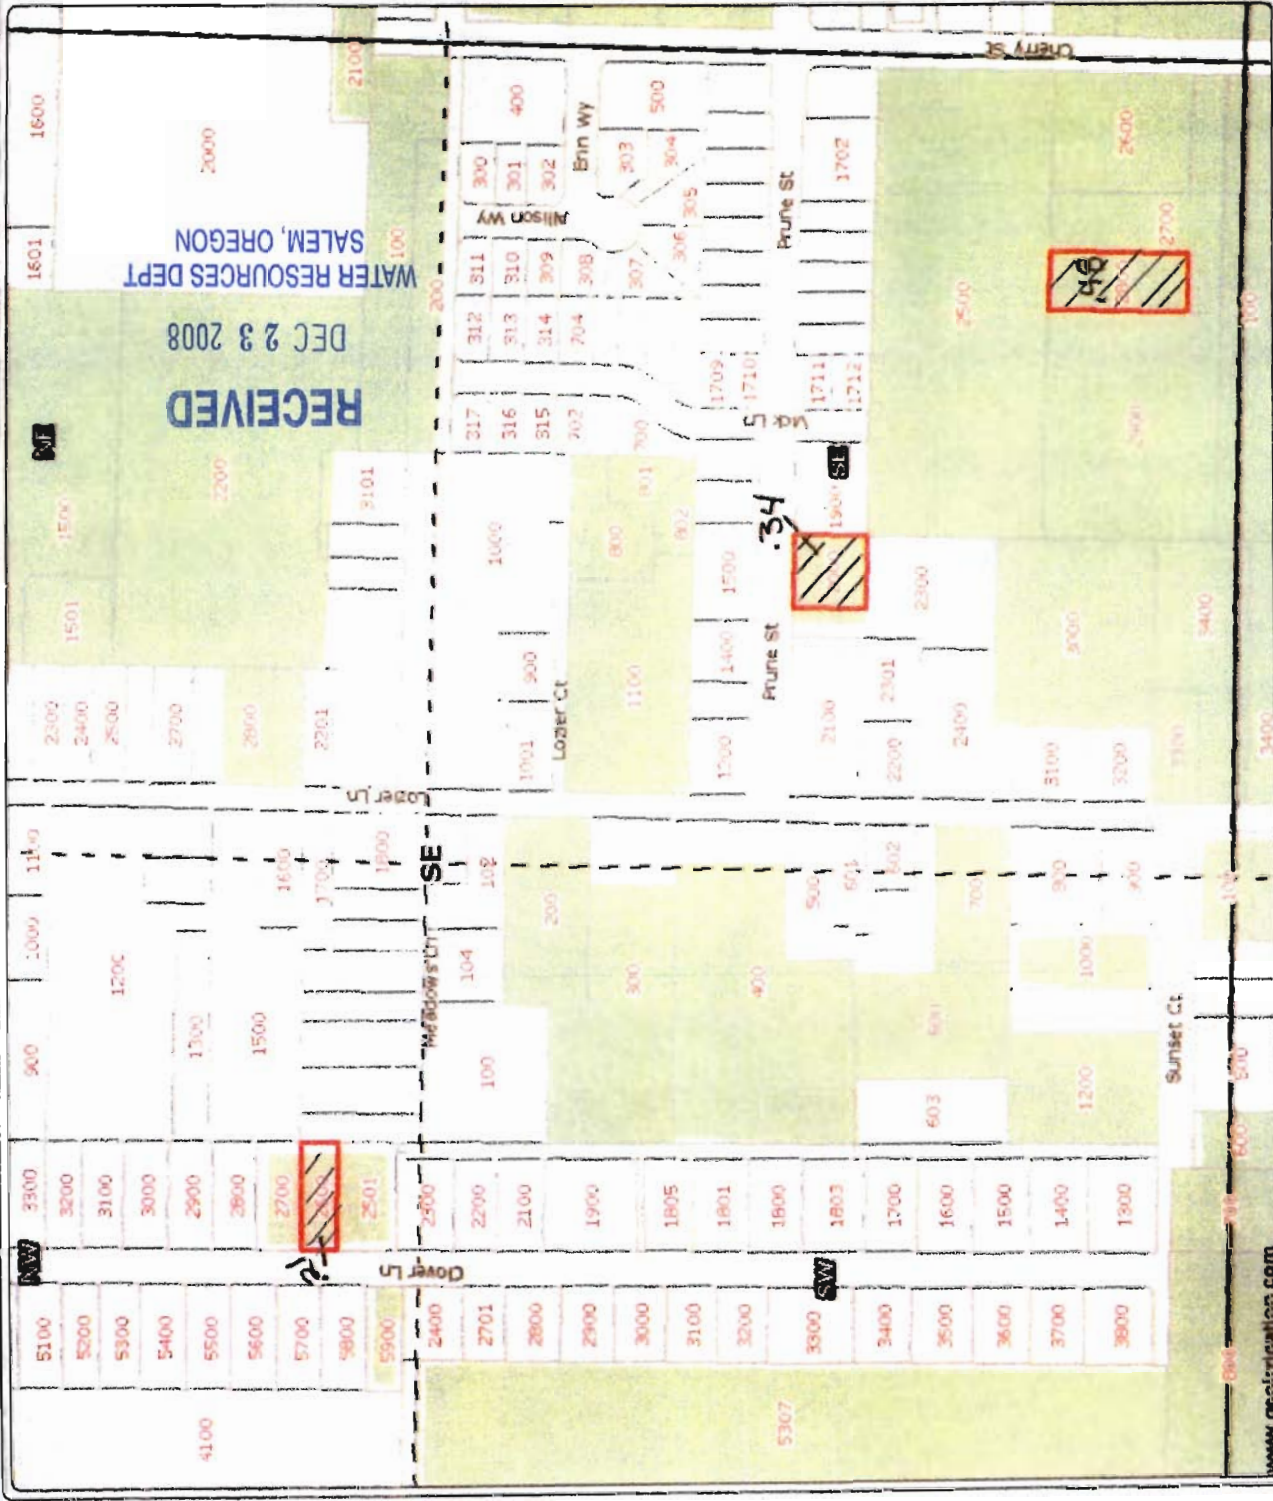

Powered By
geoirrigation

DISCLAIMER: This map is intended for display purposes only and is not intended for any legal representations. There are no warranties, expressed or implied, that accompany this product.

www.geoirrigation.com

Proposed Place of Use.
08.05


**06-13 Transfer To:
Anderberg**
37 South, Range 2 West,
Section 33 #800 NWSE

- District Boundary USBR
- Road Labels
- Township Range
- Section Labels
- Quarters
- Quarter Labels
- Quarter Quarters
- Quarter Quarters Labels
- Lot Labels
- Taxlots
- Waterbodies JACK CO
- Irrigation Ditches JACK CO
- Place of Use WORKING

Proposed Place of Use.
1.03 A.C.

10757

scale 1" = 400.00'
created: 6/14/2006

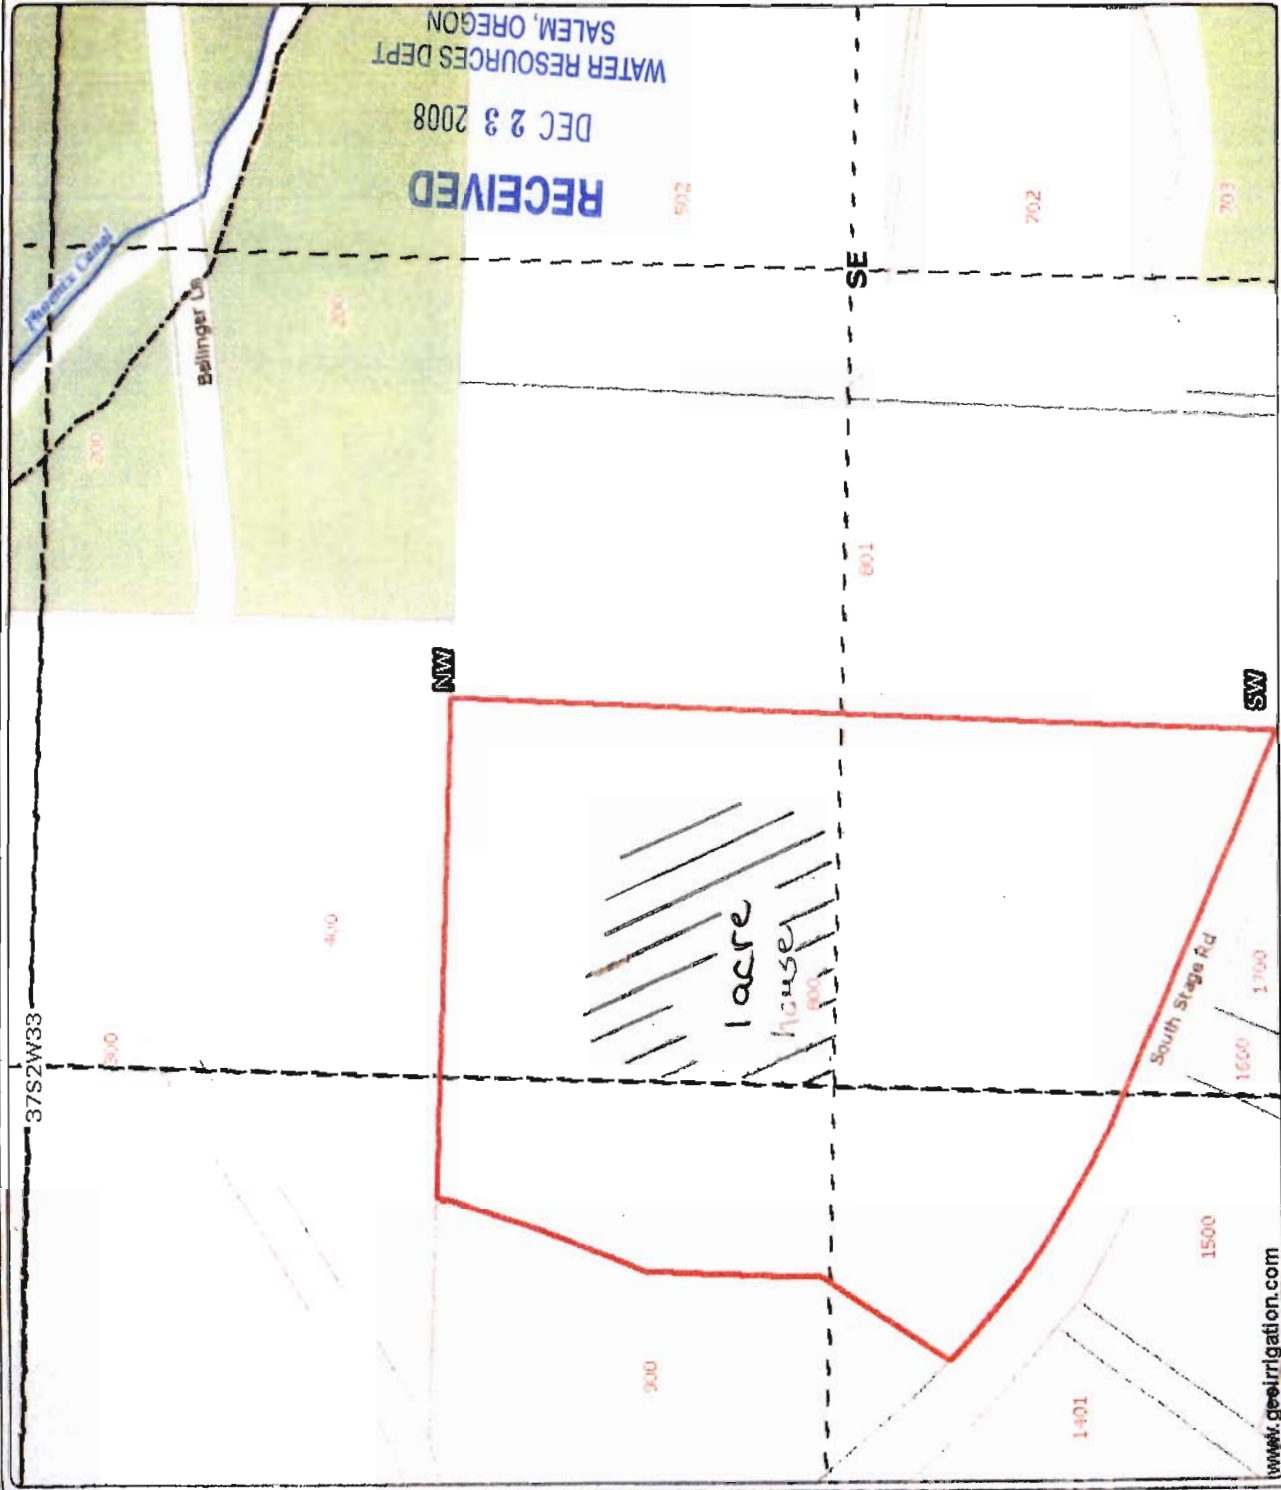

Powered By
geoirrigation

DISCLAIMER: This map is intended for display purposes only and is not intended for any legal representations. There are no warranties, expressed or implied, that accompany this product.

www.geoirrigation.com

Proposed Place of Use
08-06


Transfer To:
TURNER
37S 2W 17 TL 3603
3.73 ac

- District Boundary User
- Road Labels
- Township Range
- Sections
- Section Labels
- Quarters
- Quarter Labels
- Quarter Quarters
- Quarter Quarters Labels
- Lot Labels
- Tallots
- Waterpodies JACK CO
- Irrigation Ditches JACK CO
- RV/COG Laterals
- Place of Use WORKING

Proposed Place of Use
under irrigation

T 10757

scale 1" = 400.00'
created: 3/24/2006

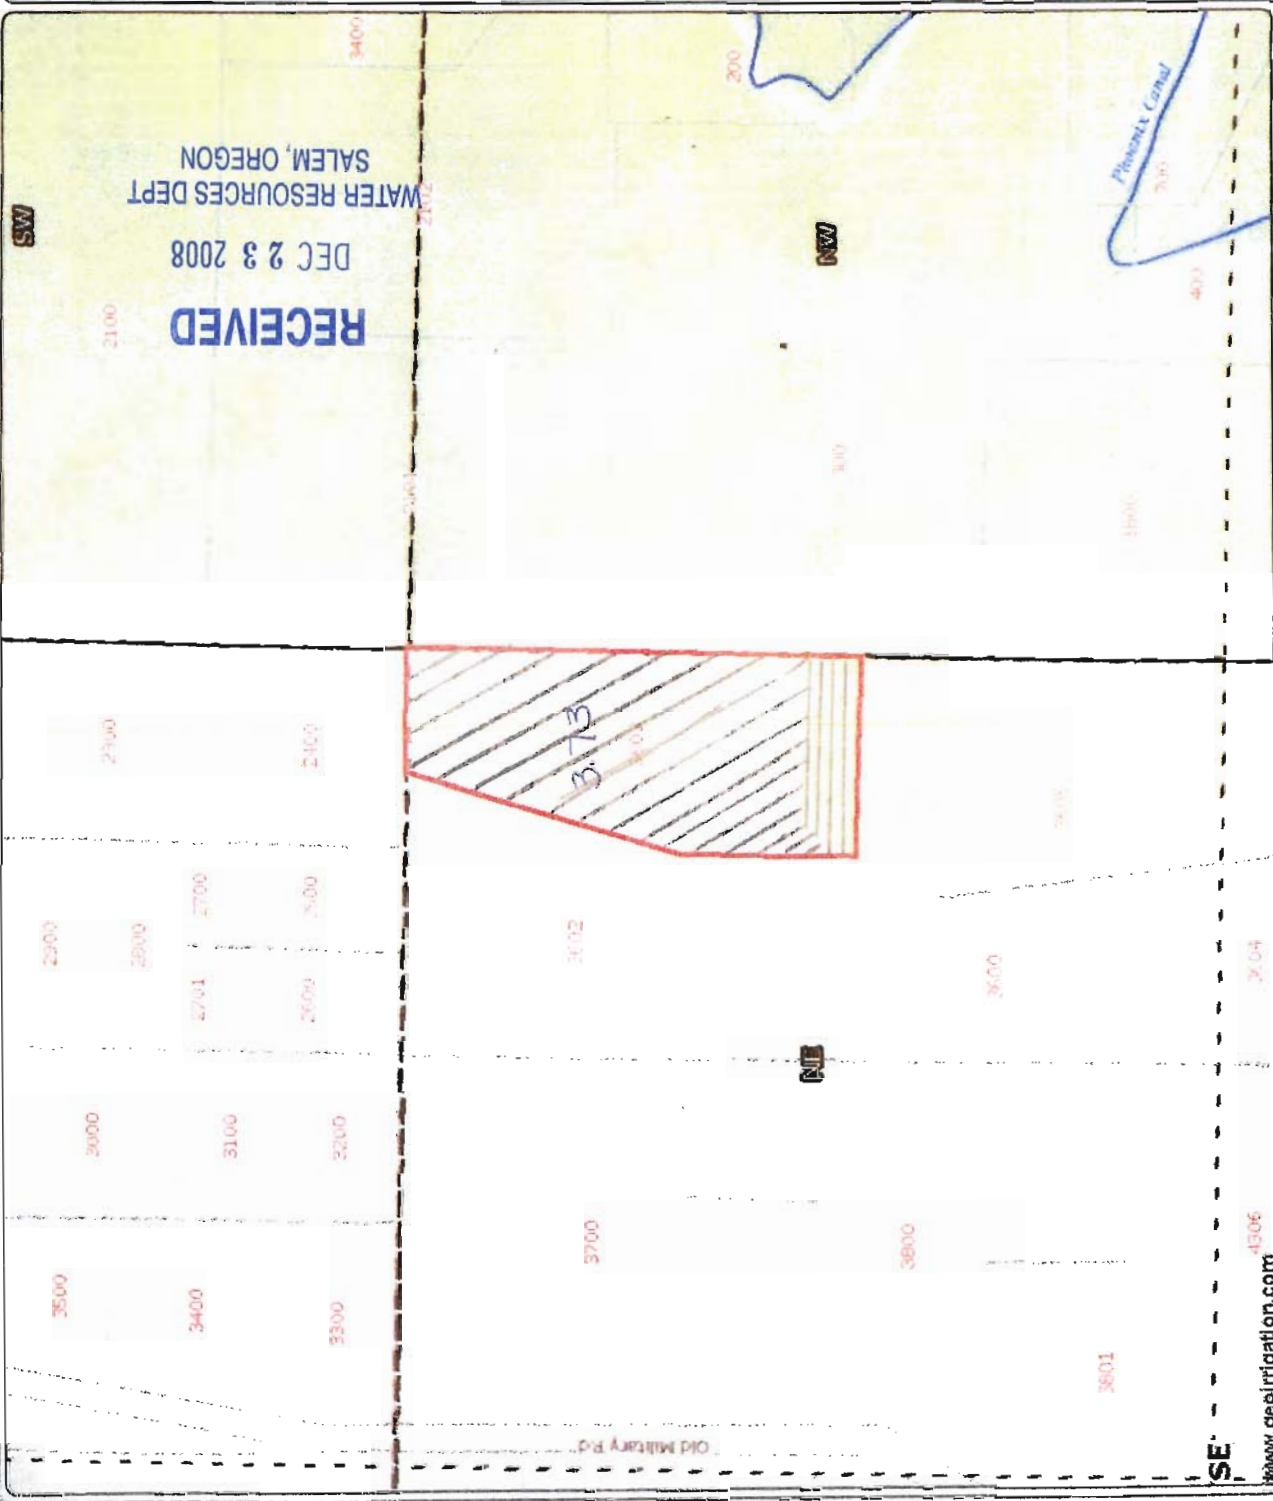

Powered By
georrigation

DISCLAIMER: This map is intended for display purposes only and is not intended for any legal representations. There are no warranties, expressed or implied, that accompany this product.

www.georrigation.com

Authorized Place of Use
08-06

Transfer From:
Jirsa

37S 2W 26 NWNE 2.65 Acres
& NENE .78 Acres

Tax Lot 700
Before Divided


- District Boundary USBR
- Road Labels
- Township Range
- Sections
- Section Labels
- Quarters
- Quarter Labels
- Quarter Quarters
- Quarter Quarters Labels
- Lot Labels
- Taxlots
- Waterbodies JACK CO
- Irrigation Ditches JACK CO
- Place of Use WORKING

Transfer From

RECEIVED
DEC 23 2008
WATER RESOURCES DEPT
SALEM, OREGON
1 10757



scale 1" = 400.00'
created: 3/29/2006

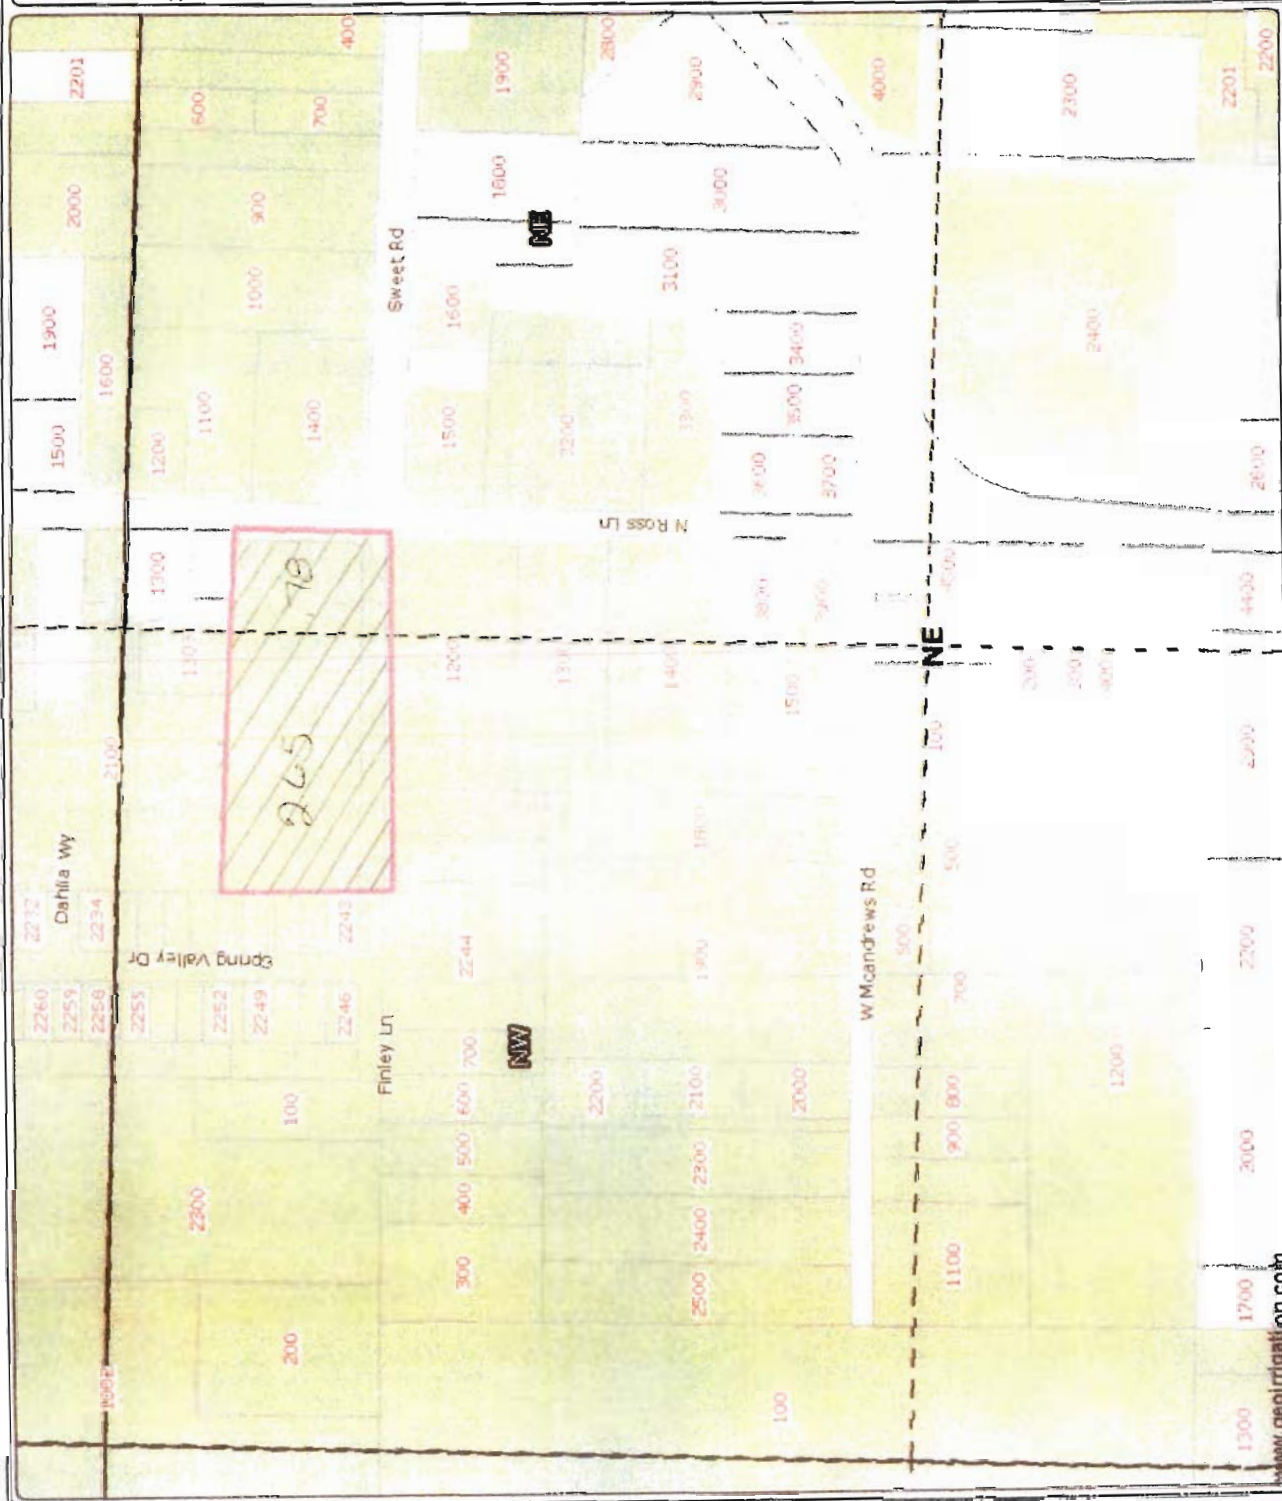

Powered By
geolrrigation

DISCLAIMER: This map is intended for display purposes only and is not intended for any legal representations. There are no warranties, expressed or implied, that accompany this product.

www.geolrrigation.com

Authorized Place DfU Use

08-06 Transfer From:
 37S 2W 23 NESE
 0.16 & 0.15 Acres
 Tract # 5000,
 5100

- District Boundary USBR
- Road Labels
- Township Range
- Sections
- Section Labels
- Quarters
- Quarter Labels
- Quarter Quarters
- Quarter Quarters Labels
- Lot Labels
- Taxlots
- Waterodies JACK CO
- Irrigation Ditches JACK CO
- Place of Use WORKING

Transfer OFF

1615


RECEIVED
 DEC 23 2008

WATER RESOURCES DEPT.
 SALEM, OREGON

T 10757



scale 1" = 400.00'
 created: 3/29/2006

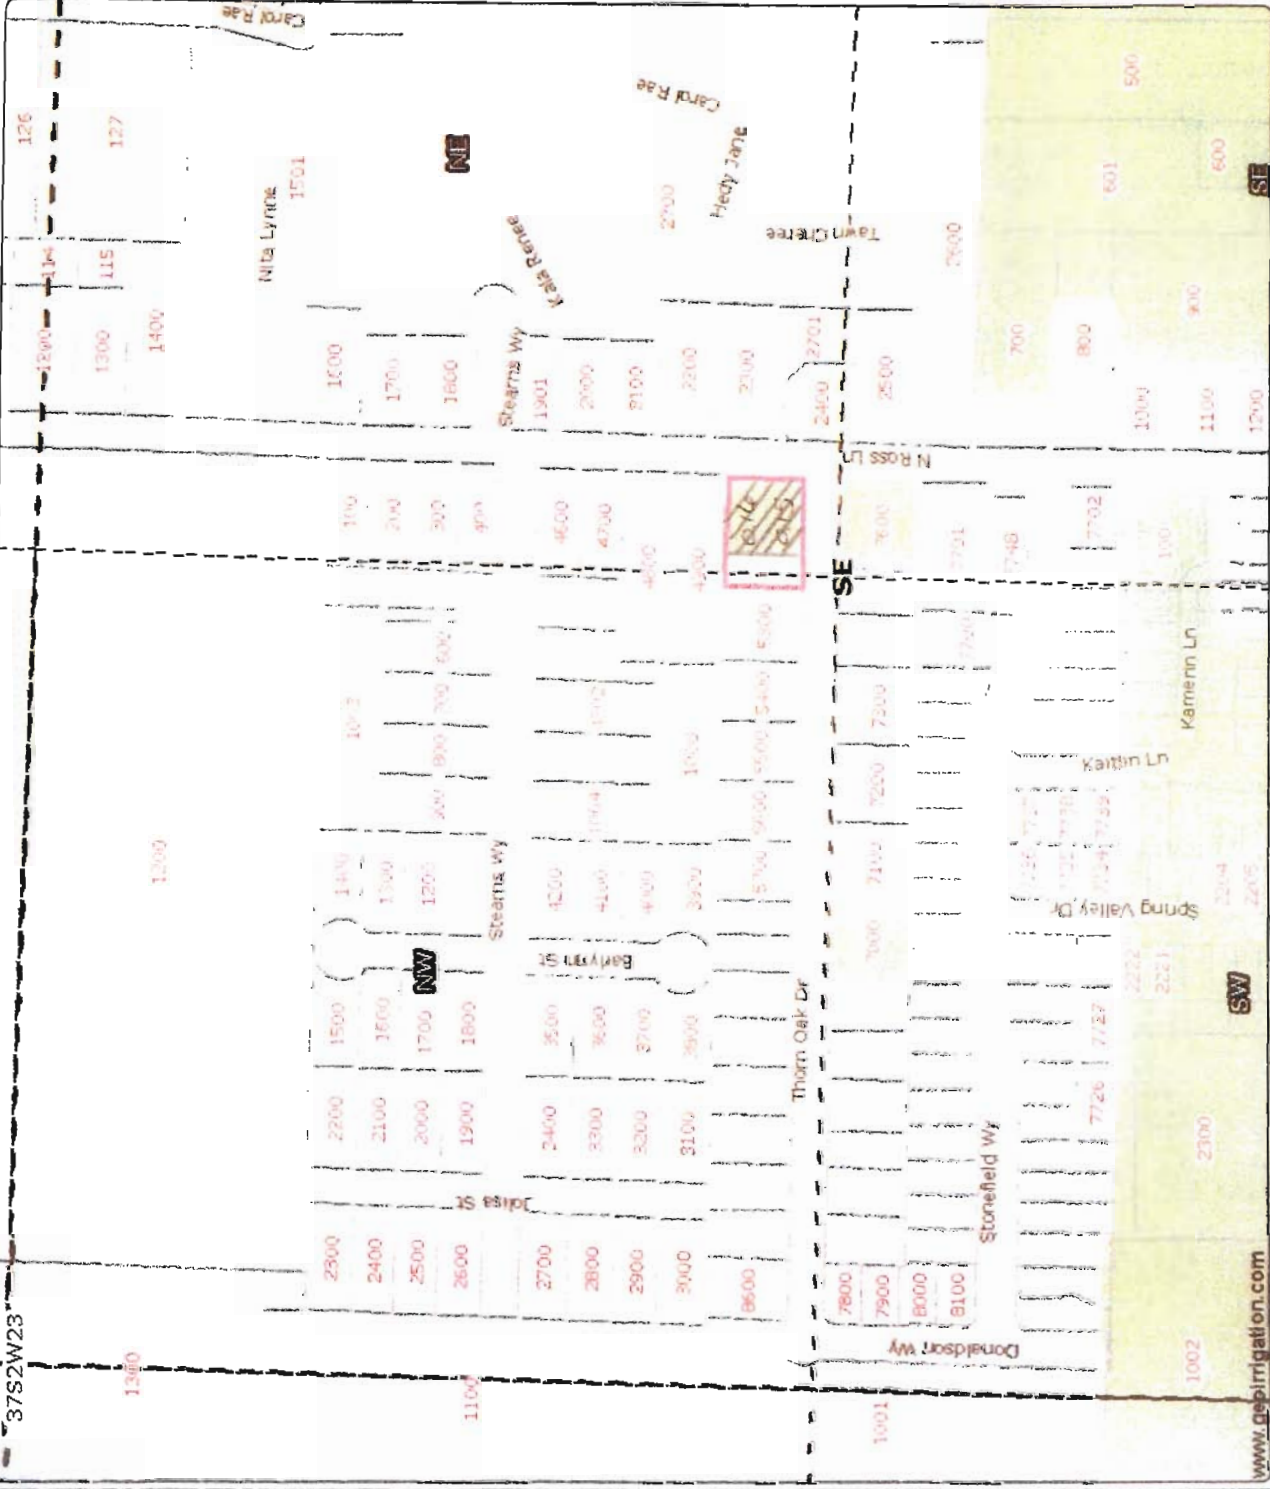

Powered By
 geoirrigation

DISCLAIMER: This map is intended for display purposes only and is not intended for any legal representations.
 There are no warranties, expressed or implied, that accompany this product.

www.geoirrigation.com

Proposed Place of Use

0807

Transfer To:
MALOT

37S 2W 17 TL 3602
NESE


- District Boundary USBR
- Road Labels
- Township Range
- Sections
- Section Labels
- Quarters
- Quarter Labels
- Quarter Quarters
- Quarter Quarters Labels
- Lot Labels
- Taxlots
- Waterbodies JACK CO
- Irrigation Ditches JACK CO
- RVCOG Laterals
- Place of Use WORKING

4.5 irr. acc.

1 10767



scale 1" = 400.00'
created: 3/24/2006

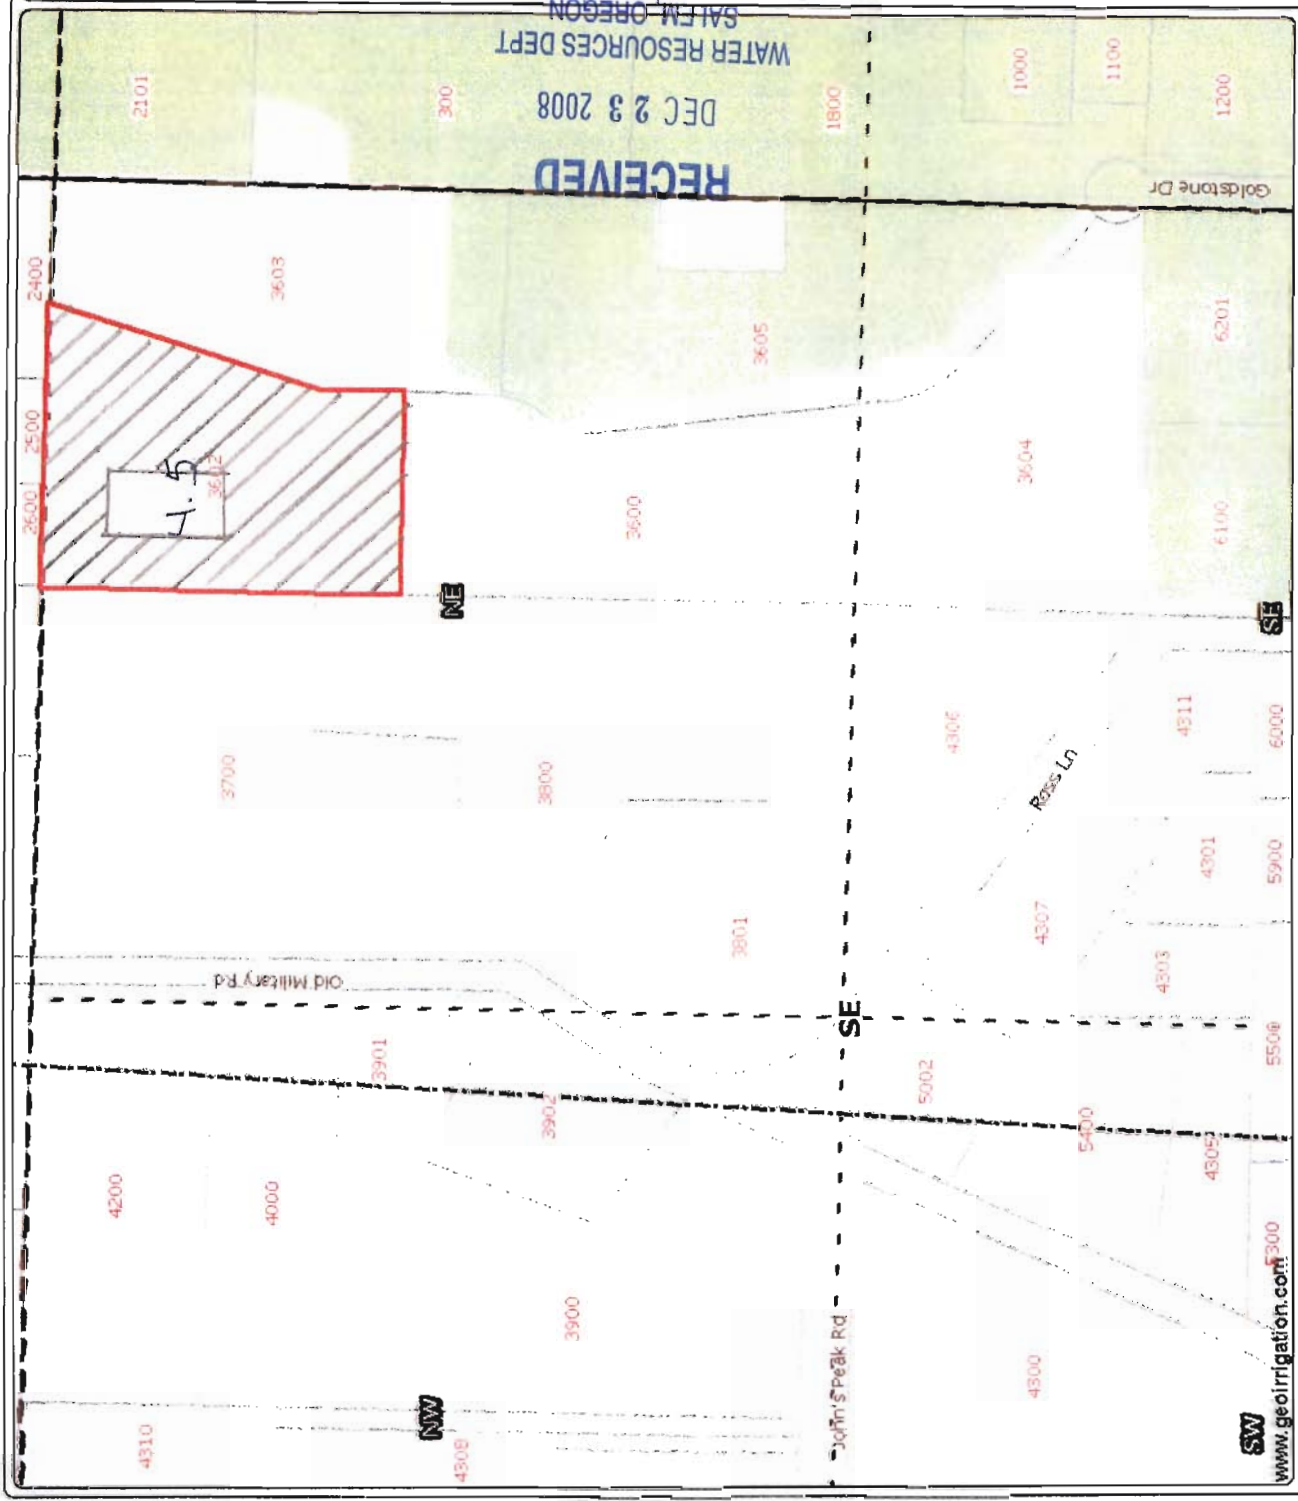

Powered By
geolrrigation

DISCLAIMER: This map is intended for display purposes only and is not intended for any legal representations. There are no warranties, expressed or implied, that accompany this product.

www.geolrrigation.com 5300

Authorized Place of Use

08-07

Transfer From:
JIRSA

37S 2W 23 37S 2W 26
4.50 Acres

Tax Lot # 700

SWSE
NWNE


- District Boundary USBR
- Road Labels
- Township Range
- Sections
- Section Labels
- Quarters
- Quarter Labels
- Quarter Quarters
- Quarter Quarters Labels
- Lot Labels
- Taxlots
- Waterbodies JACK CO
- Irrigation Ditches JACK CO
- Place of Use WORKING

**Transfer Off
Before Divided.**

RECEIVED
DEC 23 2008
WATER RESOURCES DEPT
SALEM, OREGON

1 10757

scale 1" = 400.00'
created: 3/24/2006

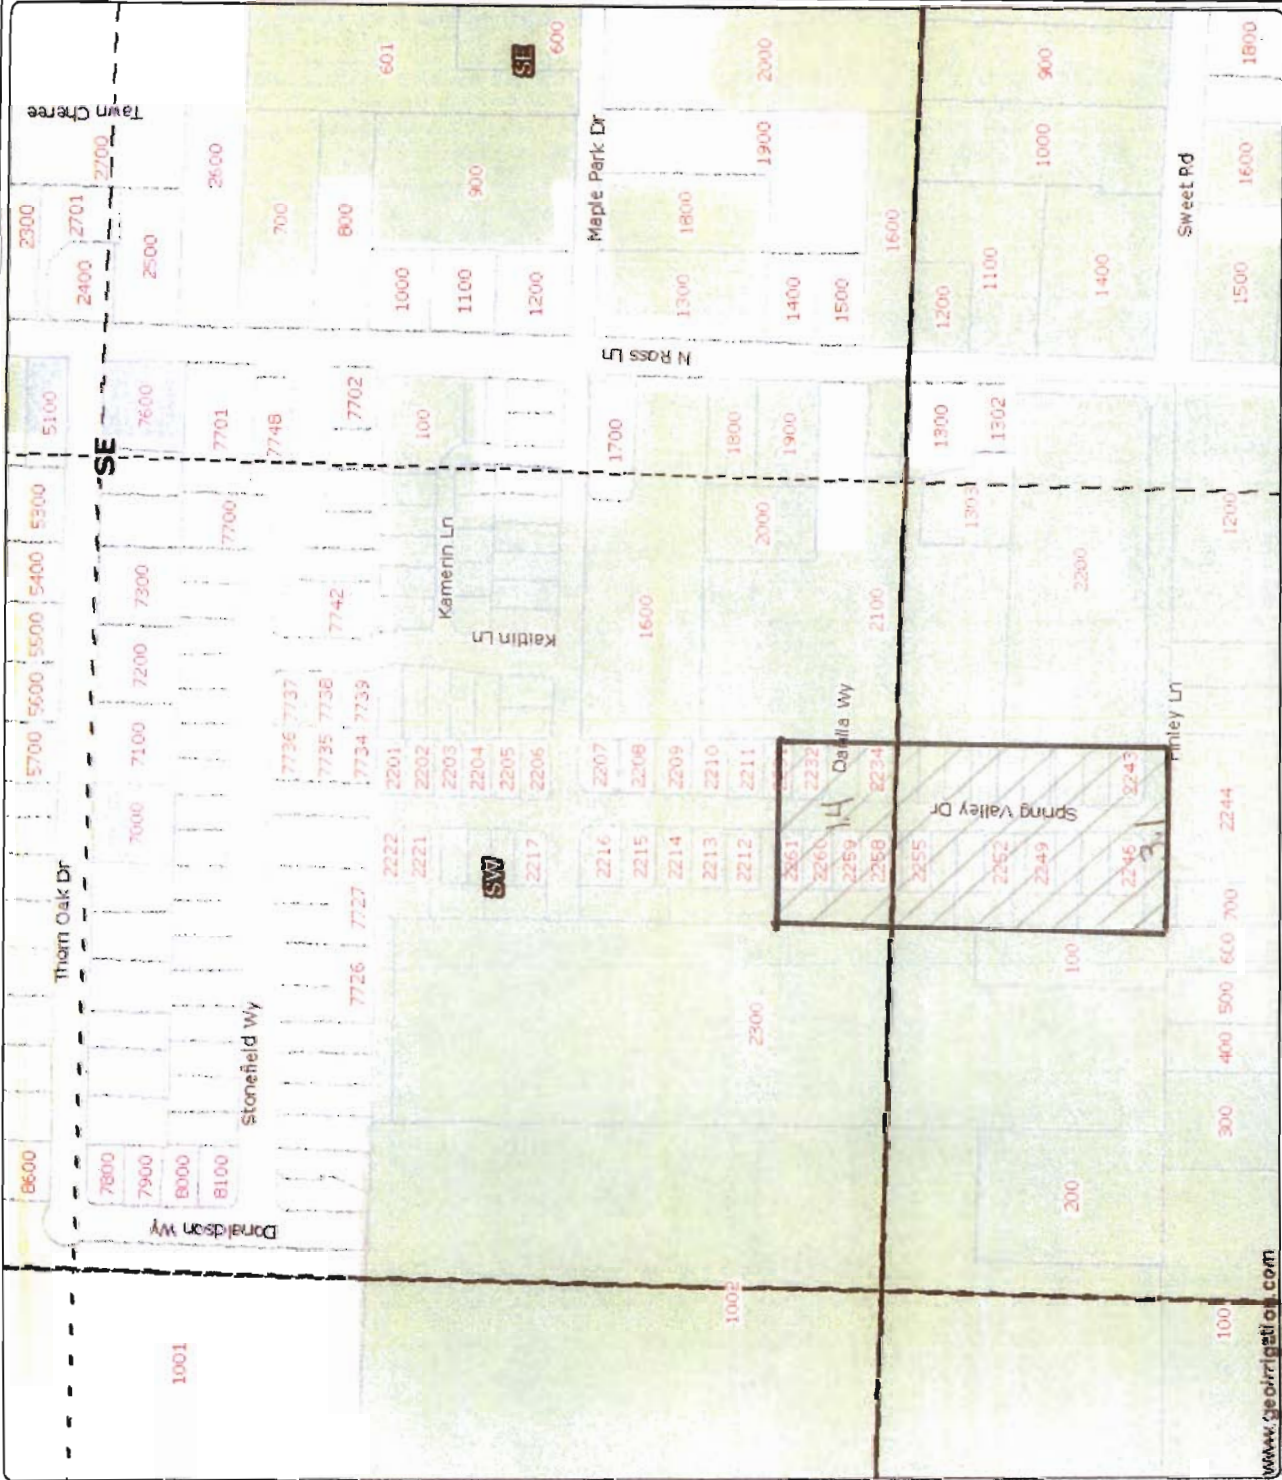

Powered By
geointegration

DISCLAIMER: This map is intended for display purposes only and is not intended for any legal representations. There are no warranties, expressed or implied, that accompany this product.

www.geointegration.com


Proposed Place of Use
08-08

Place of Use
Transfer To:
STEIGERWALD
37S 2W 17 TL 3600
NESE

- District Boundary USBR
- Road Labels
- Township Range
- Sections
- Section Labels
- Quarters
- Quarter Labels
- Quarter Quarters
- Quarter Quarters Labels
- Lot Labels
- Taxlots
- Waterbodies JACK CO
- Irrigation Ditches JACK CO
- RYCOOG Laterals
- Place of Use WORKING

444 inc.

scale 1" = 400.00'
created: 3/24/2006

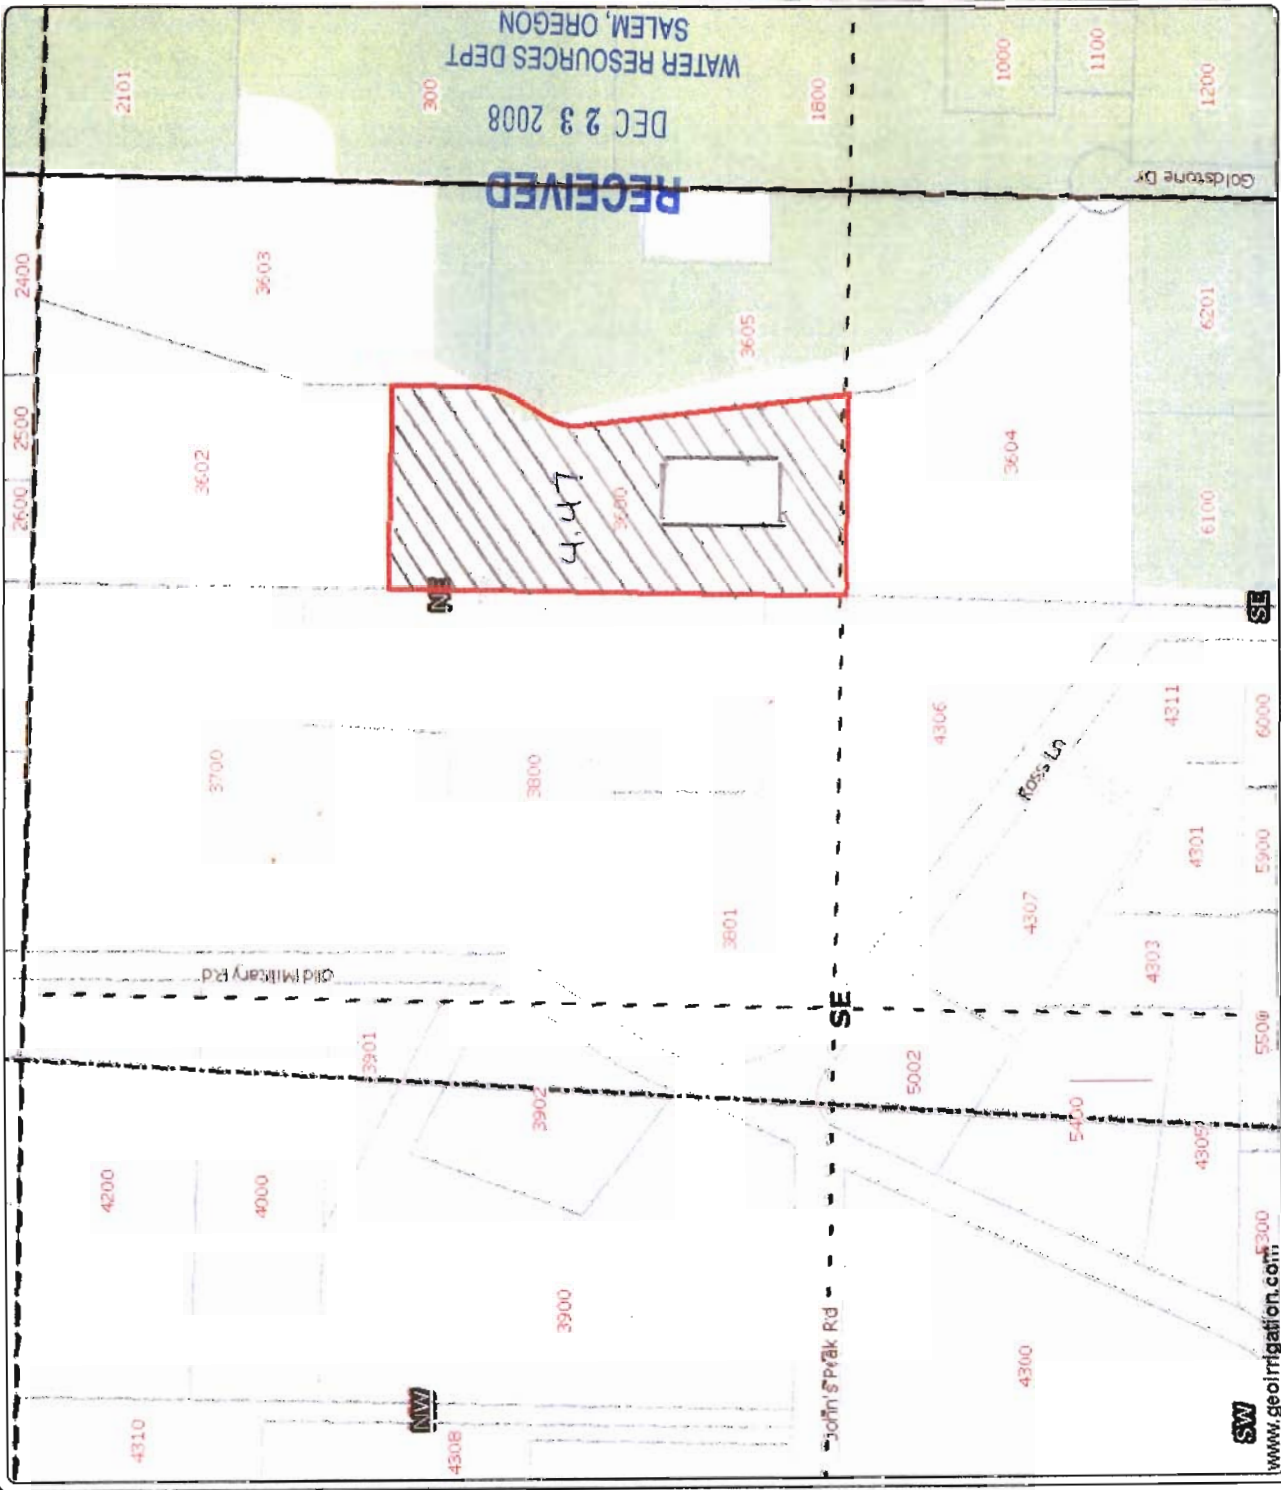

Powered By
geoirrigation

DISCLAIMER: This map is intended for display purposes only and is not intended for any legal representations. There are no warranties, expressed or implied, that accompany this product.

Authorized Place of Use

08-07

Transfer From:
JIRSA
37S 2W 23 TL 700
4.47 Acres

- District Boundary USBR
- Road Labels
- Township Range
- Sections
- Section Labels
- Quarters
- Quarter Labels
- Quarter Quarters
- Quarter Quarters Labels
- Lot Labels
- Taklots
- Waterbodies JACK CO
- Irrigation Ditches JACK CO
- Place of Use WORKING

To be Transferred
4.47 AC.


WATER RESOURCES DEPT
SALEM, OREGON

RECEIVED
DEC 23 2008

1 10757



scale 1" = 400.00'
created: 3/24/2005

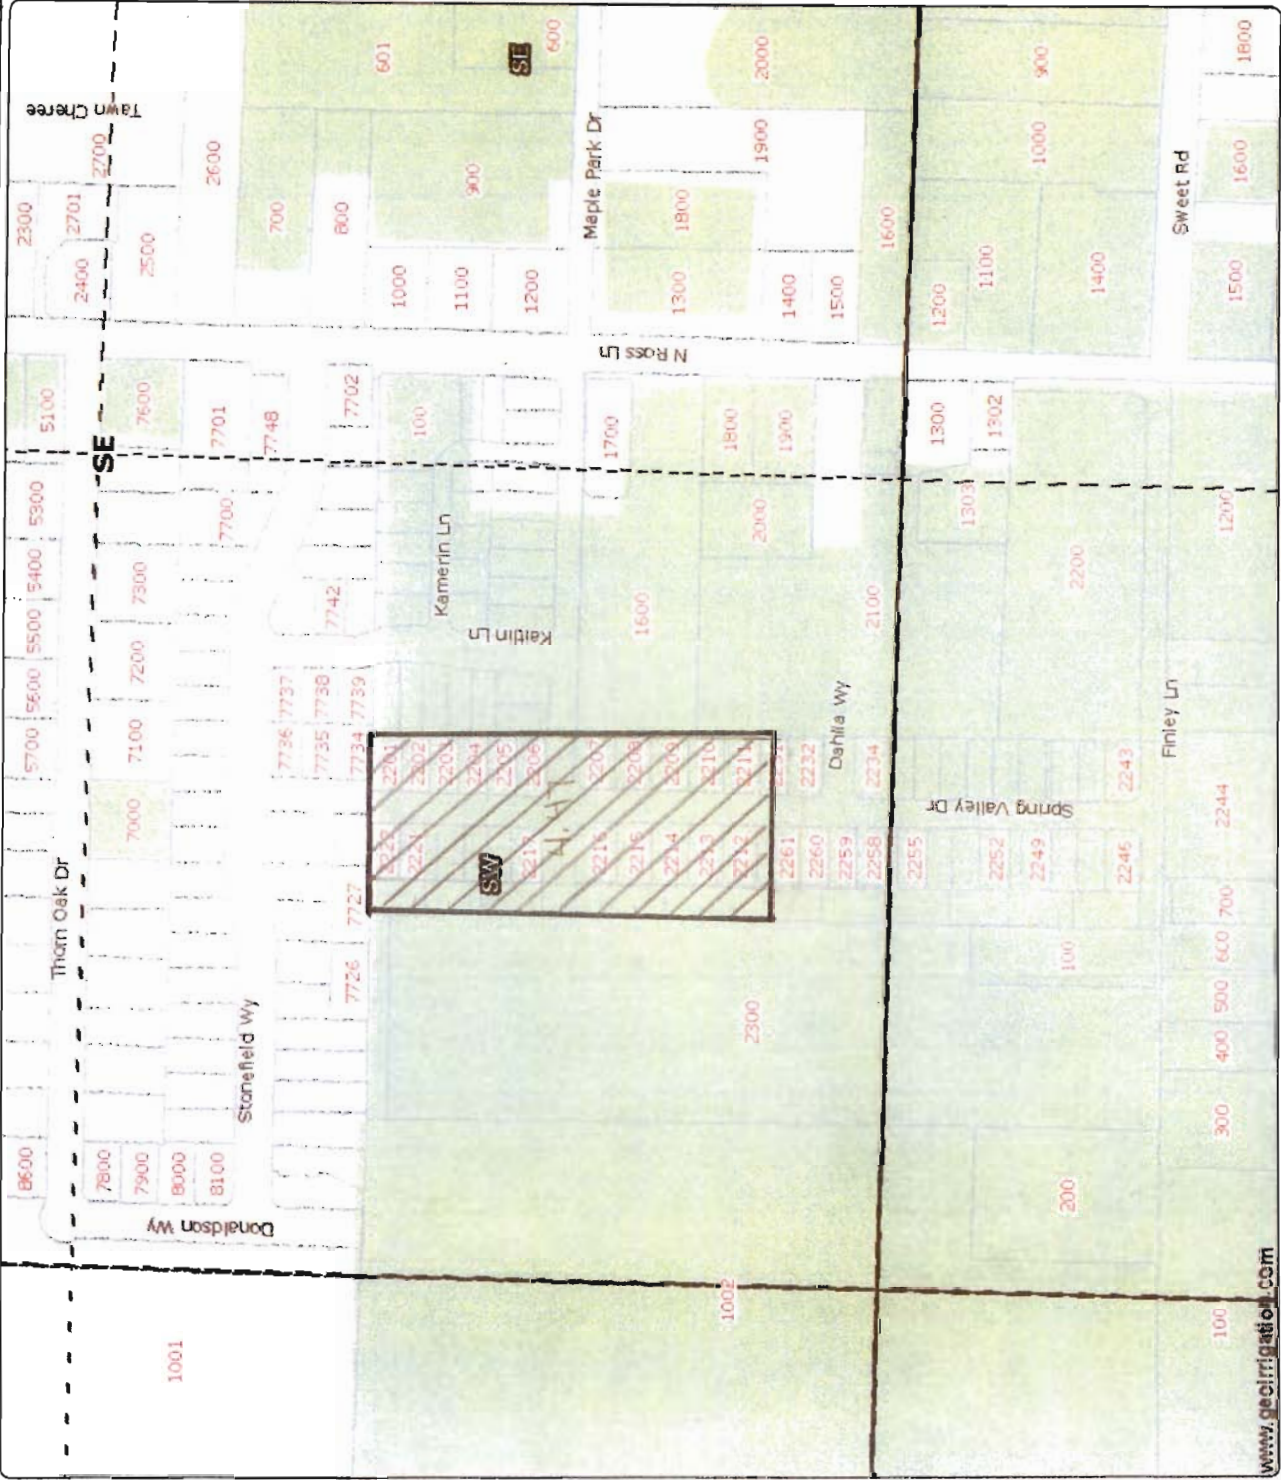

Powered By
geoirrigation

www.geoirrigation.com
DISCLAIMER: This map is intended for display purposes only and is not intended for any legal representations.
There are no warranties, expressed or implied, that accompany this product.

Authorized Place of Use

08-09

Transfer From
37S 2W 26AB TL 1900
3.76 Acres


- District Boundary USBR
- Road Labels
- Township Range
- Sections
- Section Labels
- Quarters
- Quarter Labels
- Quarter Quarters
- Quarter Quarters Labels
- Lot Labels
- Traklots
- Waterbodies JACK CO
- Place of Use WORKING

Transferred From

RECEIVED
DEC 23 2008
WATER RESOURCES DEPT
SALEM, OREGON
T 10757



scale 1" = 400.00'
created: 3/31/2006

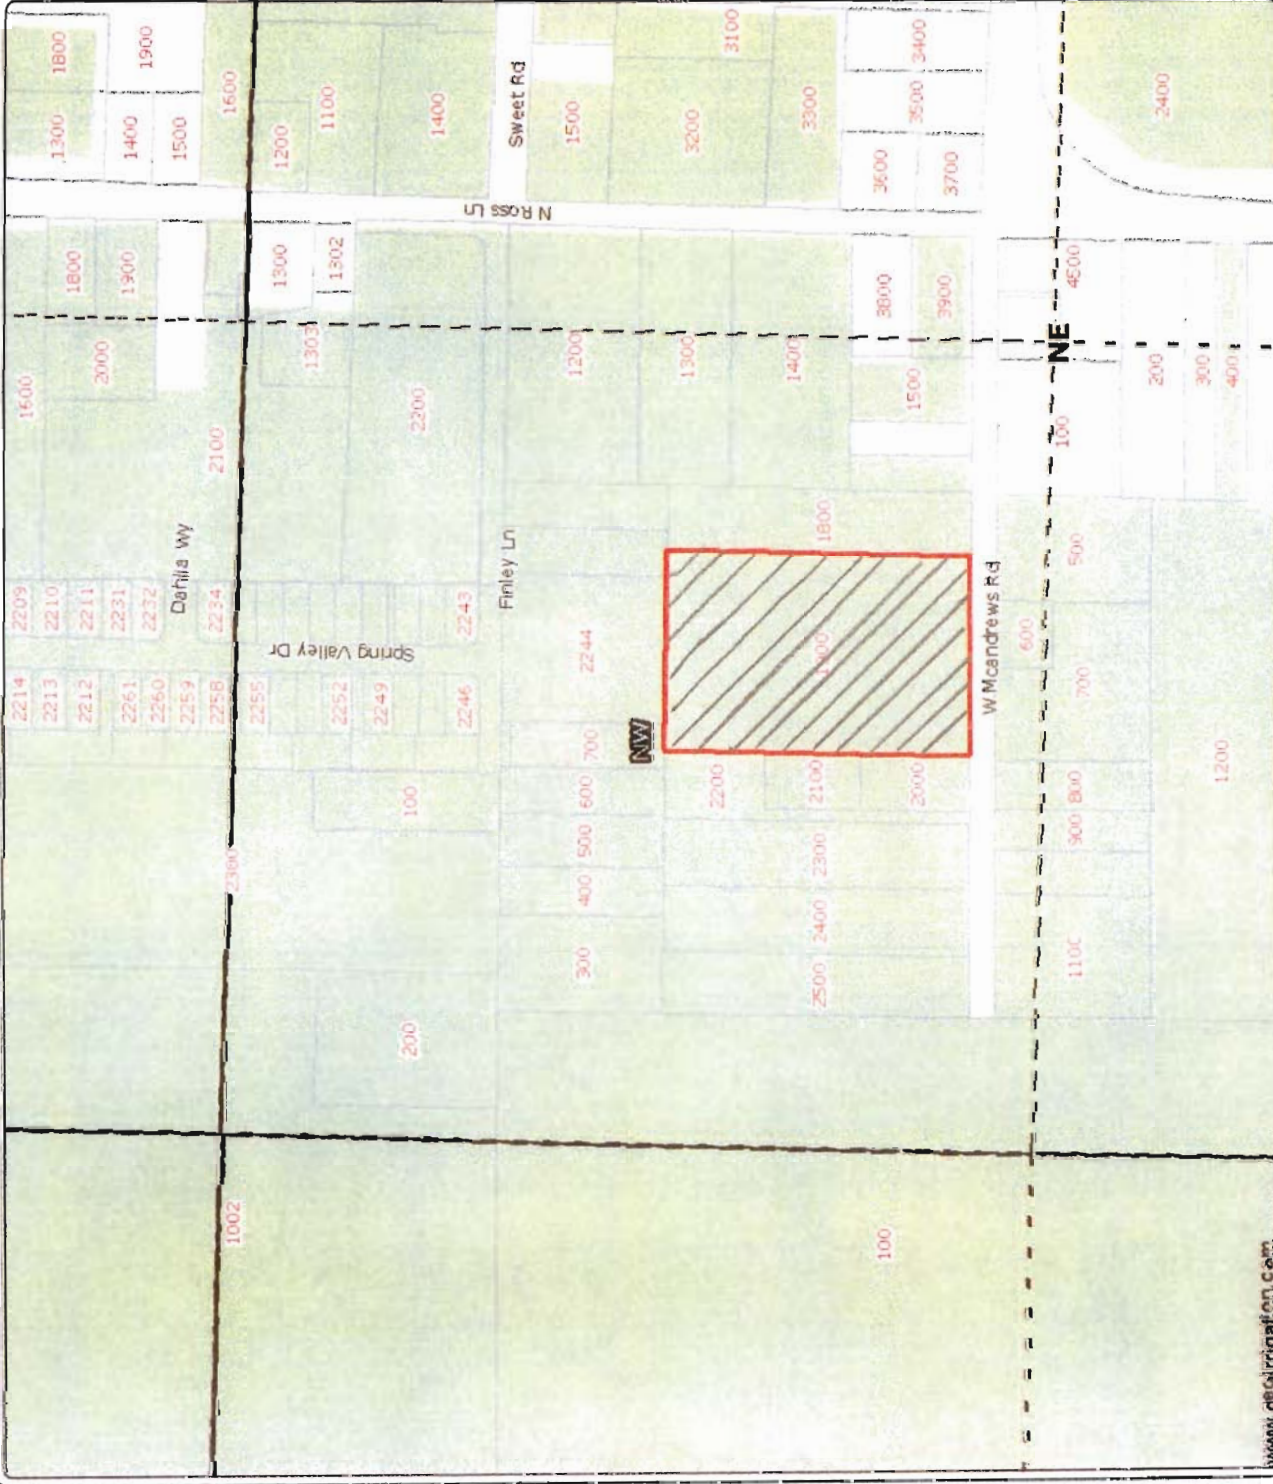

www.geoirrigation.com

Powered By
geoirrigation

DISCLAIMER: This map is intended for display purposes only and is not intended for any legal representations. There are no warranties, expressed or implied, that accompany this product.

Authorized Place of Use

08-09

Transfer From:
Vousden

37S 2W 27D TL 2800
27 SESE 34 NENE

- District Boundary USBR
- Road Labels
- Township Range
- Sections
- Section Labels
- Quarters
- Quarter Labels
- Quarter Quarters
- Quarter Quarters Labels
- Lot Labels
- Taxlots
- Waterbodies JACK CO
- Irrigation Ditches JACK CO
- Place of Use WORKING

Transfer From


RECEIVED
DEC 23 2008

T 10757



scale 1" = 400.00'
created: 3/30/2006

WATER RESOURCES DEPT
SALEM, OREGON

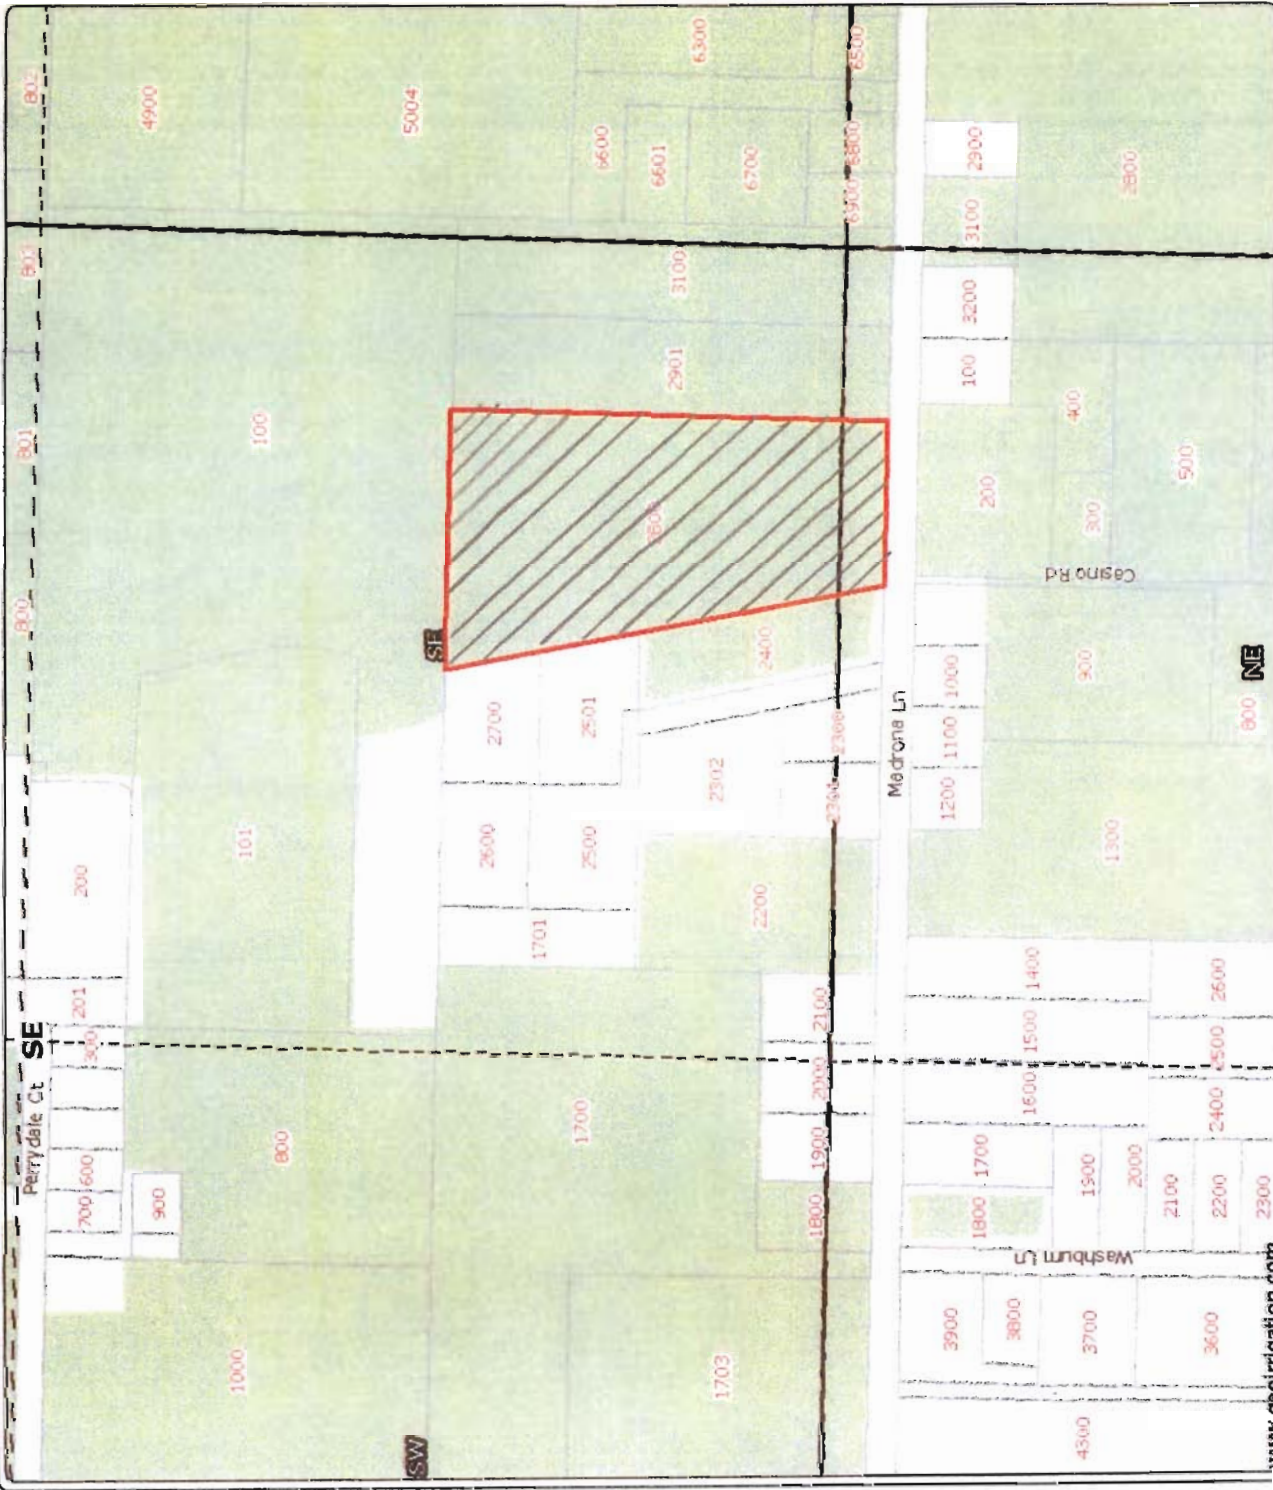

www.geoirrigation.com

DISCLAIMER: This map is intended for display purposes only and is not intended for any legal representations. There are no warranties, expressed or implied, that accompany this product.

Powered By
geoirrigation

Proposed Place of Use

08-09


Transfer To:
Brown

37S 2W 33 TL 700
NESE & SESE
9.50 ac

- District Boundary USBR
- Road Labels
- Township Range
- Sections
- Section Labels
- Quarters
- Quarter Labels
- Quarter Quarters
- Quarter Quarters Labels
- Lot Labels
- Taxlots
- Waterbodies JACI: CO
- Irrigation Ditches JACK CO
- Place of Use WORKING

9.50 ac.
To be irr.

WATER RESOURCES DEPT
SALEM, OREGON
RECEIVED
DEC 23 2008
I 10757
scale 1" = 400.00'
created: 3/30/2006

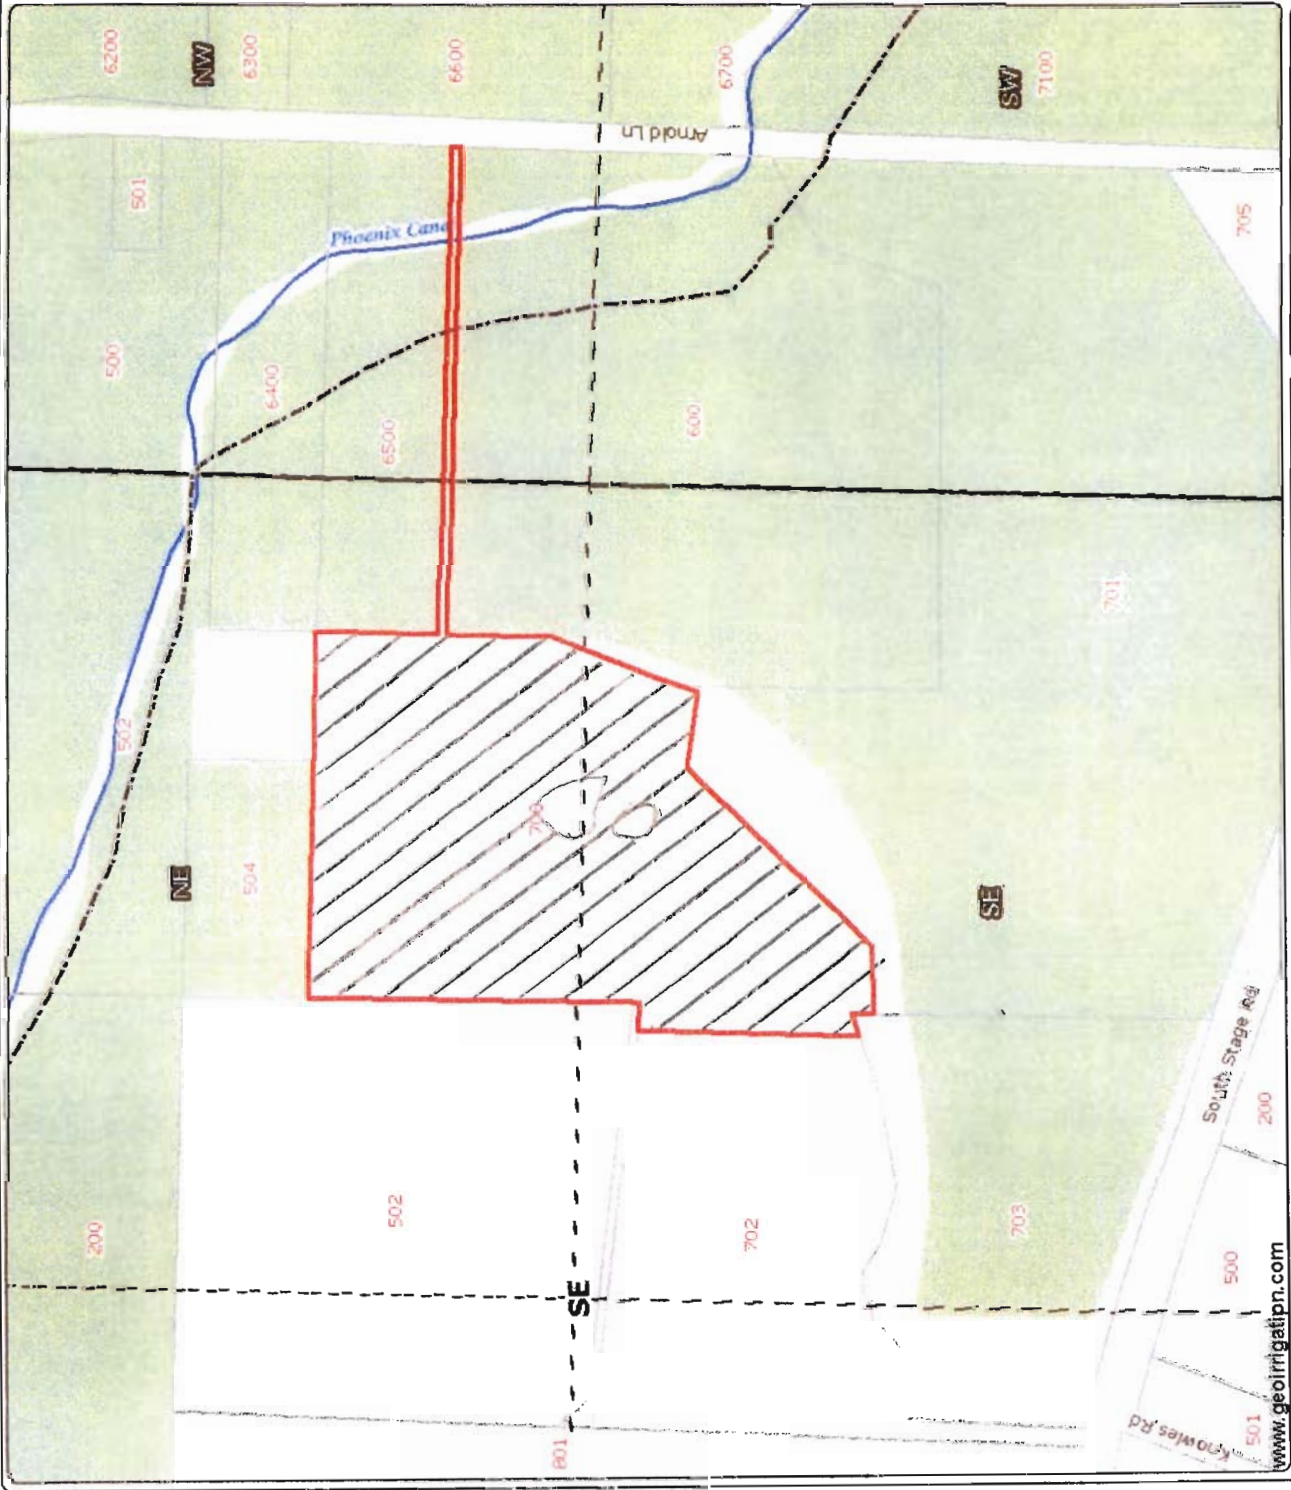

Powered By
geoirrigation

DISCLAIMER: This map is intended for display purposes only and is not intended for any legal representations. There are no warranties, expressed or implied, that accompany this product.
www.geoirrigation.com

Medford Irrigation District

Proposed

08-10 Application of Use
361E05 #2403 21 ac.

WATER RESOURCES DEPT
SALEM, OREGON

RECEIVED
DEC 23 2008


- District Boundary USBR
- County Boundary
- Road Labels
- Township Range
- Sections
- Section Labels
- Quarters
- Quarter Labels
- Quarter Quarters
- Quarter Quarters Labels
- Lot Labels
- Taxlots
- POU District Primary
- Irrigation Ditches JACK CO
- RWC00G Laterals

Proposed Place of Use.

1 10757



Scale 1" = 400'
Created: 10/20/2008

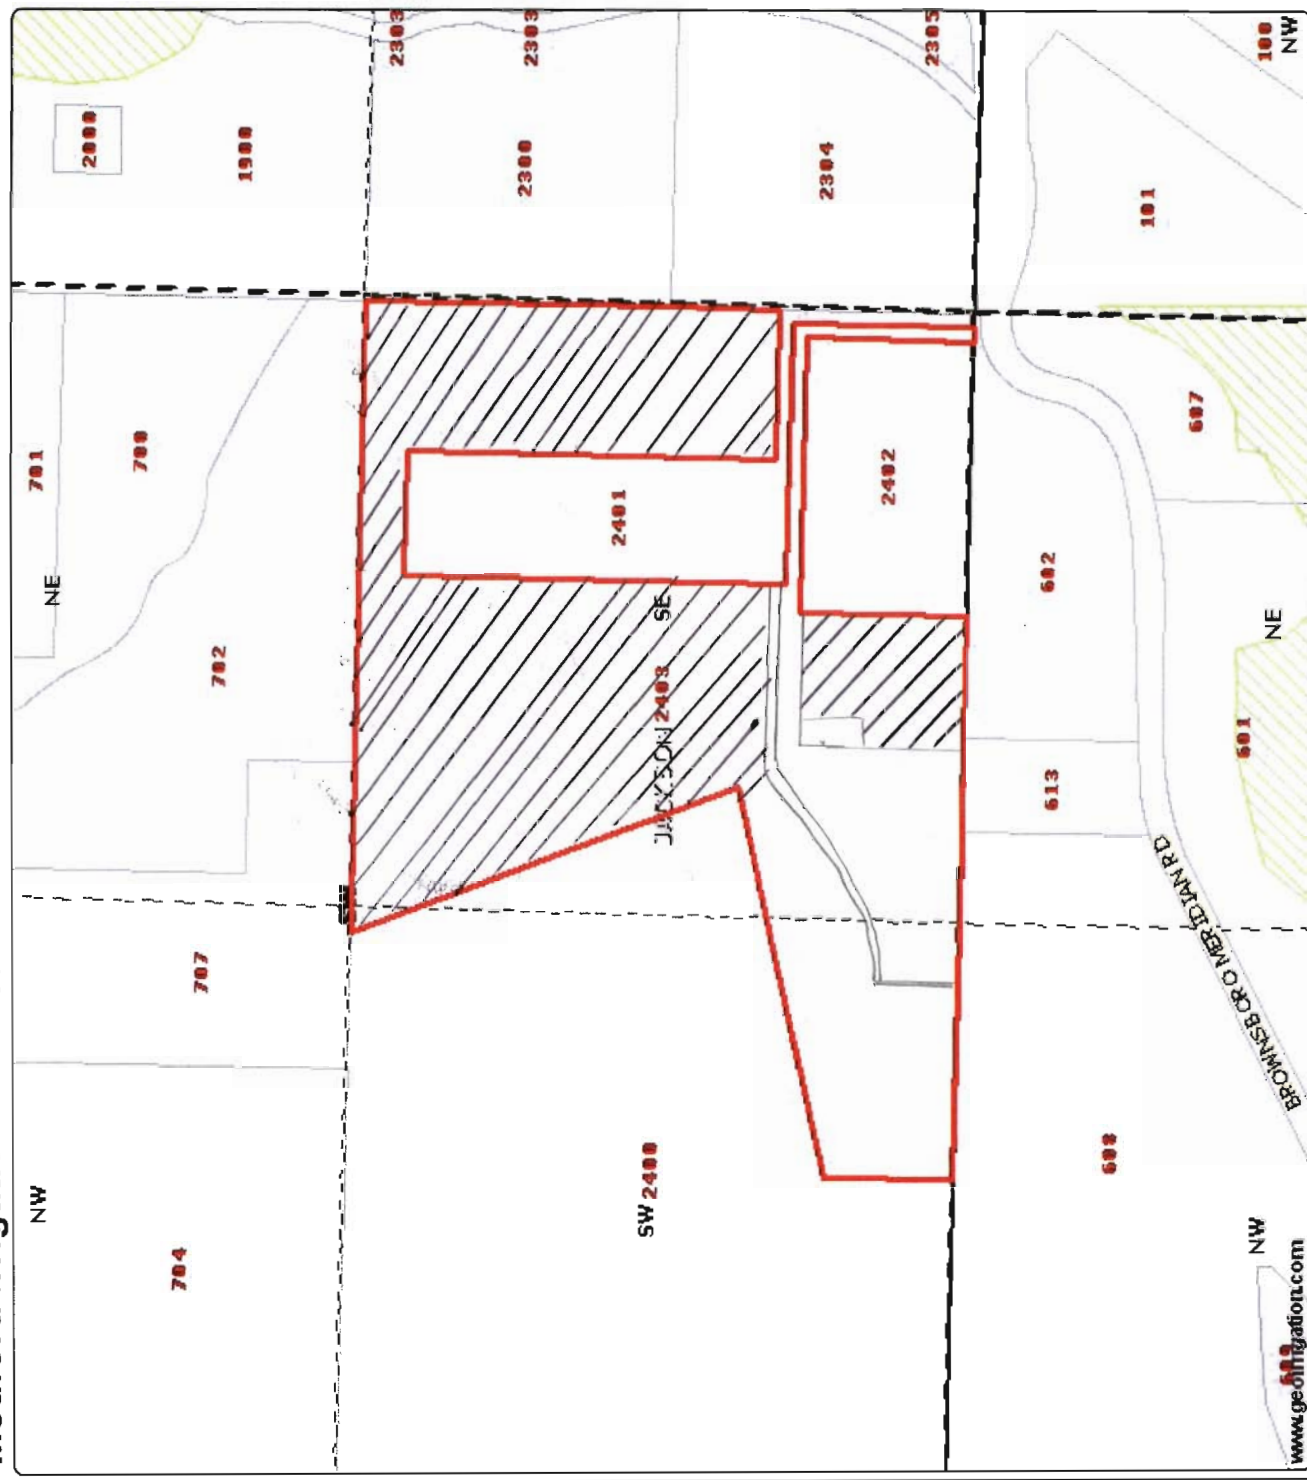

www.geointegration.com

DISCLAIMER: This map is intended for display purposes only and is not intended for any legal representations. There are no warranties, expressed or implied, that accompany this product.

Medford Irrigation District

Authorized Place of Use
08-10

372W36DBV #1200 .22 ac

WATER RESOURCES DEPT
SALEM, OREGON

RECEIVED
DEC 23 2008

- District Boundary USBR
- County Boundary
- Road Labels
- Township Range
- Sections
- Section Labels
- Quarters
- Quarter Labels
- Quarter Quarters
- Quarter Quarters Labels
- Taxlots
- POU District Primary
- Irrigation Ditches JACK CO
- RMC003 Laterals

.22 ac.
To Transfer

10737



Scale 1" = 400'
Created: 11/4/2008



DISCLAIMER: This map is intended for display purposes only and is not intended for any legal representations. There are no warranties, expressed or implied, that accompany this product.

www.gisonline.com

Medford Irrigation District


Authorized

Place of Use

08-10

371W21CC #1000

1.65 ac

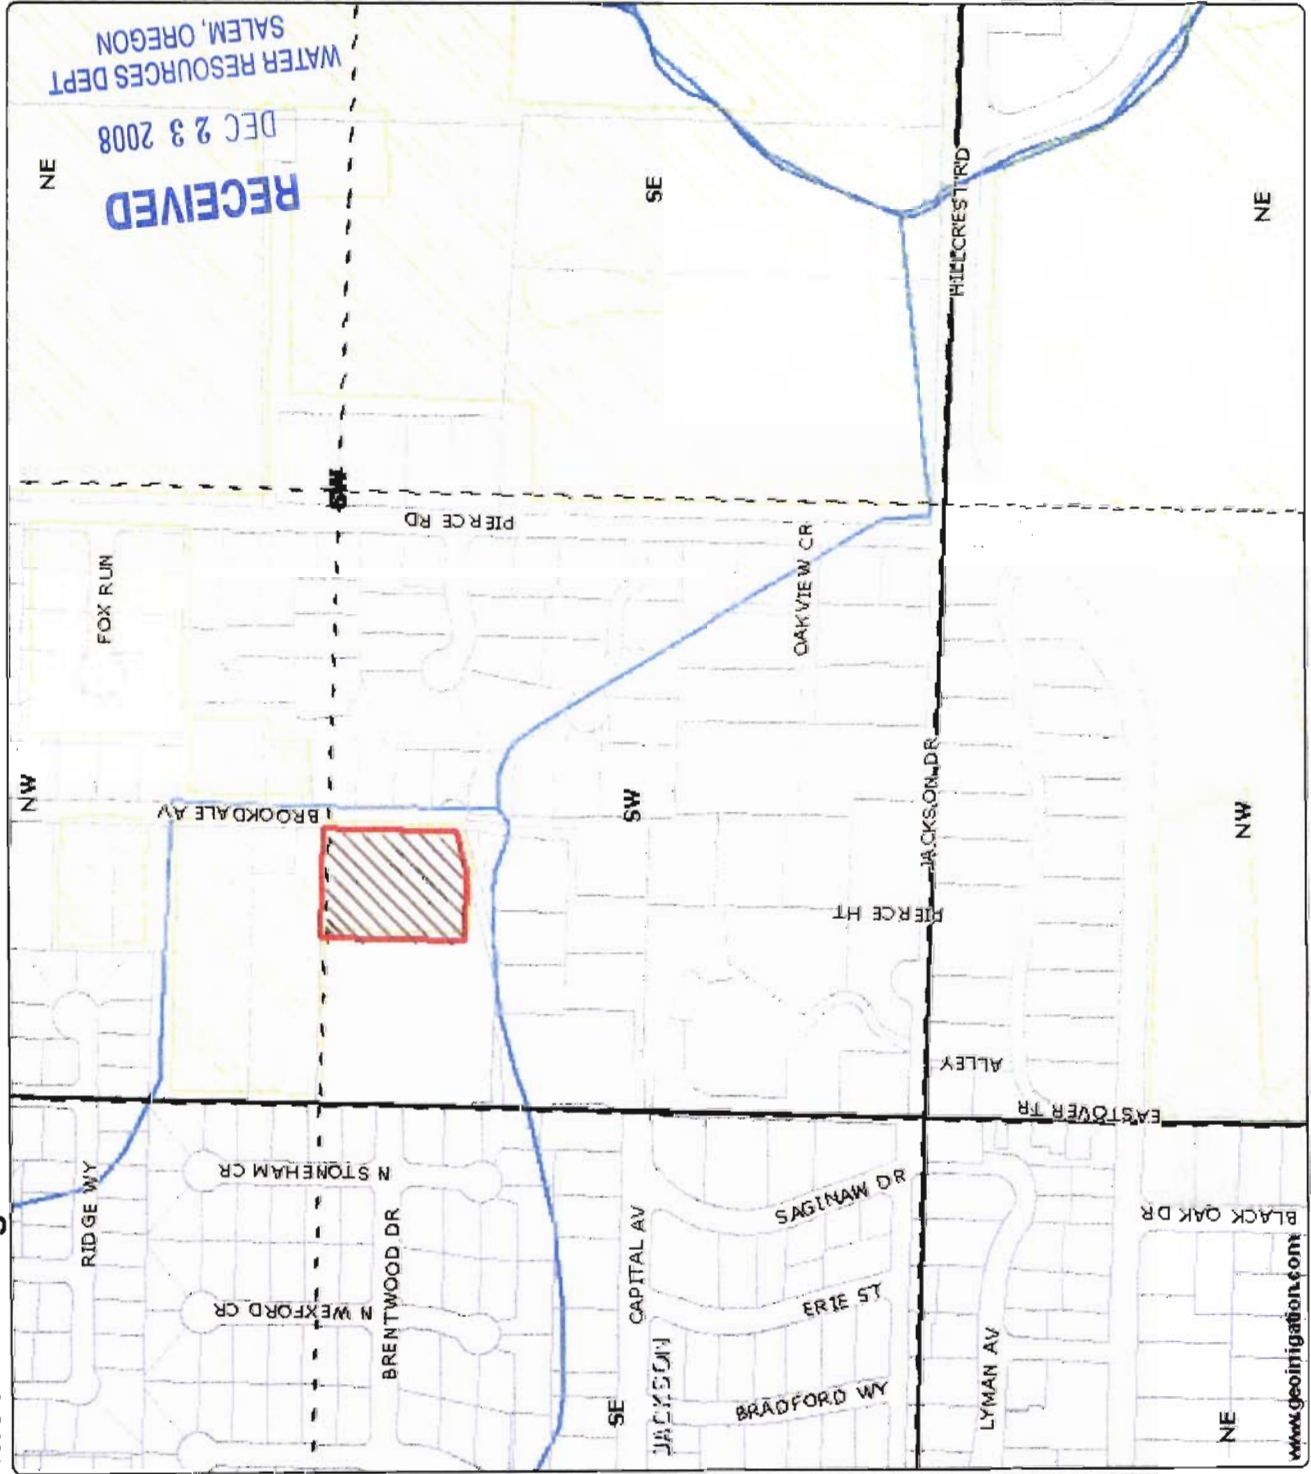

- District Boundary USBR
- County Boundary
- Road Labels
- Township Range
- Section s
- Section Labels
- Quarters
- Quarter Labels
- Quarter Quarters
- Quarter Quarters Labels
- Taxlots
- POU District Primary
- Irrigation Ditches JACK CO
- RVC00 Laterals

1.65 ac To Transfer.

1 10757



Scale 1" = 400'
Created: 11/4/2008

www.geoinformation.com

DISCLAIMER: This map is intended for display purposes only and is not intended for any legal representations. There are no warranties, expressed or implied, that accompany this product.

Medford Irrigation District



08-10 Authorized Place of Use

37-1w-16A #800 3.60 ac

- District Boundaries SBR
- County Boundaries
- Road Labels
- Township Range
- Sections
- Section Labels
- Quarters
- Quarter Labels
- Quarter Quarters
- Quarter Quarters Labels
- Taxlots
- POU District Primary
- Irrigation Ditches JACK CO
- RVC/OG Laterals

RECEIVED
DEC 2 2008
WATER RESOURCES DEPT
SALEM, OREGON

Place of Use
Transfer Off

1 10757



Scale 1" = 400'
Created: 9/29/2008

DISCLAIMER: This map is intended for display purposes only and is not intended for any legal representations. There are no warranties, expressed or implied, that accompany this product.

Medford Irrigation District

08-10 Authorized Place of Use

37-1W09 #3400 .7 ac

- District Boundary USBR
- County Boundary
- Road Labels
- Township Range
- Sections
- Section Labels
- Quarters
- Quarter Labels
- Quarter Quarters
- Quarter Quarters Labels
- Taxlots
- POU District Primary
- Irrigation Ditches JACK CO
- RVC-00 Laterals

Place of Use
Transfer OFF

10787



Scale 1" = 200'
Created: 9/29/2008



DISCLAIMER: This map is intended for display purposes only and is not intended for any legal representations. There are no warranties, expressed or implied, that accompany this product.

Medford Irrigation District

08-10 Authorized Place of Use

371w16ac #1100 .70 ac

- District Boundary, USBR
- County Boundary
- Road Labels
- Township Range
- Sections
- Section Labels
- Quarters
- Quarter Labels
- Quarter Quarters
- Quarter Quarters Labels
- Taxlots
- FOU District Primary
- Irrigation Ditches JACK CO
- RVCOG Laterals

RECEIVED
DEC 23 2008

WATER RESOURCES DEPT
SALEM, OREGON

Place of Use
Transfer OFF

1 10757



Scale 1" = 200'
Created: 9/29/2008



DISCLAIMER: This map is intended for display purposes only and is not intended for any legal representations. There are no warranties, expressed or implied, that accompany this product.

Medford Irrigation District

Authorized

Place of Use 08-10
371W20AB #200
3.20 ac

- District Boundary USBR
- County Boundary
- Road Labels
- Township Range
- Sections
- Section Labels
- Quarters
- Quarter Labels
- Quarter Quarters
- Quarter Quarters Labels
- Taxlots
- POU District Primary
- Irrigation Ditches JACK CO
- RMC016 Laterals

RECEIVED

DEC 23 2008


WATER RESOURCES DEPT
SALEM, OREGON

3.20 ac To
Transfer

10757



Scale 1" = 400'
Created: 11/4/2008

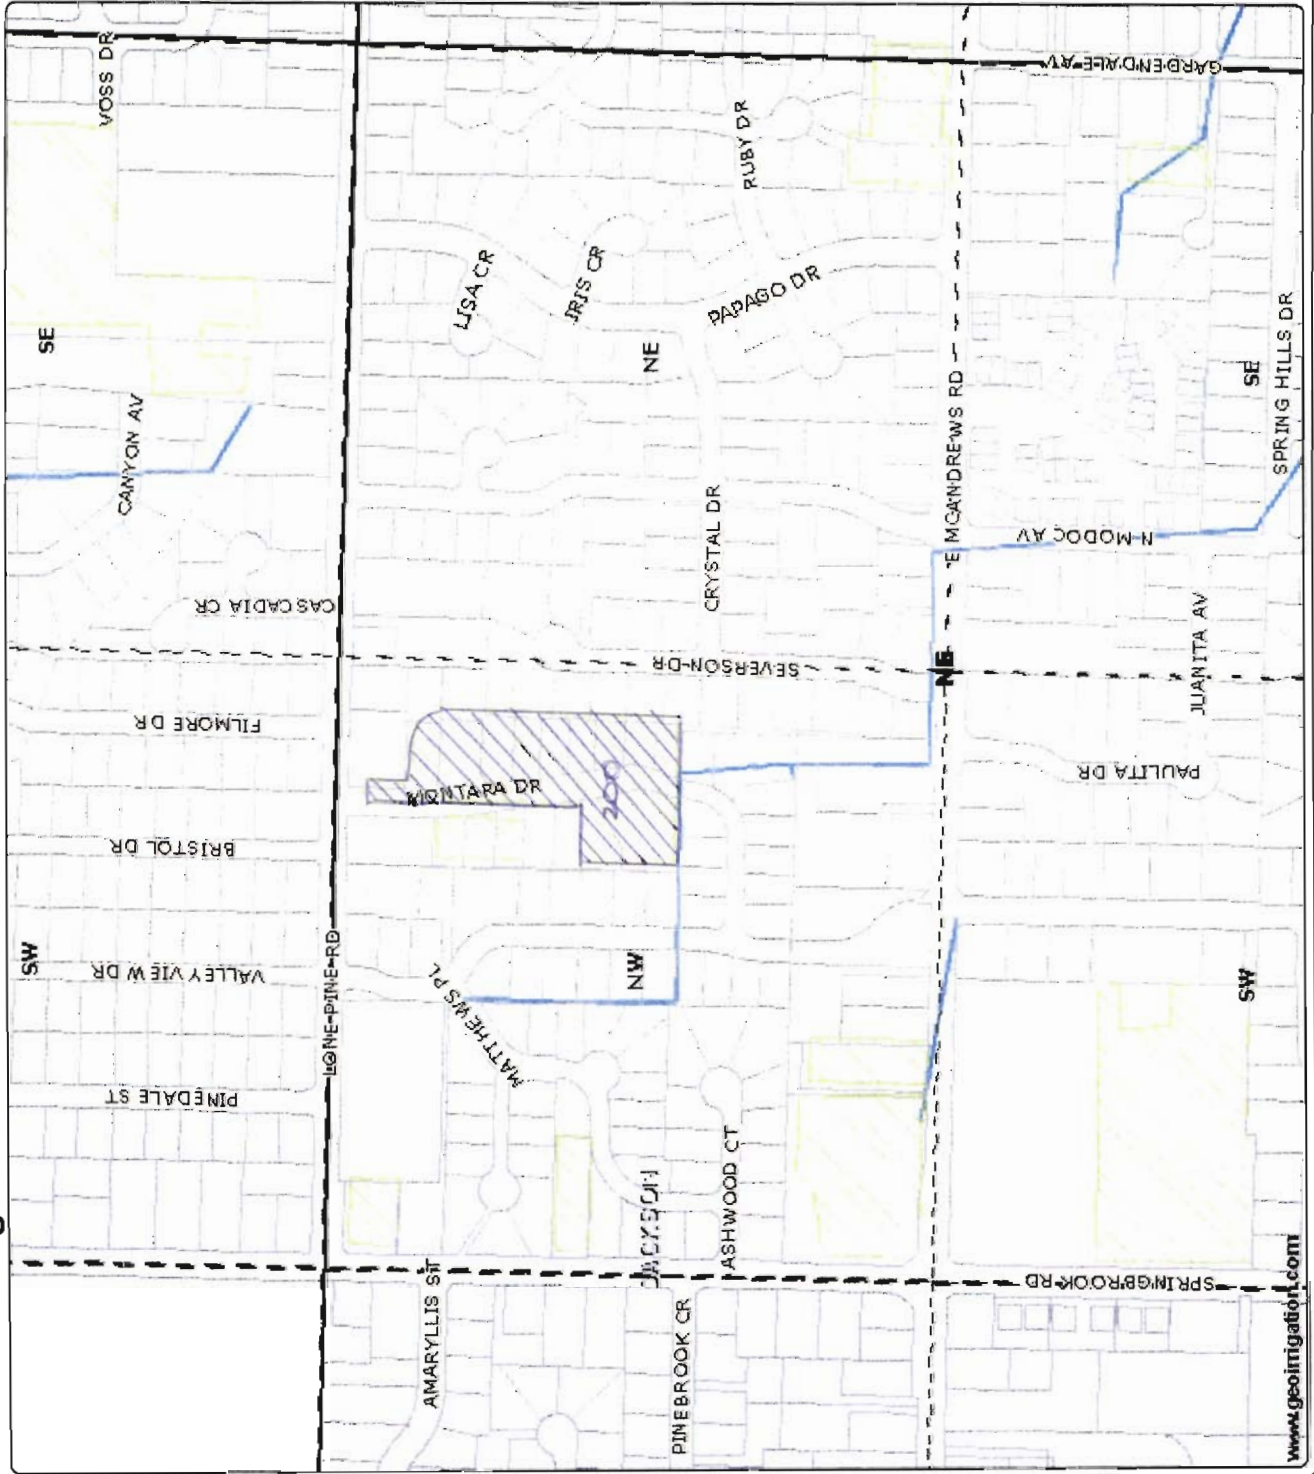

www.geotirrigation.com

DISCLAIMER: This map is intended for display purposes only and is not intended for any legal representations. There are no warranties, expressed or implied, that accompany this product.

Medford Irrigation District

Authorized Place of Use
 08-10
 371W16A #801 2.87 ac.

- District Boundary USBR
- County Boundary
- Road Labels
- Township Range
- Section s
- Section Labels
- Quarters
- Quarter Labels
- Quarter Quarters
- Quarter Quarters Labels
- Taxlots
- POU District Primary
- Irrigation Ditches JACK CO
- RVCOG Laterals

2.87 To
 Transfer OFF
 #801
 Before subdivided

10737



Scale 1" = 500'
 Created: 11/4/2008




DISCLAIMER: This map is intended for display purposes only and is not intended for any legal representations. There are no warranties, expressed or implied, that accompany this product.

Authorized

08-1D
Place of Use
TRANSFER OFF
37-2W-29 TAX LOT 901
Millette

RECEIVED
DEC 23 2008
WATER RESOURCES DEPT
SALEM, OREGON

Medford Irrigation District

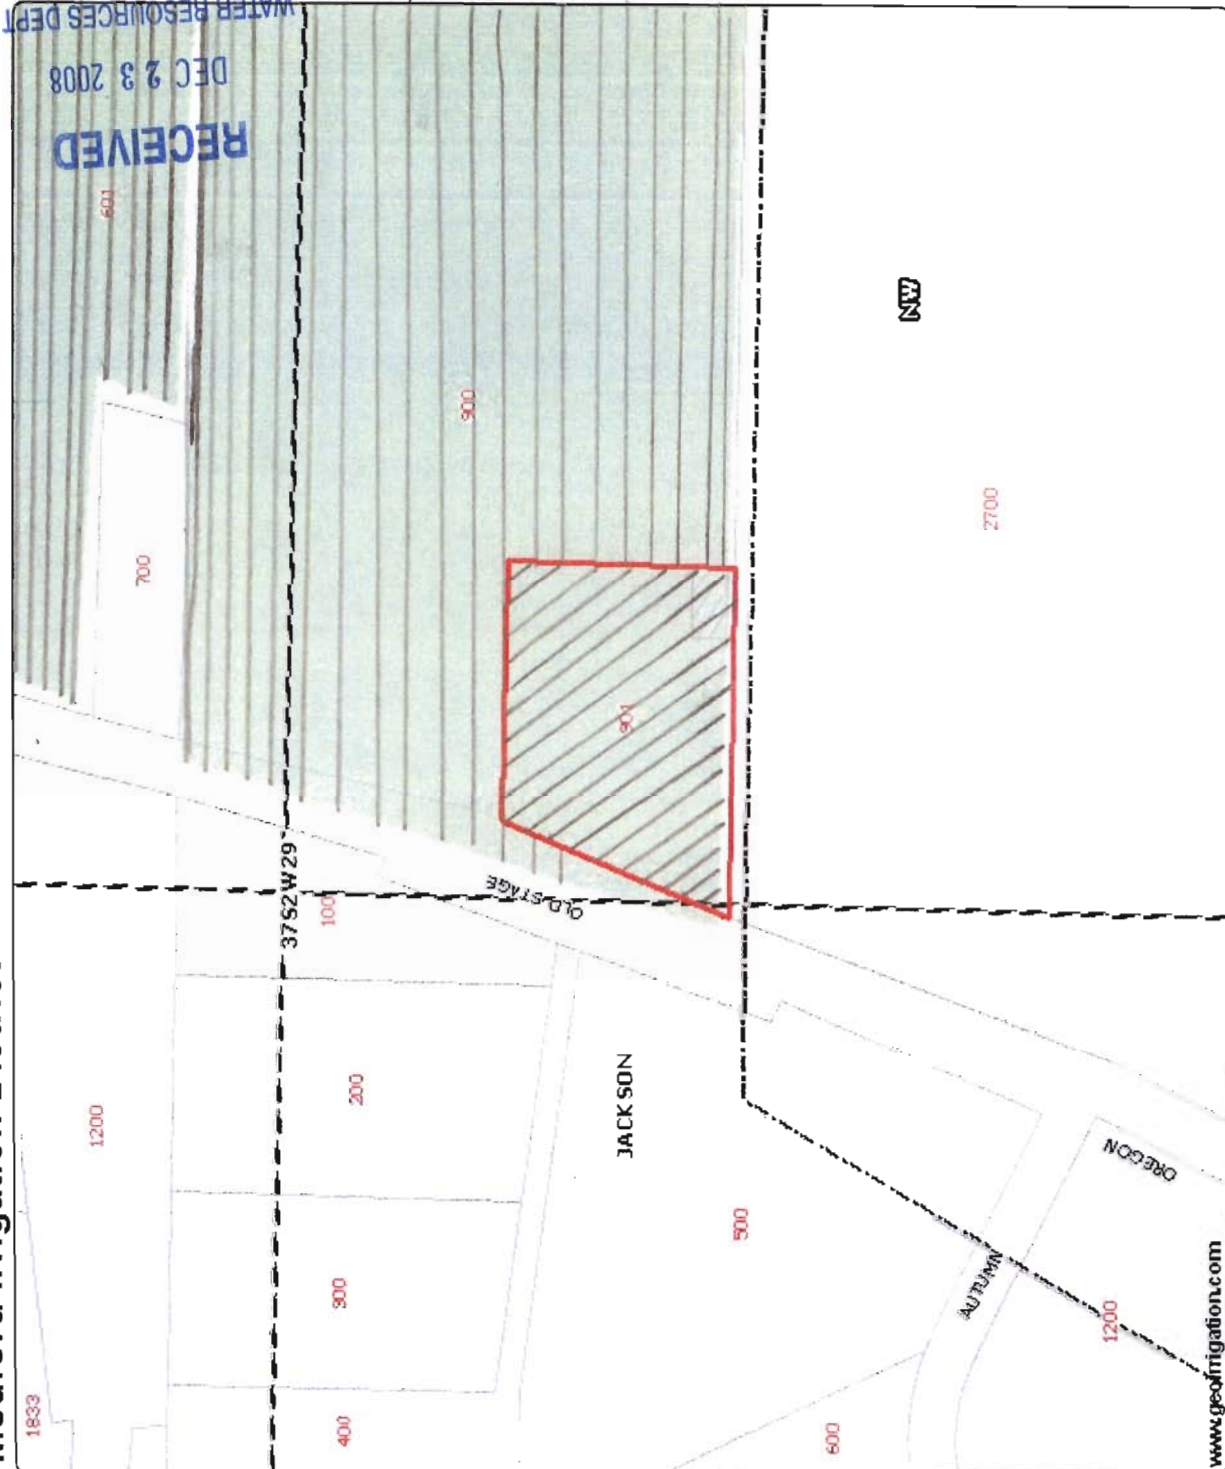

- District Boundary USBR
- County Boundary
- Road Labels
- Township Range
- Sections
- Section Labels
- Quarters
- Quarter Labels
- Quarter Quarters
- Quarter Quarters Labels
- Lot Labels
- Taxlots
- Rivers JACK CO
- Waterbodies JACK CO
- Irrigation Ditches JACK CO
- RVOOG Laterals
- Water Rights OLD
- Water Rights NEW

190ac use
in transfer 08-1D
under investigation



Scale 1" = 200'
Created: 1/17/2008

www.geonirrigation.com


ARTHUR & SUSAN MILLETTE
428 OLD STAGE RD
OLD LAND 1.9 AC

DISCLAIMER: This map is intended for display purposes only and in no way constitutes any legal representation. There are no warranties, expressed or implied, that accompany this product.

08-10

Authorized
Place
of
Use

Rogue River Valley Irrigation District Water Rights Transfer Map

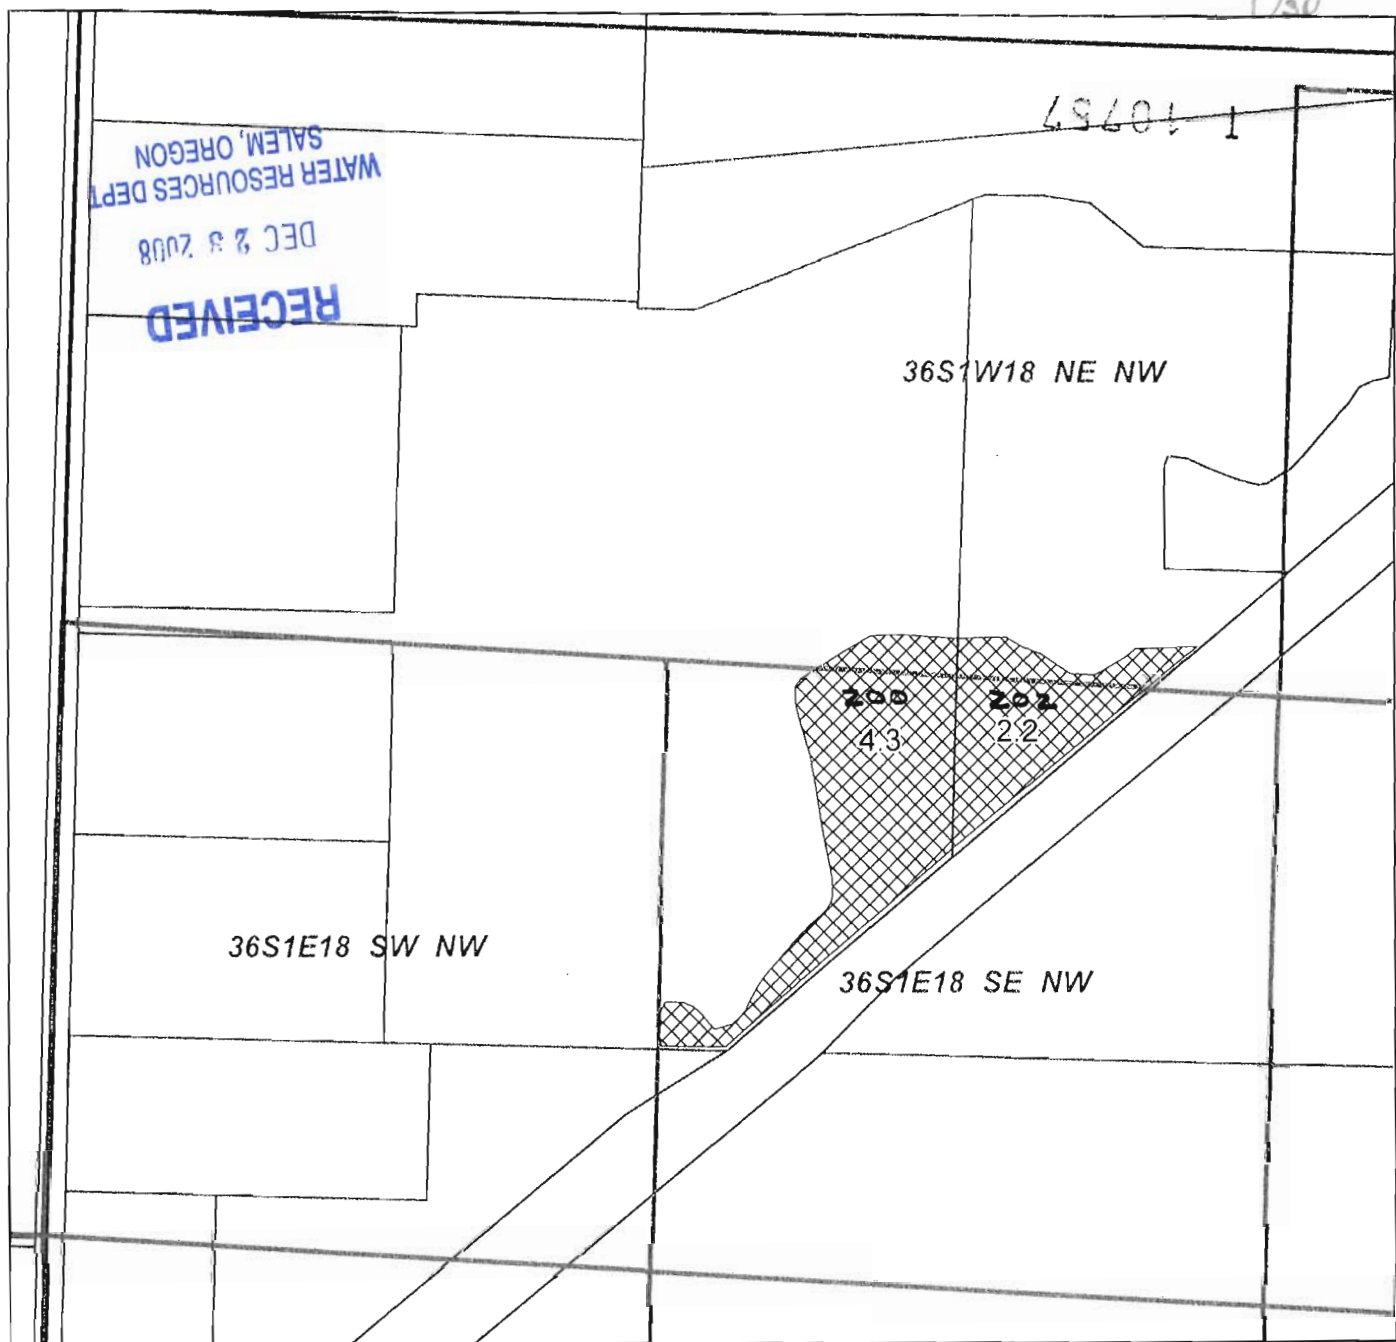






Located in SE 1/4 NW 1/4 SEC 18 T.36S. R.1 E.W.M.

Tax Lot T36S R1E 18 200 - 4.3 AC
T36S R1E 18 202 - 2.2 AC

From: RRVID

- Certificates
 80566
 80569
 80571
 80574

-  Transfer Off
-  Qtr-Qtr
-  Section Line
-  Tax Lot Line

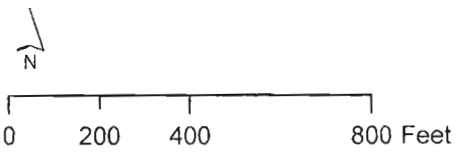

Proposed Place of Use

08-11

Transfer To:
Luehrs


36 South, 1 West, Section 36
TL 414 SESW 5.0 Acres

- District Boundary USBR
- Road Labels
- Township Range
- Sections
- Section Labels
- Quarters
- Quarter Labels
- Quarter Quarters
- Quarter Quarters Labels
- Lot Labels
- Taxlots
- Waterbodies JACK CO
- Irrigation Ditches JACK CO
- Place of Use WORKING

To irrigate
5.00



scale 1" = 400.00'
created: 6/15/2006

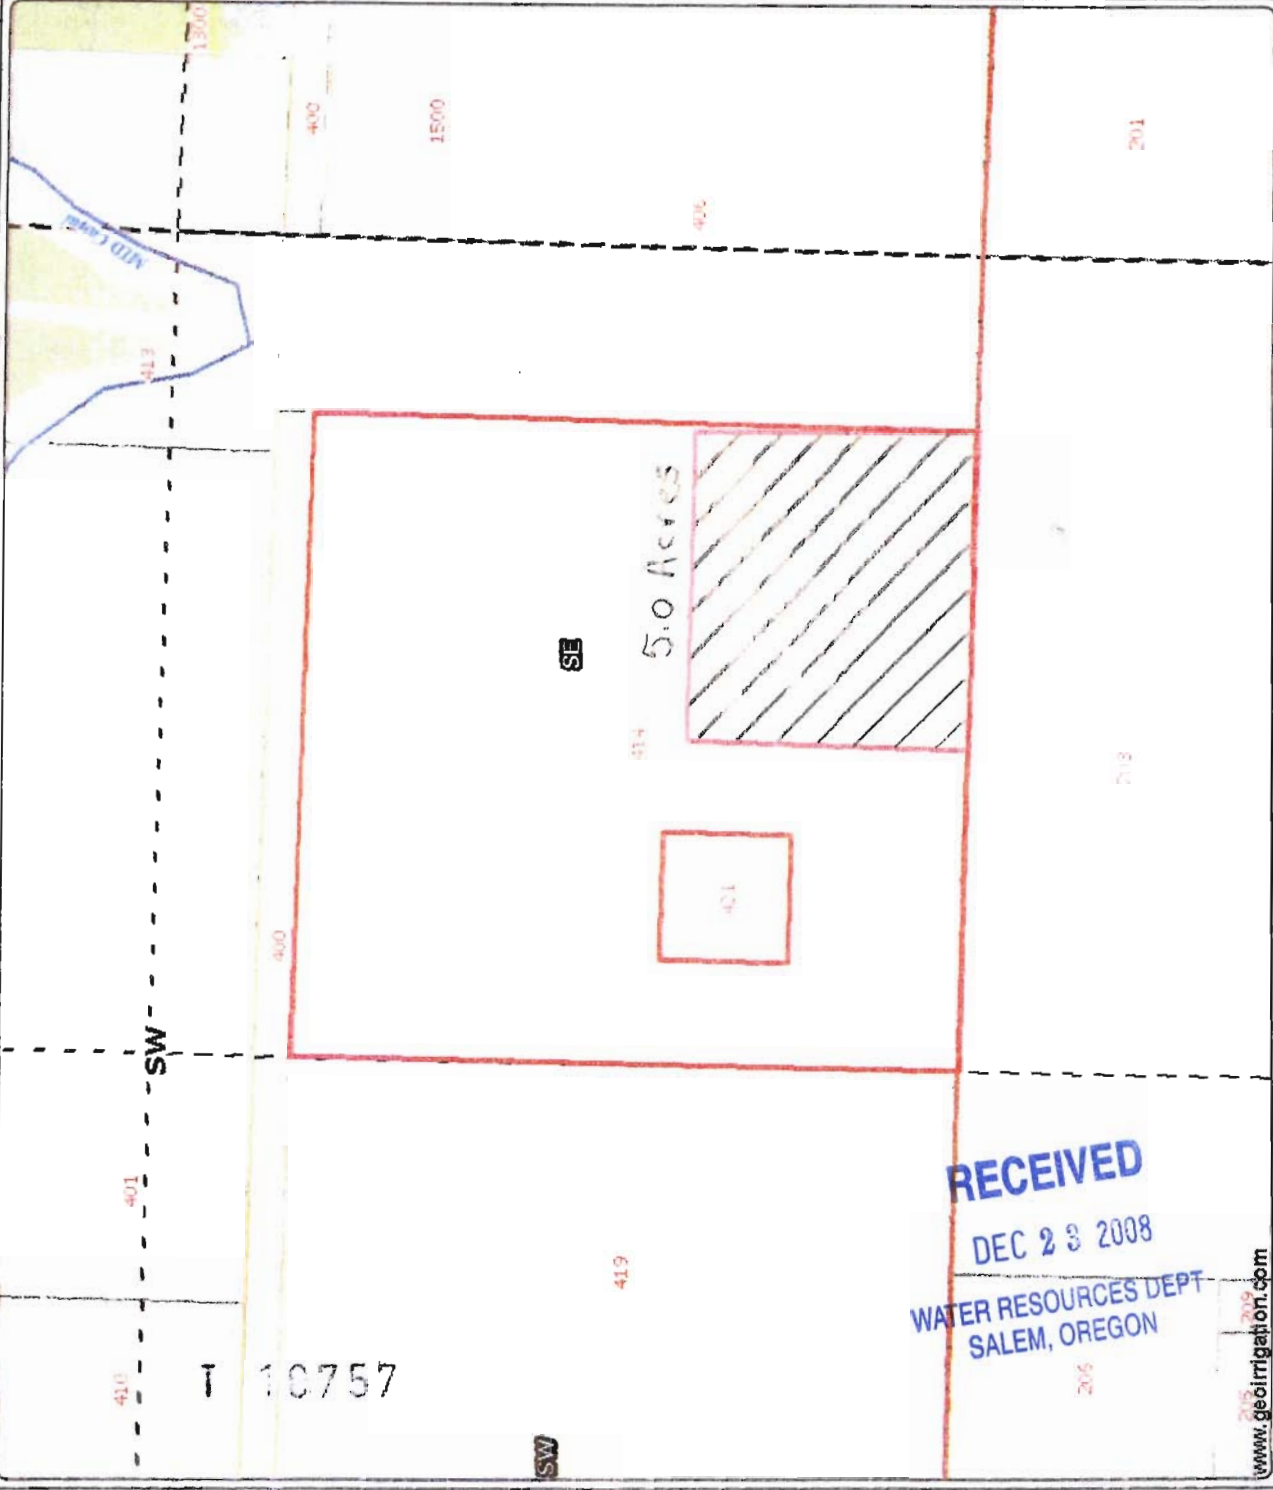

Powered By
geoirrigation

DISCLAIMER: This map is intended for display purposes only and is not intended for any legal representations. There are no warranties, expressed or implied, that accompany this product.

RECEIVED
DEC 23 2008
WATER RESOURCES DEPT
SALEM, OREGON

www.geoirrigation.com

Authorized Place of Use


08-11

Transfer From:
Medford Irrigation District
37 South, Range 1 West,
Section 9 SWSE 5.0 Acres

- District Boundary USBR
- Road Labels
- Township Range
- Sections
- Section Labels
- Quarters
- Quarter Labels
- Quarter Quarters
- Quarter Quarters Labels
- Lot Labels
- Taxlots
- Waterbodies JACK CO
- Irrigation Ditches JACK CO
- Place of Use WORKING

Transfer From:
5.00

Scale 1" = 400.00'
Created: 6/15/2008

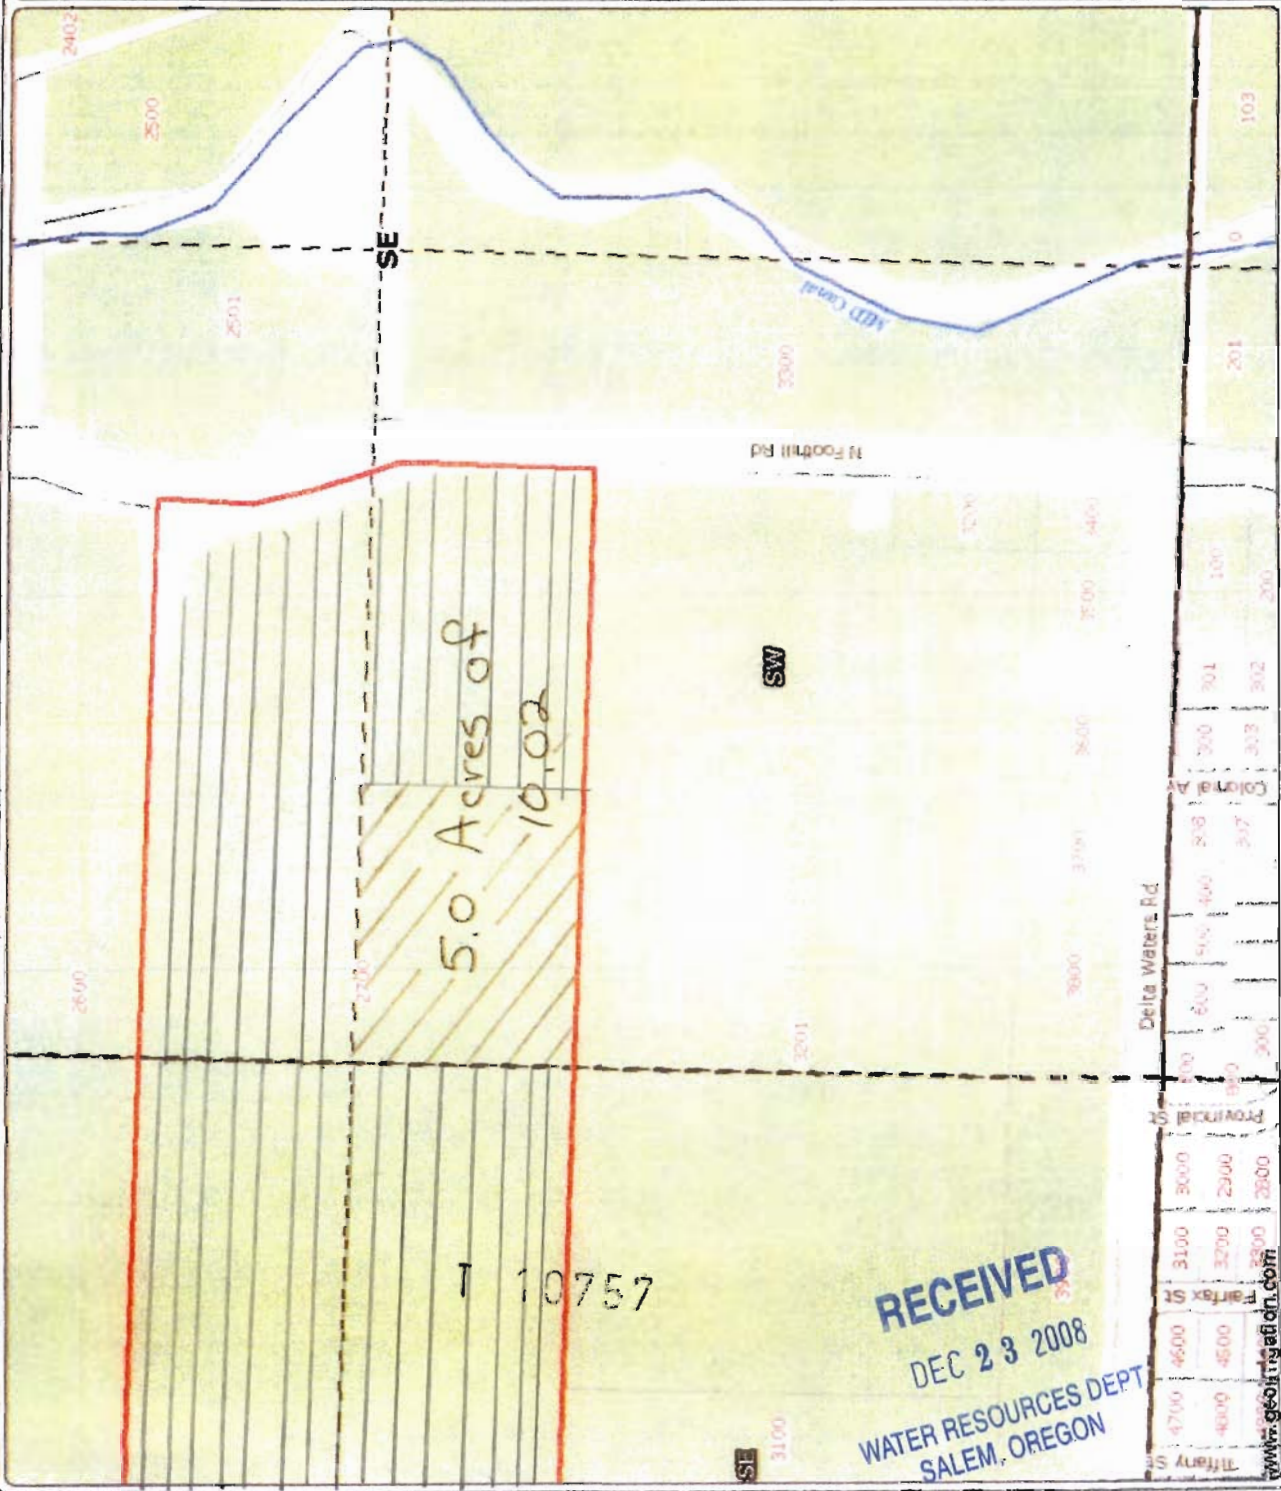

5.0 Acres of
10.02

T 10757

RECEIVED
DEC 23 2008
WATER RESOURCES DEPT
SALEM, OREGON

Powered By
geoIrrigation

DISCLAIMER: This map is intended for display purposes only and is not intended for any legal representations. There are no warranties, expressed or implied, that accompany this product.

www.geoIrrigation.com