


# T.16S.R.7W.W.M.

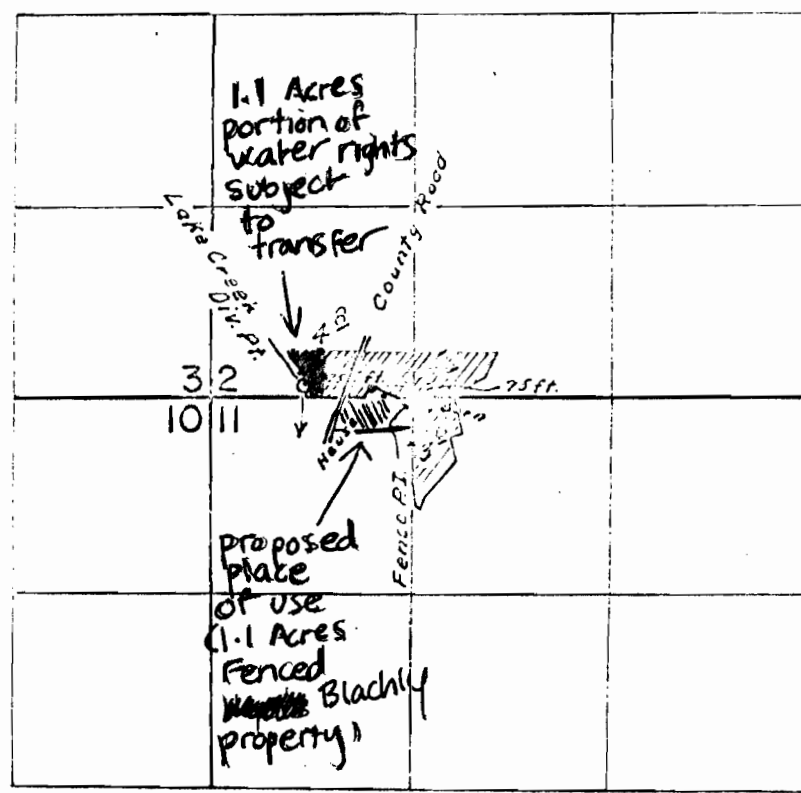

T 10774

## FINAL PROOF SURVEY UNDER

**RECEIVED**

JAN 22 2009

Application No. 37639 Permit No. 28112  
IN NAME OF

WILLIAM A. WAGNER

WATER RESOURCES DEPT  
SALEM, OREGON