G-4354
42330

RECEIVED
JAN 20 2009
WATER RESOURCES DEPT
SALEM, OREGON

T.18&2N. R.26&27E. W.M.

TEMPORARY TRANSFER

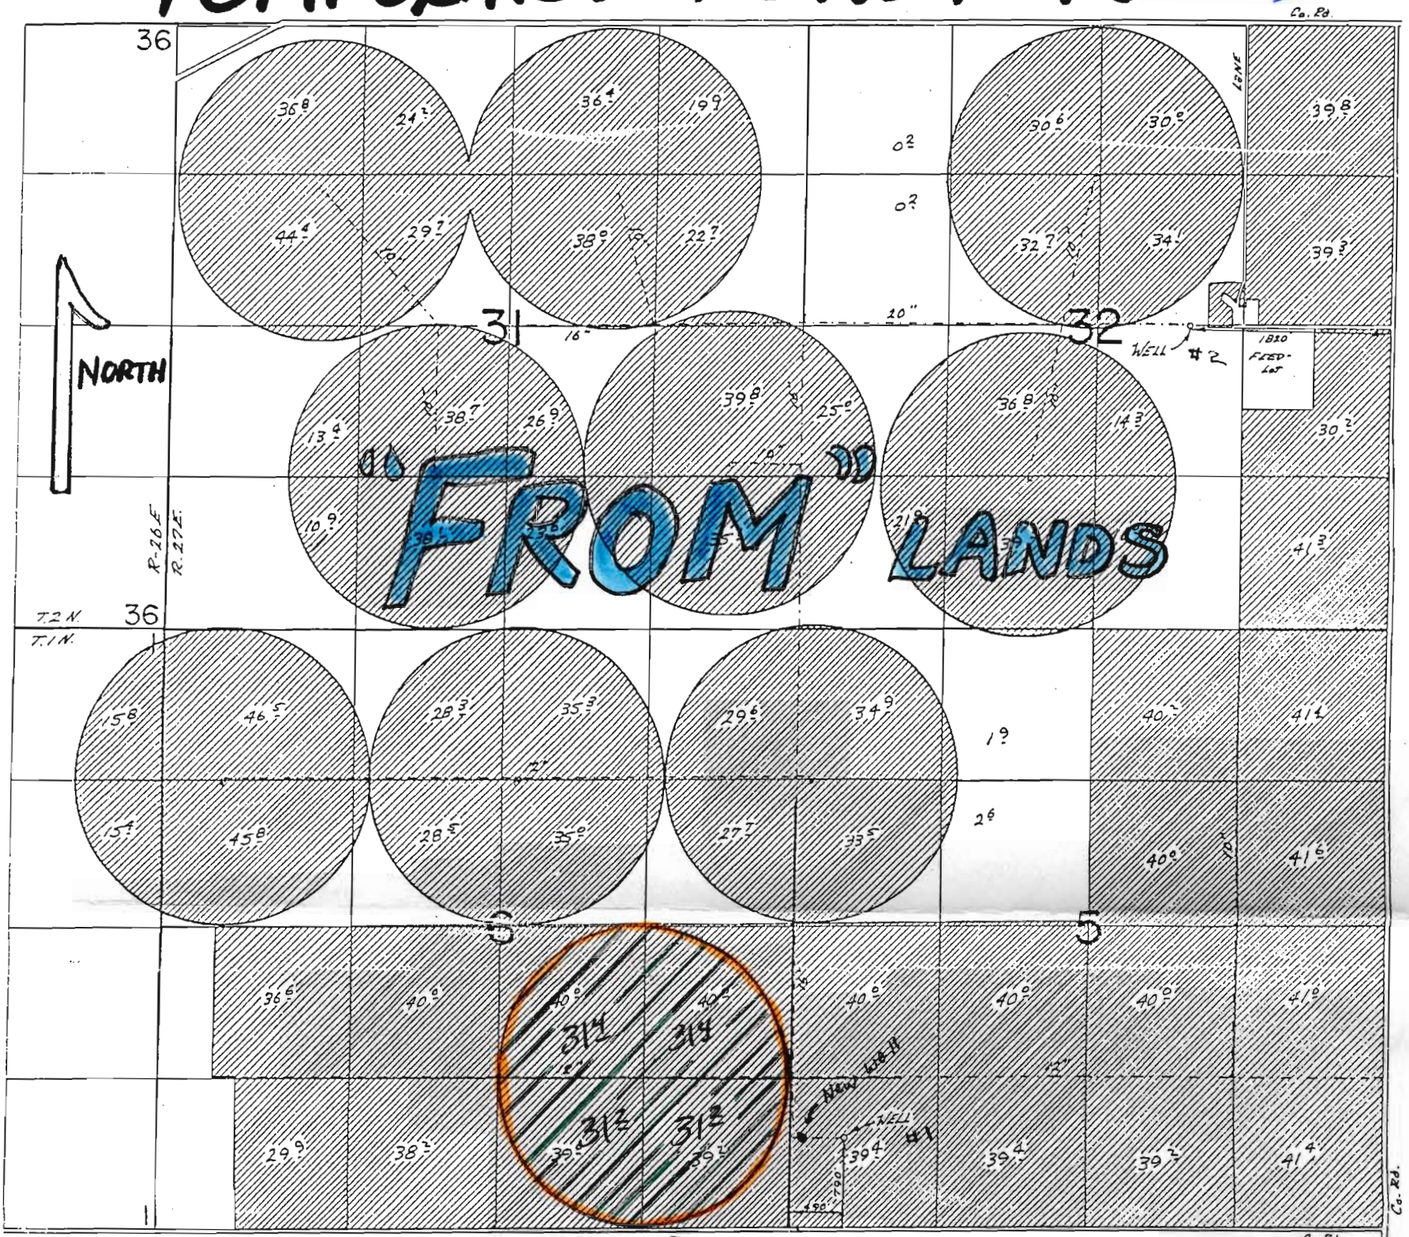

▨ - ΔPOU (CERT. 42330)

• New well Location 825' North, 80' East of SW Corner of Section 5 (SW¼ SW¼) T1N, R27EWm

FINAL PROOF SURVEY
UNDER

SCALE: 1" = 1320'

Application No. G-4629 Permit No. G-4354
IN NAME OF

CAMPBELL RANCH INC.

Surveyed April 18 1974, by T. J. PAUL

See bigger map file

T 10771

172-29, 272-280, 6 1974