


**PROPOSED CHANGES TO PLACE OF USE**

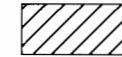

**Authorized POU (No Change)**

No changes proposed to Authorized Place of Use under this Permit Amendment. Permit Holder intends to apply for changes to Authorized Place of Use under separate, related Permit Amendments.


**T5N, R35E, WM  
Sections 3, 4, 5, 8, 9, 10  
T6N, R35E, WM  
Sections 31 and 32  
UMATILLA COUNTY**

1 in = 1320 ft

**RECEIVED**  
JAN 28 2009  
WATER RESOURCES DEPT  
SALEM, OREGON

**PROPOSED CHANGES TO POINTS OF APPROPRIATION**

- **Authorized POA (No Change)**
  - POA 3B remains in NW/4 NE/4 S10, T5N, R35E, WM at a location 666 feet S and 1761 feet W from NE Corner S10.
  - POA 4B remains in NE/4 NE/4 S9, T5N, R35E, WM at a location 800 feet W and 380 feet S from NE Corner S9.
  - POA 5A remains in SW/4 NE/4 S5, T5N, R35E, WM at a location 61 feet N and 1292 feet E from Center S5.
  - POA 5B remains in SE/4 NE/4 S5, T5N, R35E, WM at a location 1090 feet W and 1615 feet S from NE Corner S5.
  - POA 5C remains in SE/4 SW/4 S32, T6N, R35E, WM at a location 612 feet N and 1985 feet E from SW Corner S32.
  - UMAT 50516 remains in NE/4 NW/4 S4, T5N, R35E, WM at a location 335 feet S and 1516 feet E from NW Corner S4.
- ⊕ **Authorized POA (Change FROM)**
  - POA 3A relocate from SW/4 SE/4, S3, T6N, R35E, WM, 2900 feet E and 1225 feet N from SW Corner S3.
  - POA 4A relocate from NE/4 SW/4, S4, T6N, R35E, WM, 2960 feet S and 3140 feet W from NE Corner S4.
- ⊙ **Proposed POA (Change TO)**
  - POA 3A relocate to SW/4 SE/4, S3, T6N, R35E, WM at a location 1156 feet N and 314 feet E from S/4 Corner S3 (Well Log UMAT 55526).
  - POA 4A relocate to NE/4 SW/4, S4, T6N, R35E, WM at a location 415 feet S and 500 feet W from Center S4 (Well Log UMAT 55523).
- ⊙ **Proposed POA (Additional)**
  - POA 4C in NW/4 SW/4, S4, T6N, R35E, WM at a location 50 feet S and 1400 feet W from Center S4 (new, additional potential well site).
  - POA 4D in NE/4 SW/4, S4, T6N, R35E, WM at a location 375 feet S and 940 feet W from Center S4 (new, additional potential well site).
  - POA 4E in NW/4 NW/4, S4, T6N, R35E, WM at a location 335 feet S and 1466 feet E from NW Corner S4 (potential replacement of well UMAT 50516).

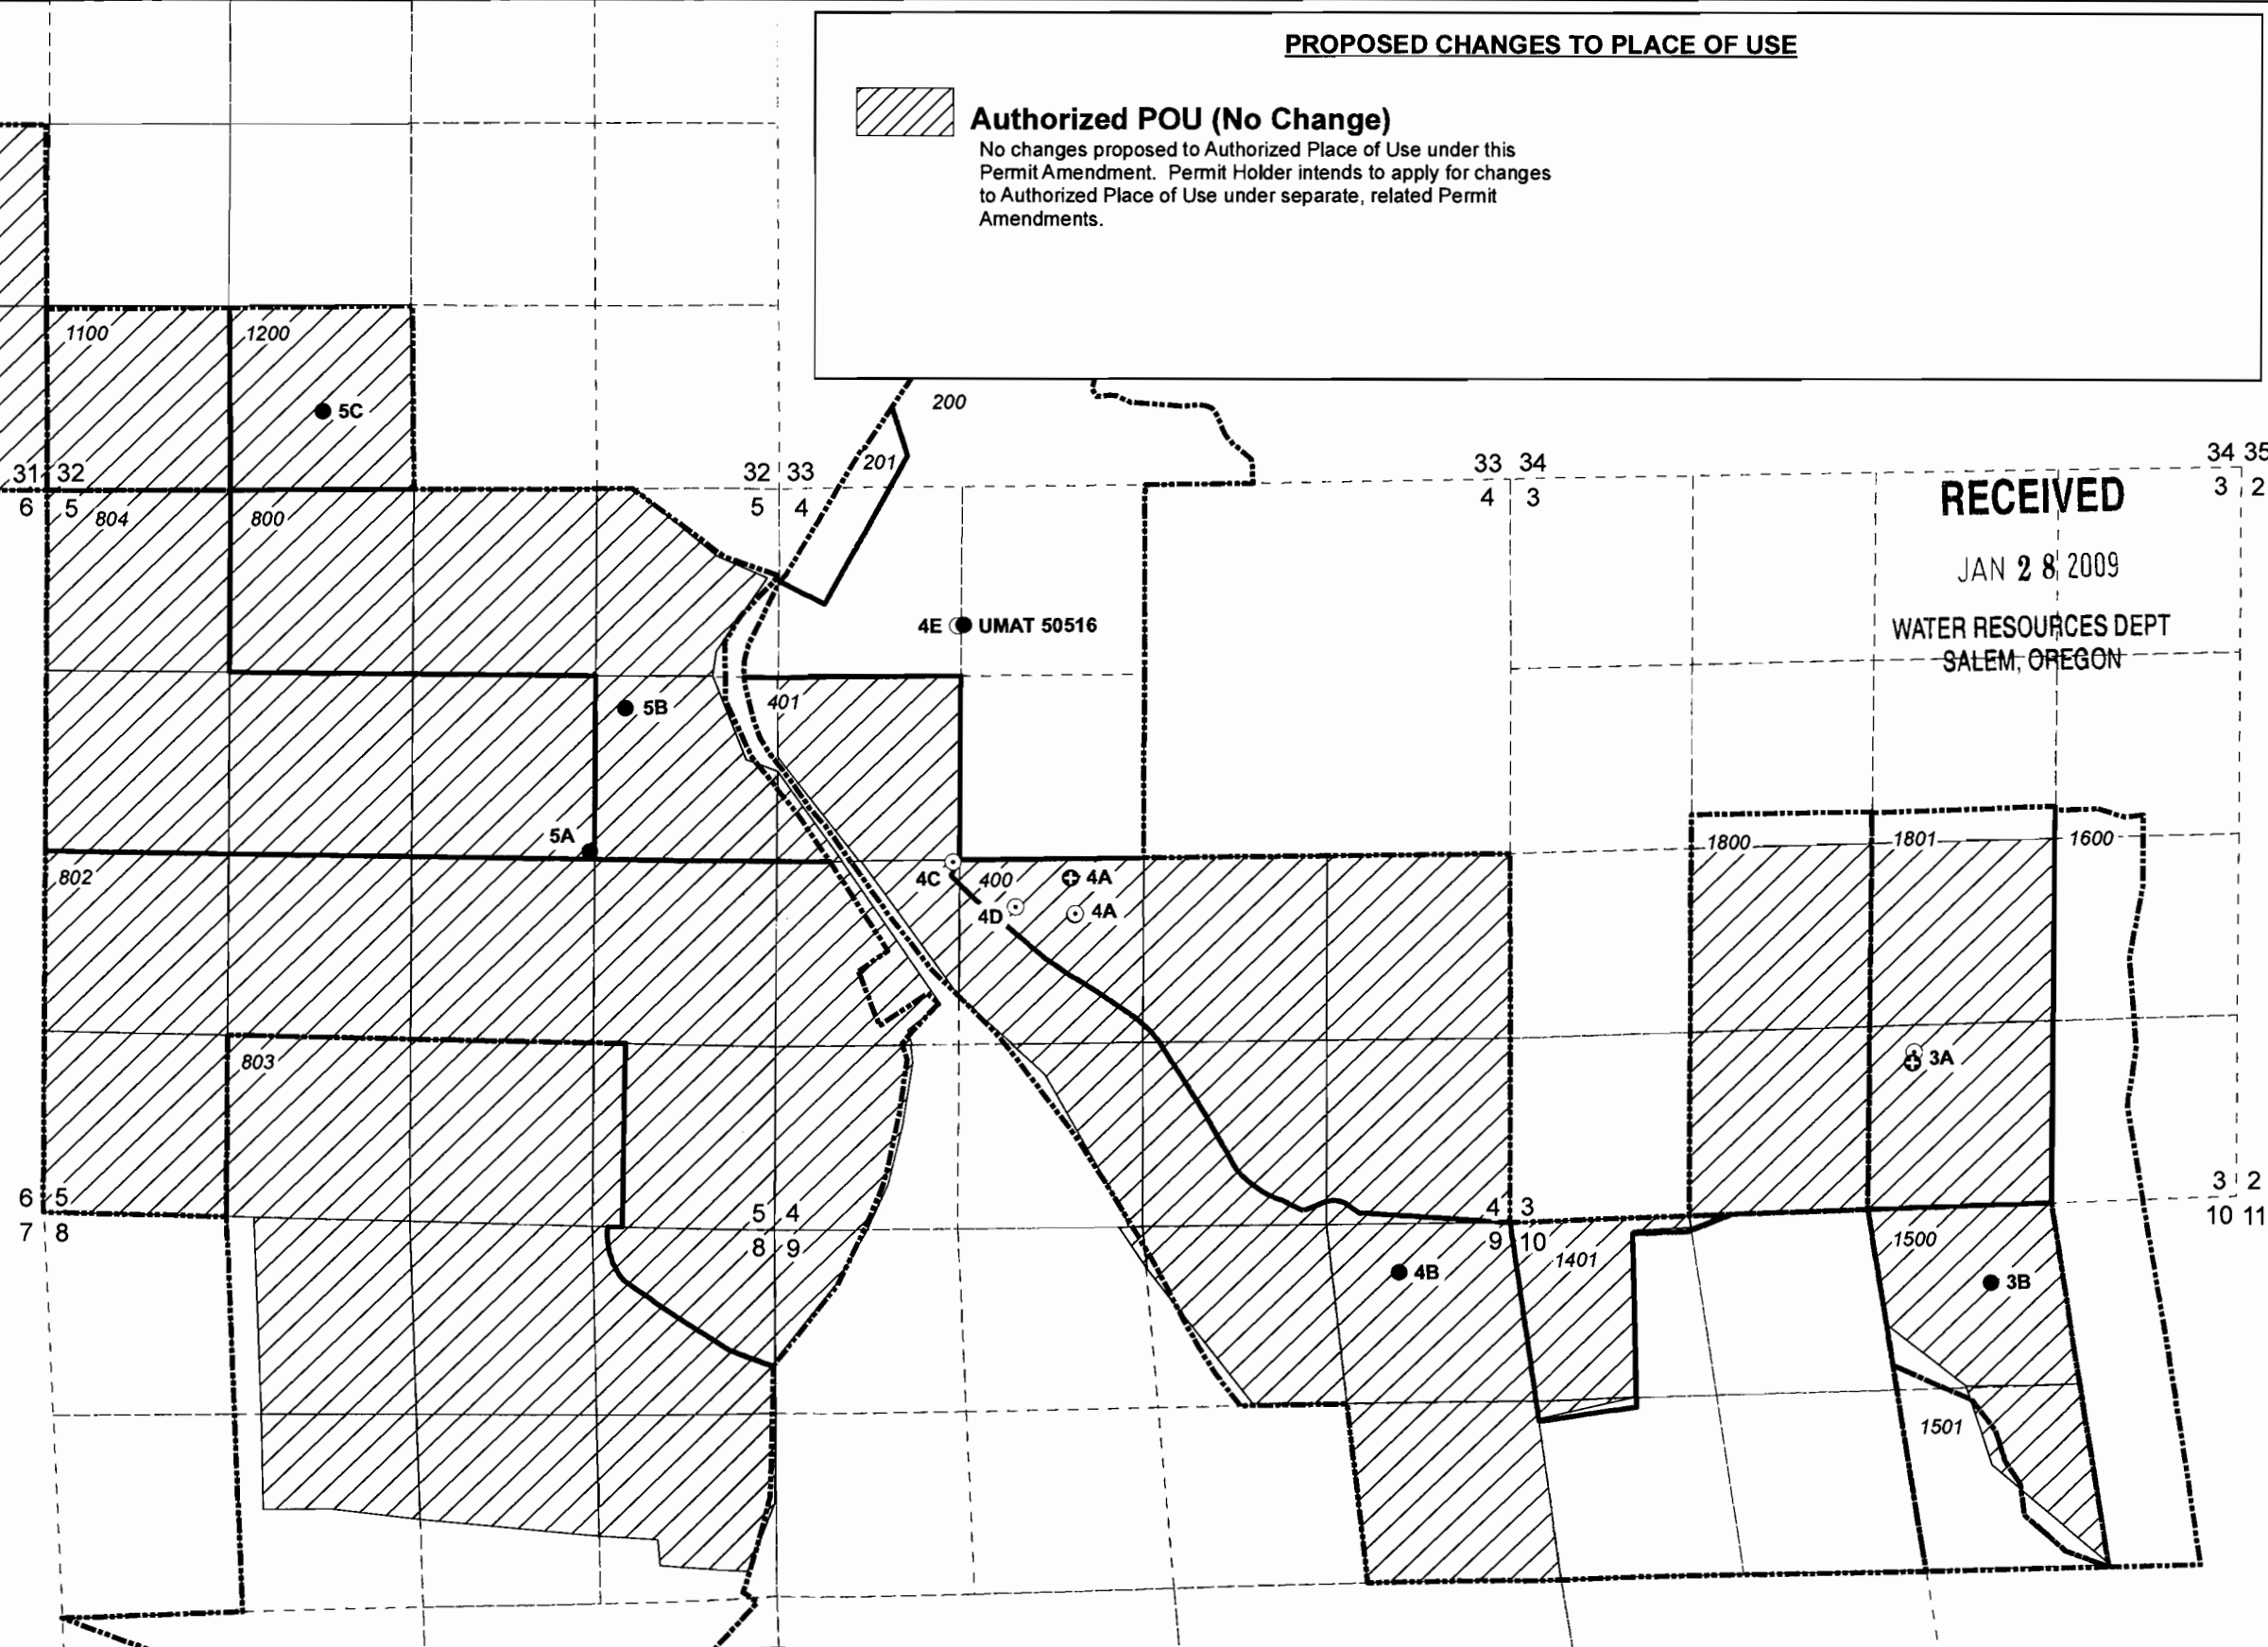

The purpose of this map is to identify the location of a water right. It is not intended to provide information regarding the location of property ownership lines.

FOUNTAINHEAD  
1204 Alvarado Terrace  
Walla Walla, WA 99362  
(509) 529-2646 phone

Certified Water Right Examiner  
358  
*John S. Warinner*  
John S. Warinner  
May 18, 1993  
STATE OF OREGON

**PERMIT AMENDMENT MAP**  
**Application G-16322**  
**Permit G-15883**  
SEVEN HILLS PROPERTIES  
POA Location Amendment  
Revised 23 JAN 2009

T 10777