

Temporary Transfer Maps

Map Source:

Geo-Spatial Solutions

Color Codes:

FROM Acres: **Pink** 79442 (1905 Priority w/79440)

TO Acres: **Purple** 79442 (1905 Priority w/79440)

RECEIVED
FEB 19 2009
WATER RESOURCES DEPT
SALEM, OREGON


T 0784

Stanfield Irrigation District

Point of Delivery - T 3N R
30E SEC 31

Located 380' North and
650' East from the SW Corner of
Section 31

- District Boundary
- Highways
- Major Roads
- Roads
- Road Labels
- Township Range
- Sections
- Section Labels
- Quarters
- Quarter Labels
- Quarter Quarters
- Quarter Quarter Labels
- Taxlots
- NHD Waterbody
- NHD Stream/River Area

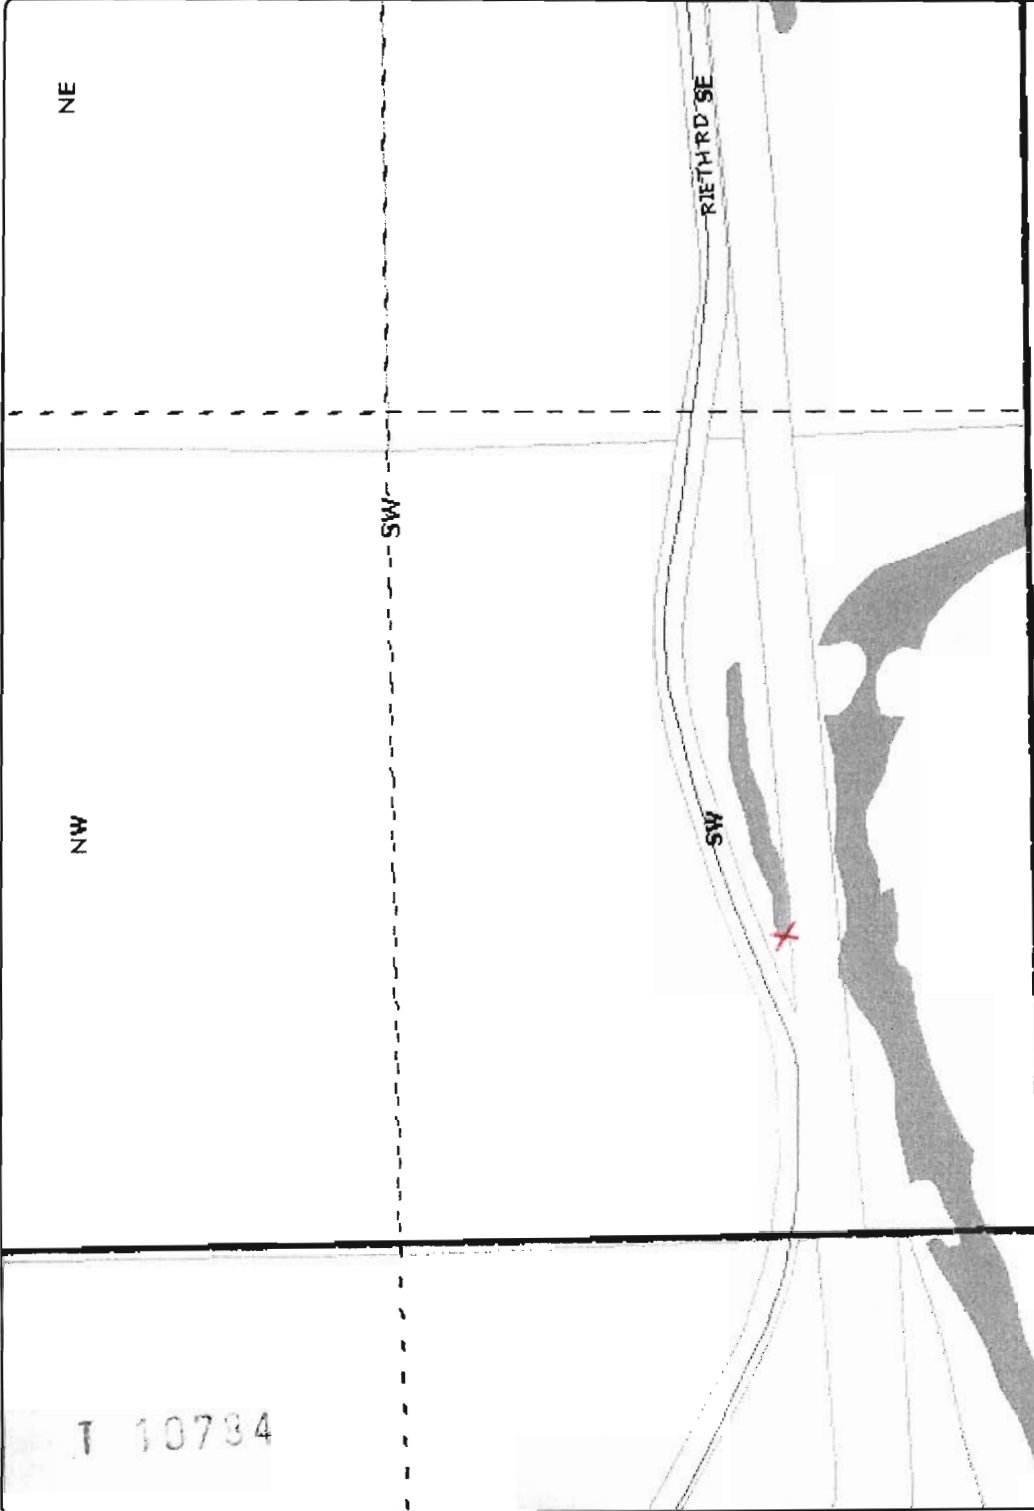

RECEIVED

FEB 19 2009

WATER RESOURCES DEPT
SALEM, OREGON



Scale 1" = 400'
Created: 2/16/2009

T 10784

Stanfield Irrigation District

T 4N R 29E SEC 18 TXLT
1700

NESW 2.1 ACRES/ SESW 11.5
ACRES

- Distnd. Boundary
- Highways
- Major Roads
- Roads
- Road Labels
- Township Range
- Sections
- Section Labels
- Quarters
- Quarter Labels
- Quarter Quarters
- Quarter Quarter Labels
- Lot Labels
- Taxlots
- POU District Primary
- NHD Waterbody
- NHD Stream/River Area

RECEIVED

FEB 19 2009

WATER RESOURCES DEPT
SALEM, OREGON



Scale 1" = 400'
Created: 2/2/2009



www.mesajoinformation.com


DISCLAIMER: This map is intended for display purposes only and is not intended for any legal representations. There are no warranties, expressed or implied, that accompany this product.

Stanfield Irrigation District

T 4N R 29E SEC. 14 TXLT
2400

2.0 ACRES

- District Boundary
- Highways
- Major Roads
- Roads
- Road Labels
- Township Range
- Sections
- Section Labels
- Quarters
- Quarter Labels
- Quarter Quarters
- Quarter Quarter Labels
- Lot Labels
- Taxlots
- POU District Primary
- NHD Waterbody
- NHD Stream/River Area

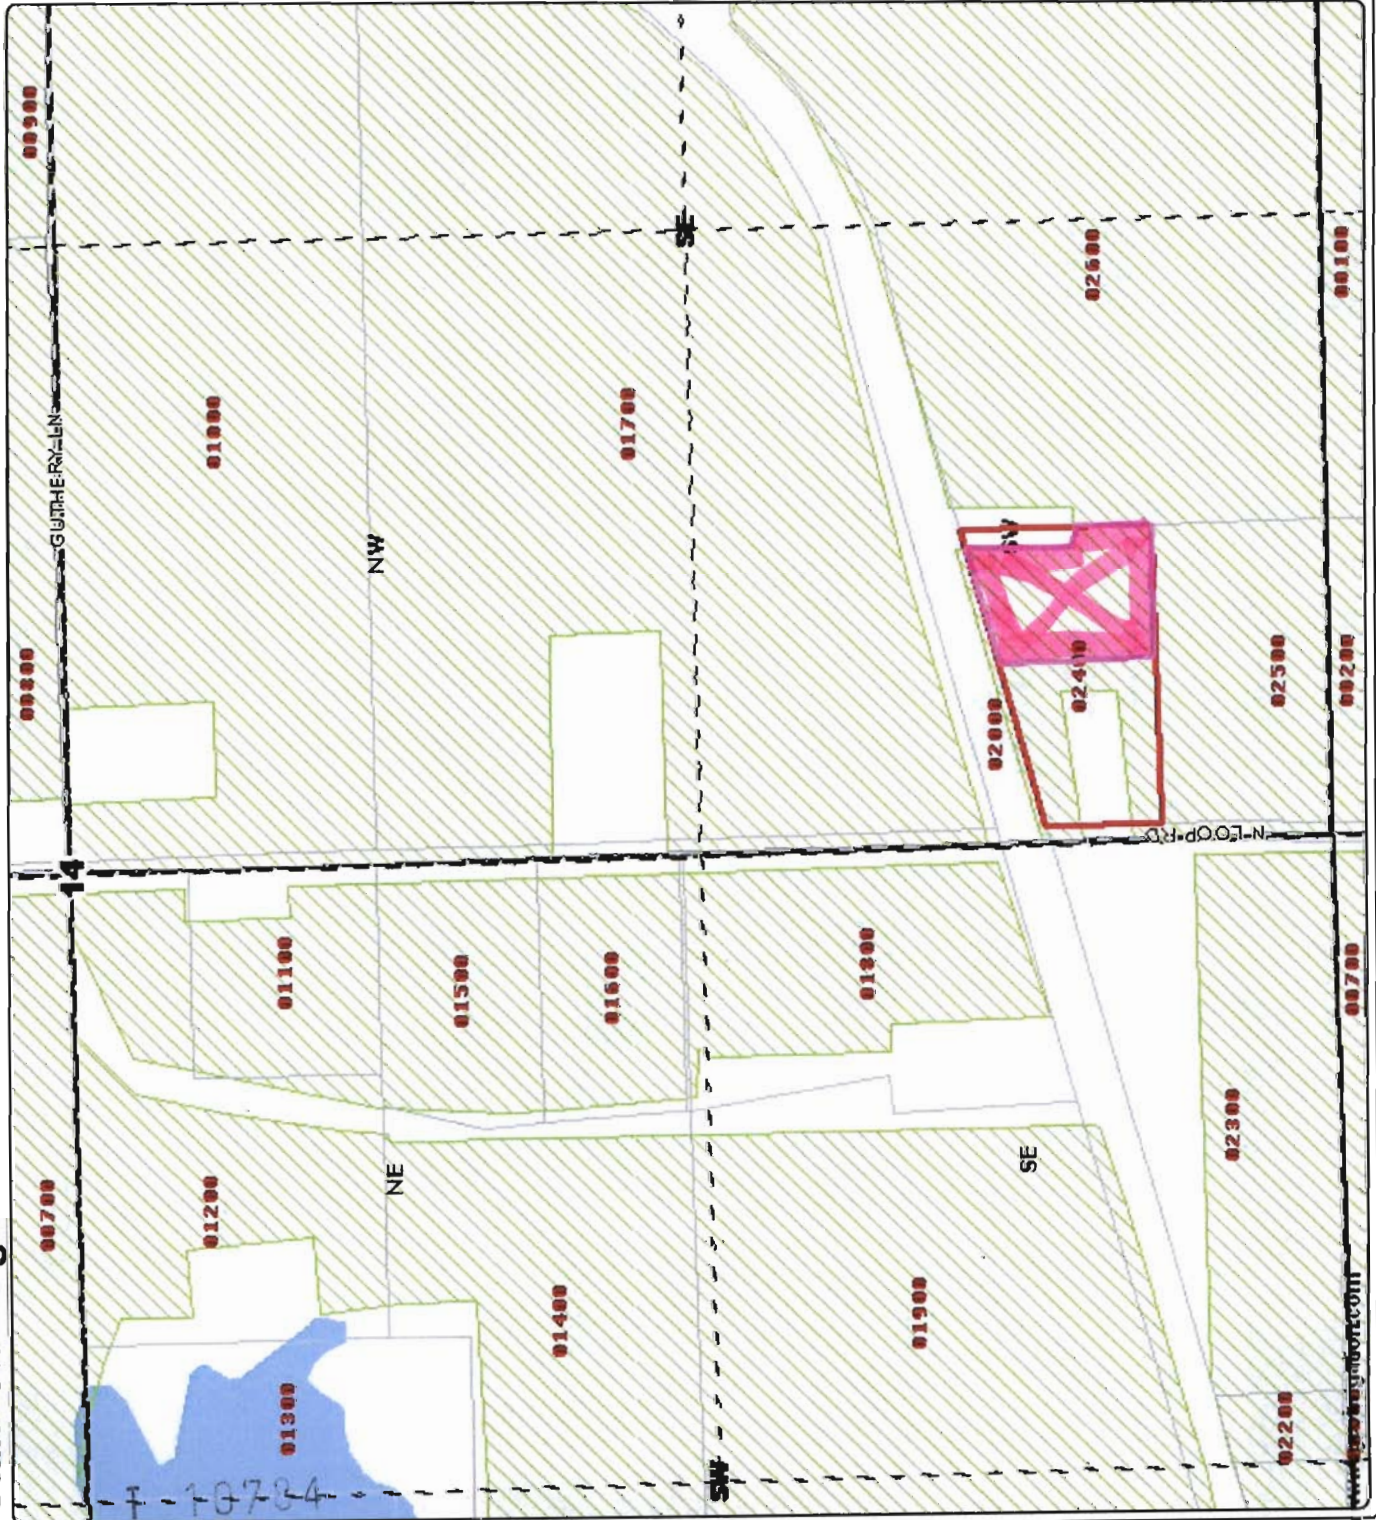

RECEIVED
FEB 19 2009
WATER RESOURCES DEPT
SALEM, OREGON



Scale 1" = 400'
Created: 2/2/2009

DISCLAIMER: This map is intended for display purposes only and is not intended for any legal representations. There are no warranties, expressed or implied, that accompany this product.

Stanfield Irrigation District

T 4N R 29E SEC 26 TXLT
4001

NESE 4.25 ACRES/NWSE 11.35
ACRES

- District Boundary
- Highways
- Major Roads
- Roads
- Road Labels
- Township Range
- Sections
- Section Labels
- Quarters
- Quarter Labels
- Quarter Quarters
- Quarter Quarter Labels
- Lot Labels
- Taxlots
- POU District Primary
- NHD Waterbody
- NHD Stream/River Area

RECEIVED


FEB 19 2009

WATER RESOURCES DEPT
SALEM, OREGON



Scale 1" = 400'

Created: 2/2/2009

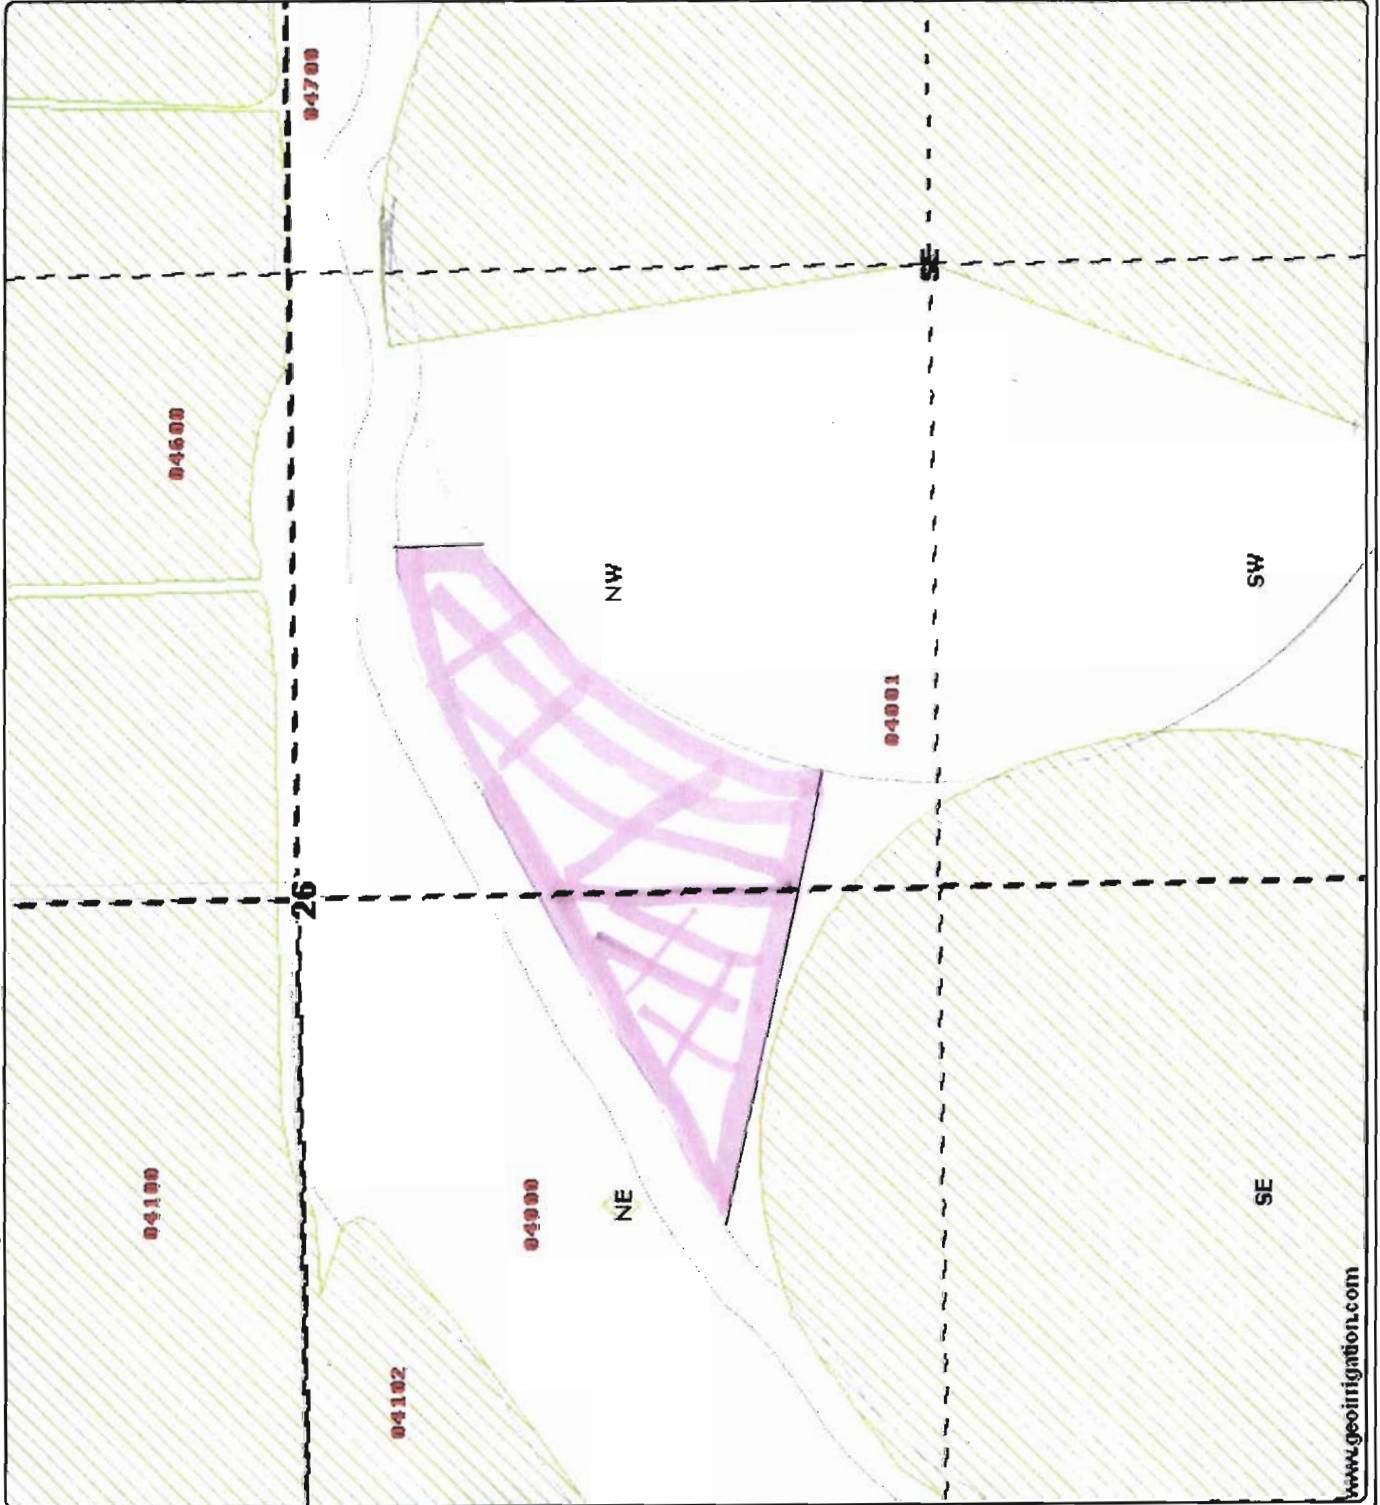


DISCLAIMER: This map is intended for display purposes only and is not intended for any legal representations. There are no warranties, expressed or implied, that accompany this product.

T 10734