


049

T.26S. R.19E., W.M.

TAX LOTS 500, 600, 701, 800, 900 & 1000

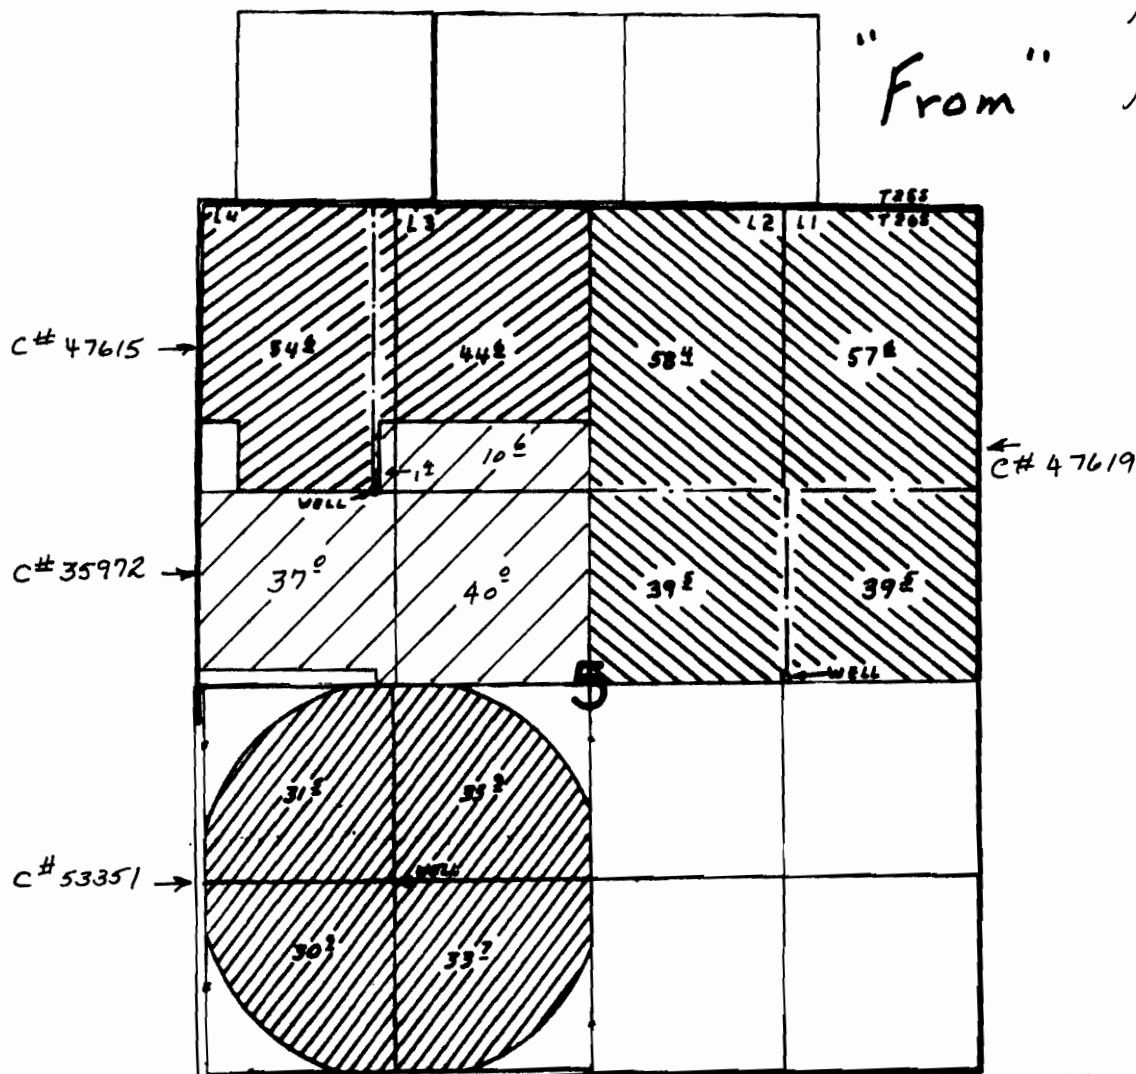

Well LOC: 1990' S & 1200' E From NW corner, SEC 5 - C# 35972, C# 47615
 1970' S & 1190' E From NW corner, SEC 5

Scale: 1"=1320'

Well LOC: 3250' S & 1280' W from NE corner, SEC 5 - C# 47619

Well LOC: 1320' N & 1390' E from SW corner, SEC 5 - C# 53351

RECEIVED

FEB 11 2009


WATER RESOURCES DEPT
 SALEM, OREGON

T 10781

T 26 S, R 19 E, WM SECTION 5

Tax Lots 500, 600, 701, 800, 900 & 1000

To

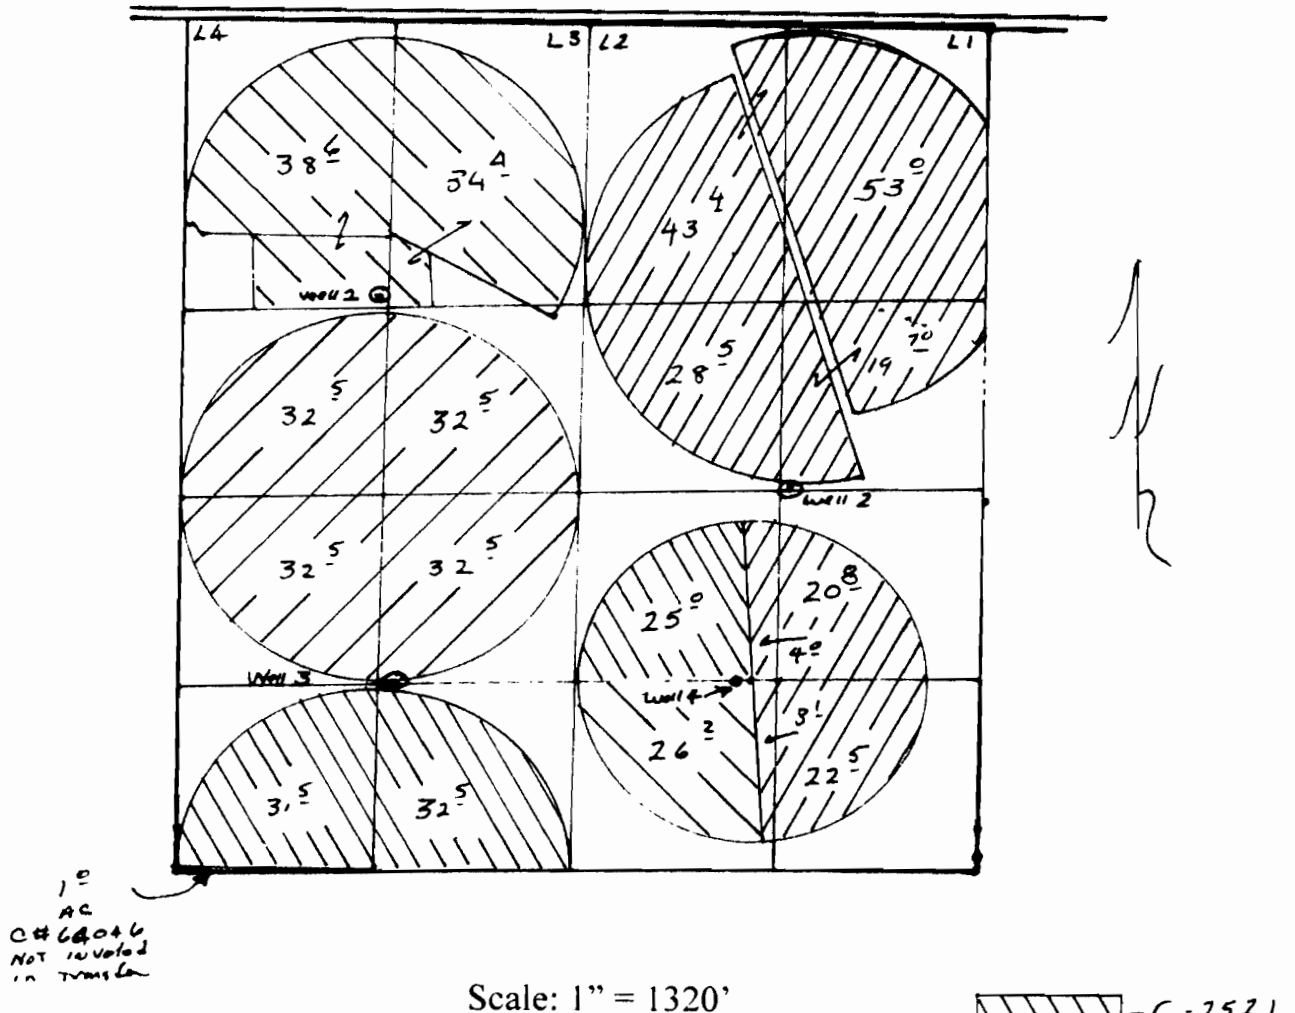

Wells Located:

- #1 - 1950' S & 1210' E from the NW Corner, Section 5.
- #2 - 3250' S & 1280' W from the NE Corner, Section 5.
- #3 - 1320' N & 1390' E from the SW Corner, Section 5.
- #4 - 1320' N & 1680' W from the SE Corner, Section 5.

RECEIVED

FEB 11 2009

WATER RESOURCES DEPT
SALEM, OREGON

T 10781