


MAP TO ACCOMPANY APPLICATION TO CHANGE PLACE OF USE FOR MAX BOWEN

TOWNSHIP 27 SOUTH, RANGE 15 EAST, W.M.
LAKE COUNTY, OREGON

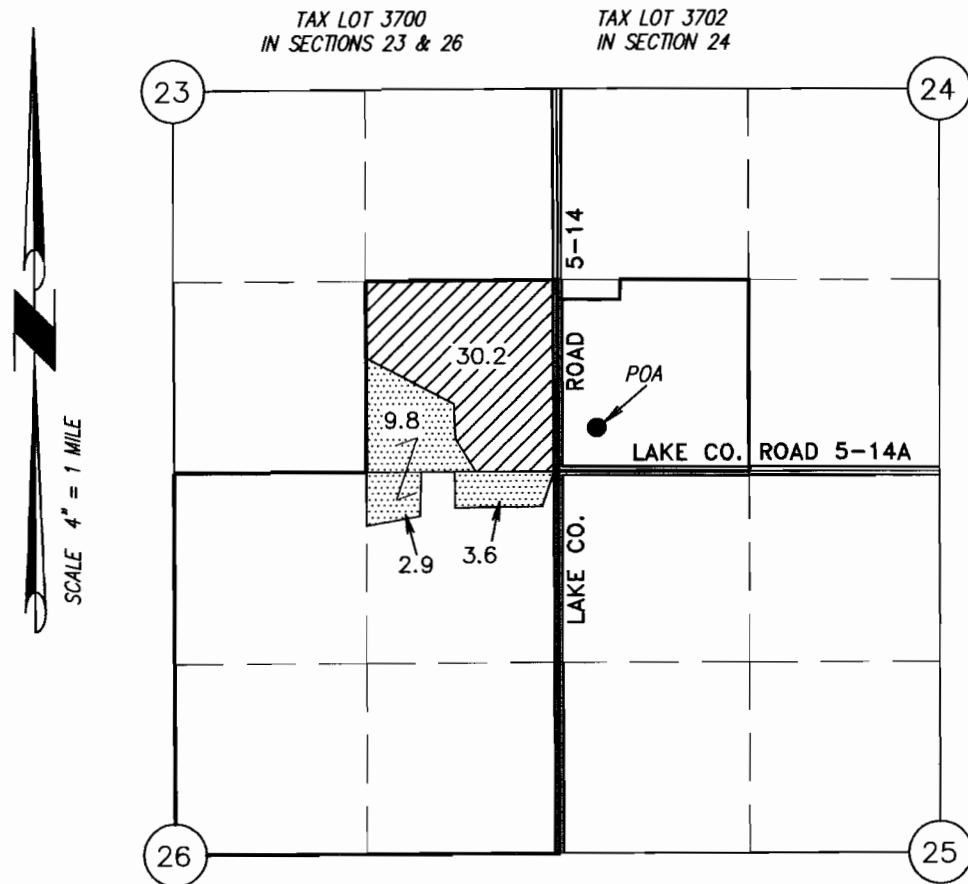

● OLD P.O.A.
WELL LOCATED IN SW 1/4 SW 1/4, SECTION 24, T27S, R15E, W.M.; AND 300 FEET NORTH
AND 260 FEET EAST FROM THE SW CORNER OF SECTION 24. WELL LOGS LAKE 830 & 831.


- 30.2 ACRES EXISTING WATER RIGHTS FROM CERTIFICATE No. 41932 (U-410), AS SHOWN.
- 16.3 ACRES EXISTING WATER RIGHTS FROM CERTIFICATE No. 65573 (G-10174), AS SHOWN.

AREAS SHOWN ABOVE AS "IN" AND "OUT" REFLECT RIGHTS BEING TRANSFERRED "TO" AND "FROM" RESPECTIVELY. AREAS SHOWN WITHOUT "IN" OR "OUT" REFLECT RIGHTS TO REMAIN IN PLACE.

THIS MAP IS FOR THE PURPOSE OF LOCATING A WATER RIGHT ONLY AND HAS NO INTENT TO PROVIDE LEGAL DIMENSIONS OR THE LOCATION OF PROPERTY LINES.

T 10736

TOWNSHIP 27 SOUTH, RANGE 15 EAST, W.M.
LAKE COUNTY, OREGON

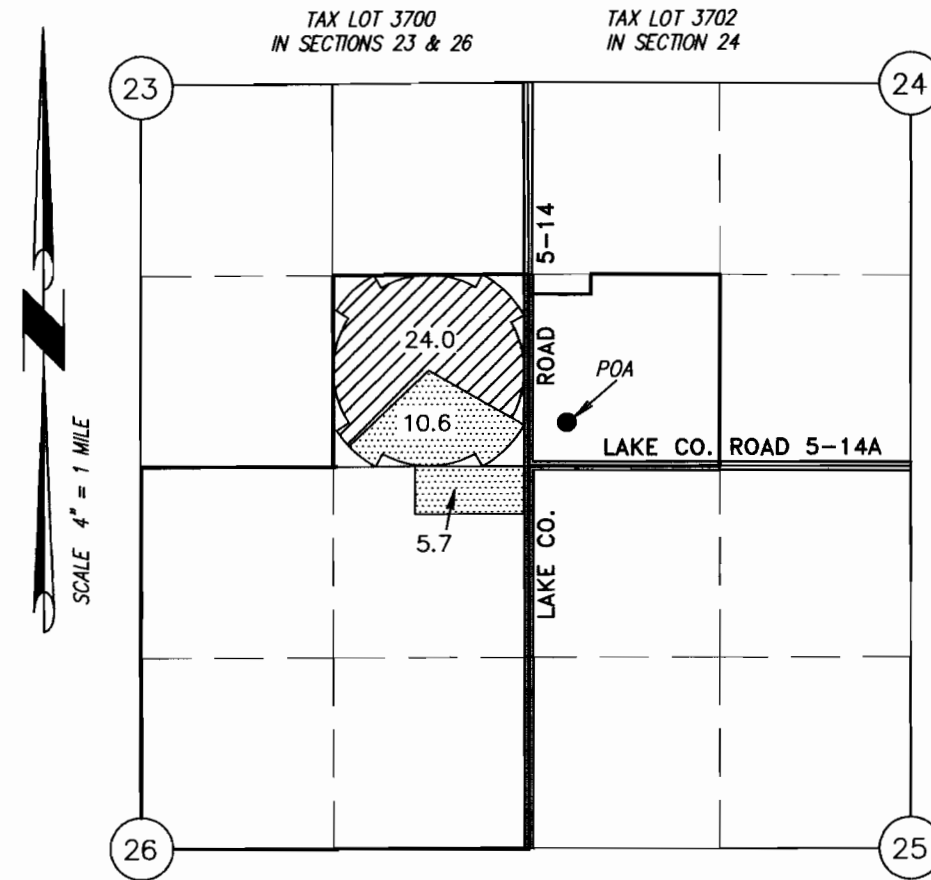

- 24.0 ACRES WATER RIGHTS FROM CERTIFICATE No. 41932 (U-410), AS SHOWN.
- 16.3 ACRES WATER RIGHTS FROM CERTIFICATE No. 65573 (G-10174), AS SHOWN.

RECEIVED


FEB 27 2009
WATER RESOURCES DEPT
SALEM, OREGON

PROJECT No. 08-069

PREPARED AT THE REQUEST OF:
MAX BOWEN
56146 ARROW GAP ROAD
SILVER LAKE, OR 97638

ALL POINTS ENGINEERING
& SURVEYING, INC.

P.O. BOX 767 (CRR)
TERREBONNE, OREGON 97760
(541) 548-5833 PH
(541) 585-4602 FX
www.APEandS.com

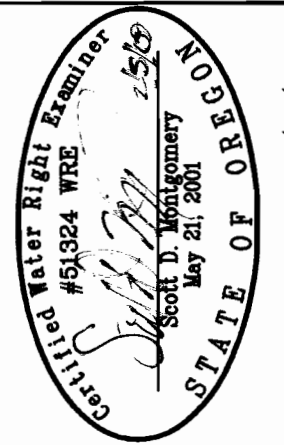

RENEWAL DATE: 12/31/2010