

Salem, Oregon

012858

Well Record

STATE WELL NO. 4/1-2 E
COUNTY CLACKAMAS
APPLICATION NO. GR-251

OWNER: John Webber

MAILING

ADDRESS: Rt. 1, Box 309

LOCATION OF WELL: Owner's No.


CITY AND

STATE: Canby, Oregon

SW $\frac{1}{4}$ NW $\frac{1}{4}$ Sec. 2 T. 4 S. R. 1 E. W.M.

Bearing and distance from section or subdivision

corner S. 12° E. 2525'

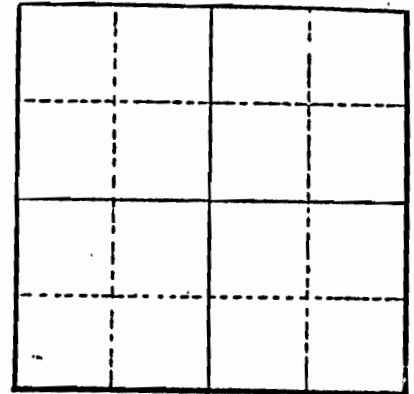

Section

Altitude at well

TYPE OF WELL: Drilled. Date Constructed 1954

Depth drilled 210 Depth cased 194.5

CASING RECORD:

16-inch

FINISH: 110' - 12 holes
109' - 12 holes
120' - 12 holes
121' - 12 holes

122' - 12 holes
123' - 12 holes
124' - 12 holes
125' - 12 holes

126' - 12 holes
127' - 12 holes

AQUIFERS:

Clay, gravel, sand

WATER LEVEL:

44-feet

PUMPING EQUIPMENT: Type Western Land Roller Turbine H.P. 7
Capacity 800 G.P.M.

WELL TESTS:

Drawdown 97 ft. after hours Pumping 900 G.F

Drawdown 82 ft. after hours Pumping 700 G.F

USE OF WATER Irrigation Temp. °F. 19

SOURCE OF INFORMATION GR-2381

DRILLER or DIGGER

ADDITIONAL DATA:

Log X Water Level Measurements Chemical Analysis Aquifer Test

REMARKS:

RECEIVED

MAR 12 2009

WATER RESOURCES DEPT
SALEM, OREGON

STATE ENGINEER
Salem, Oregon

State Well No. 4/1-21
County CLACKAMAS
Application No. GR-251

Well Log

Owner: John Webber Owner's No.

Driller: Date Drilled 1954

CHARACTER OF MATERIAL	(Feet below land surface)		Thick- ness (ft)
	From	To	
Surface	5		5
Sandy clay	38		33
Cement gravel small amt. of water	49		11
Cement gravel & muddy	62		13
Cement gravel muddy, very little water	80		18
Cement gravel muddy some sand	90		10
Small gravel, water to small to perforate	94		4
Soft clay with sand streaks carrying water	104		10
Grey clay, no water	109		5
Nice gravel-perforated	110		1
Broken sand & clay, muddy some water	116		6
Coarse black sand, lots of water	120		4
Nice gravel-perforated	125		5
Large gravel and clay-very muddy	129		4
Soft greenish clay sandy	155		26
Grey sand-40 gal./min.	162		7
Grey clay	166		4
Grey sand-20 gal./min.	169		3
Blue clay	174		5
Sandy clay-some wood	181		7
Broken sand with streaks of black clay	185		4
Soft clay with small streaks of small gravel, some water	191		6
Tough blue clay	201		10

RECEIVED

MAR 12 2009

WATER RESOURCES DEPT
SALEM, OREGON

T 100.1