


Application #2
"Revert" Transfer

Webber - GR Mod

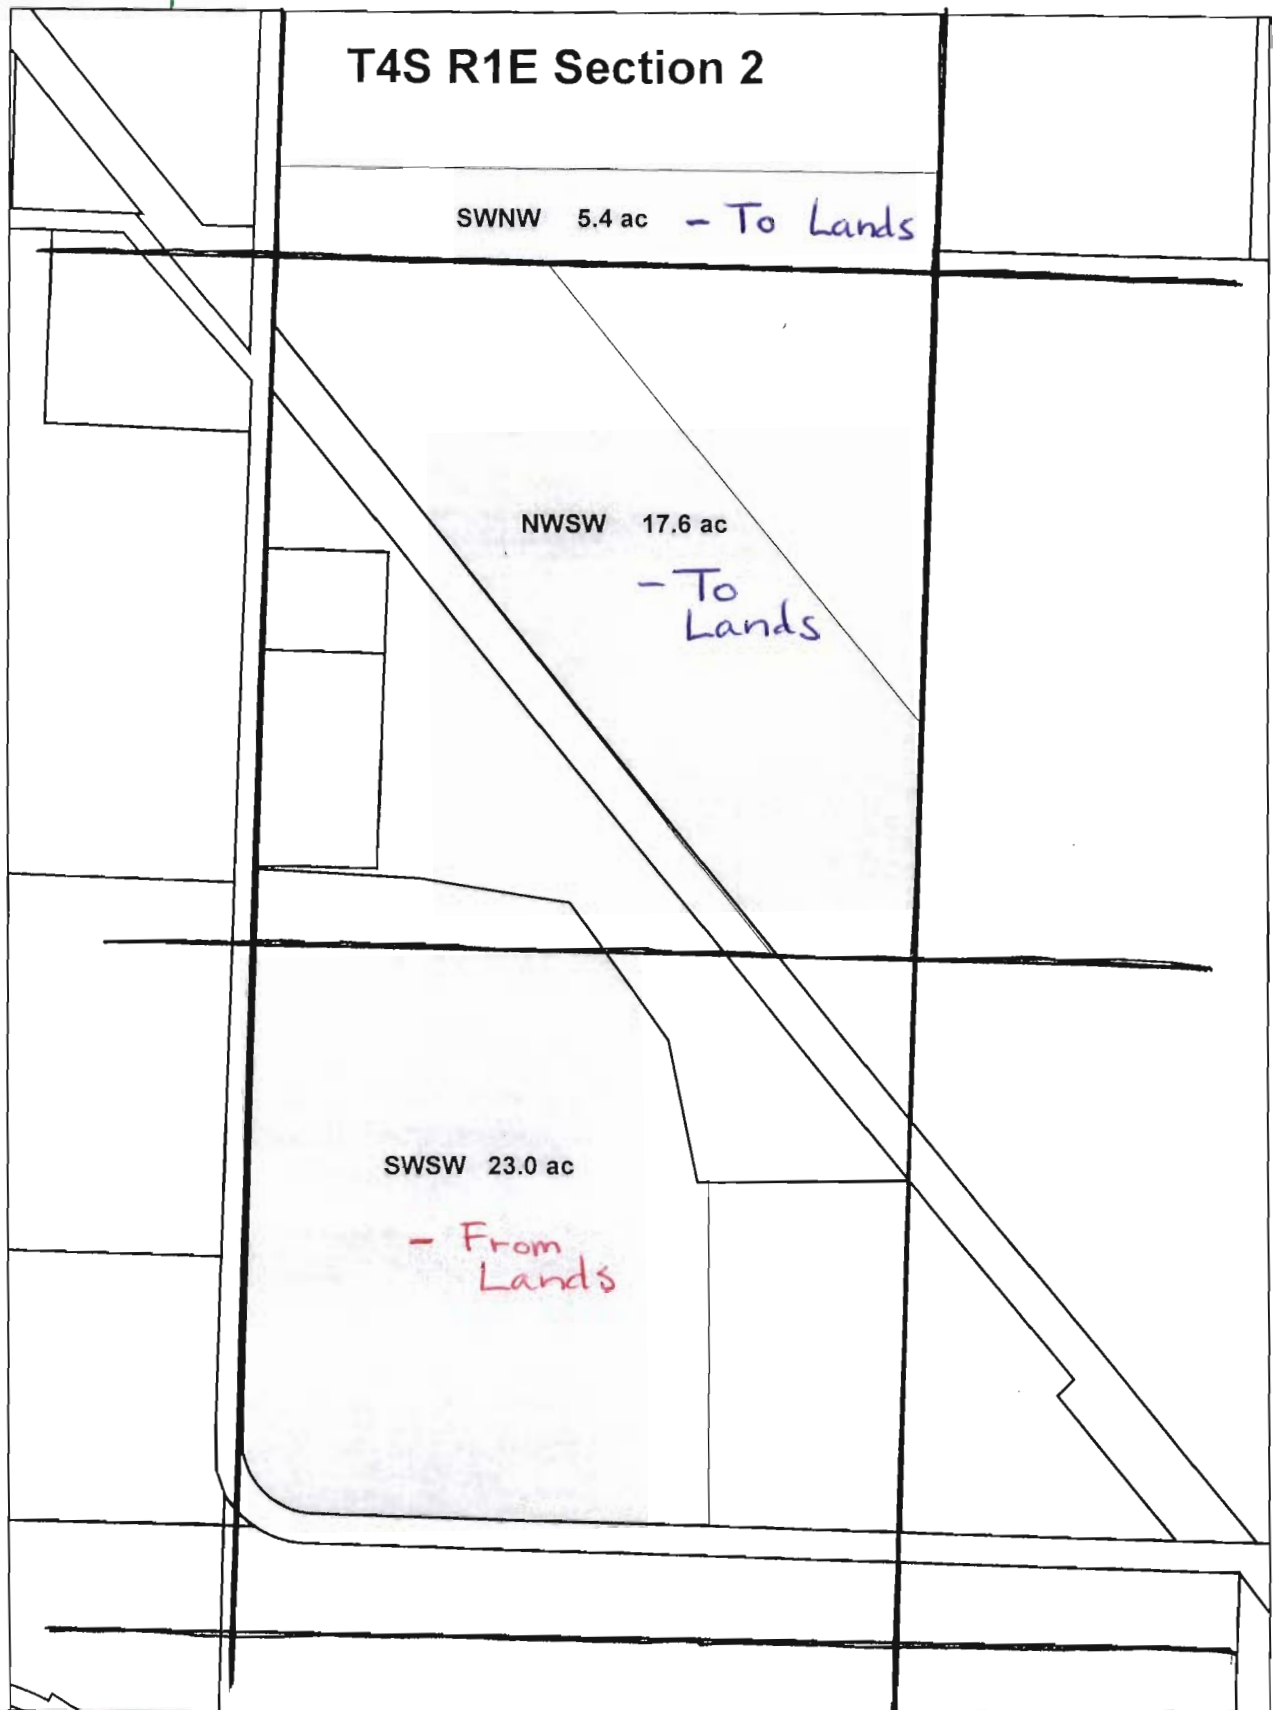

NORTH

RECEIVED

MAR 12 2009

WATER RESOURCES DEPT
SALEM, OREGON

T 10812