


APPLICATION MAP

IN THE NAME OF DAVE ROGERS


T 34 S, R 8 E, W.M. Section 27 & 34

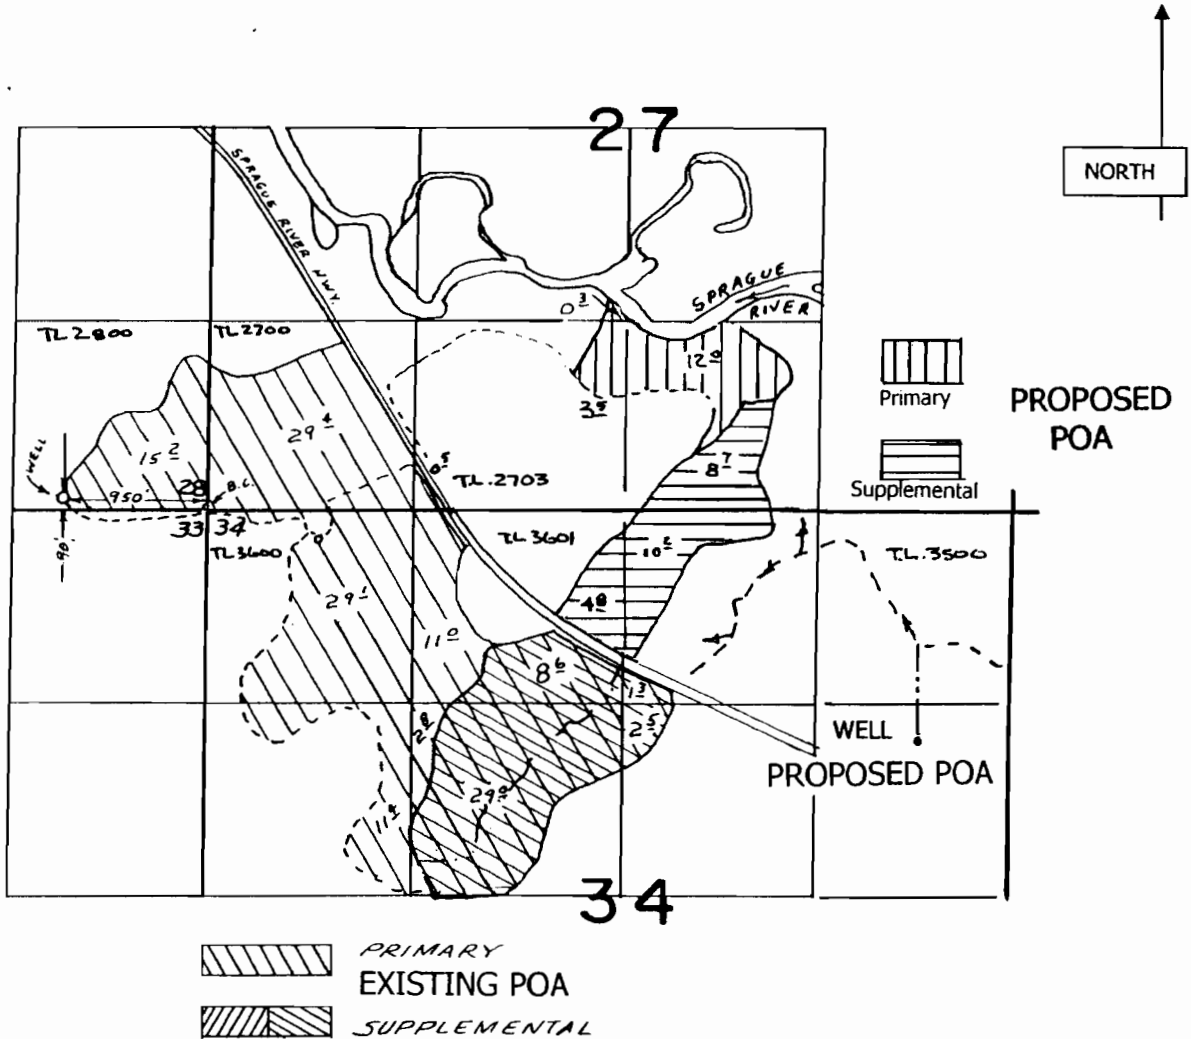

PROPOSED POINT OF APPROPRIATION: 1550' S & 4870' E from SW cor section 27

T 108° 3

Scale 1" = 1320'

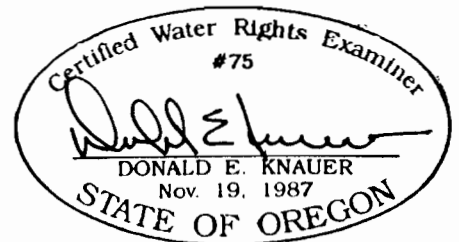

This map is not intended to provide legal dimensions or locations of property ownership lines.

RENEWAL DATE: 6/30/2009