



PERMIT 13458, CERTIFICATE 20324
CHANGE IN POINT OF DIVERSION
SE¹/₄SW¹/₄SEC. 4 & E¹/₂NW¹/₄SEC. 9
T.39S. R.23E.W.M.
LAKE COUNTY, OREGON

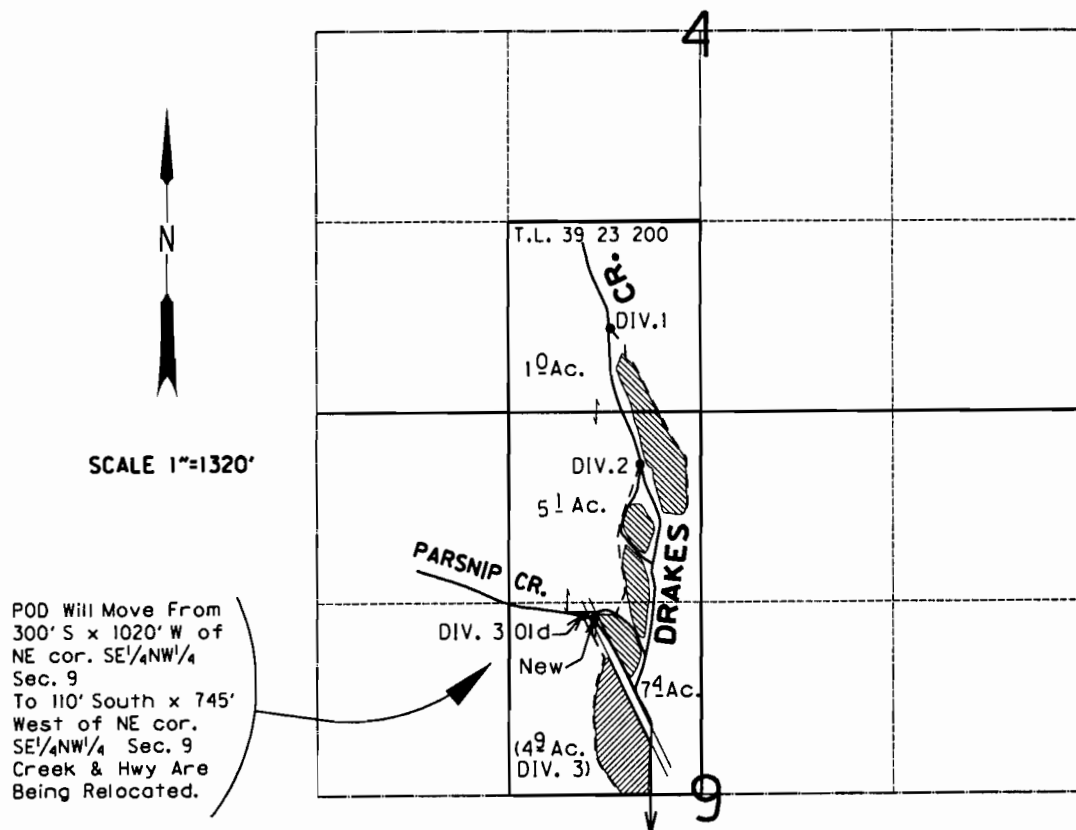

NOTE: THIS DRAWING IS A TRACING
OF THE ORIGINAL FINAL PROOF
SURVEY TO ILLUSTRATE THE CHANGE
IN POINT OF DIVERSION 3.
THIS IS NOT A LAND SURVEY.
PROPERTY BOUNDARIES, WATER USE
AND IRRIGATED ACREAGE WERE NOT
SURVEYED.

FLOOD IRRIGATED FROM DRAKE
CREEK (POD 1 & 2) NOT A PART
OF THIS APPLICATION

FLOOD IRRIGATED FROM PARSNIP
CREEK (POD 3)
ONLY POD BEING TRANSFERRED

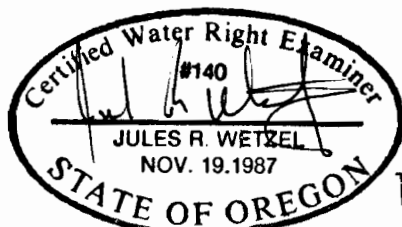

EXPIRES 06/30/10

PREPARED BY:

OREGON DEPT. OF TRANSP.
REGION 4 TECHNICAL CENTER
63085 N. HWY 97, STE. 102
BEND, OREGON 97701