


T. 9 S. R. 3 E. W. M.

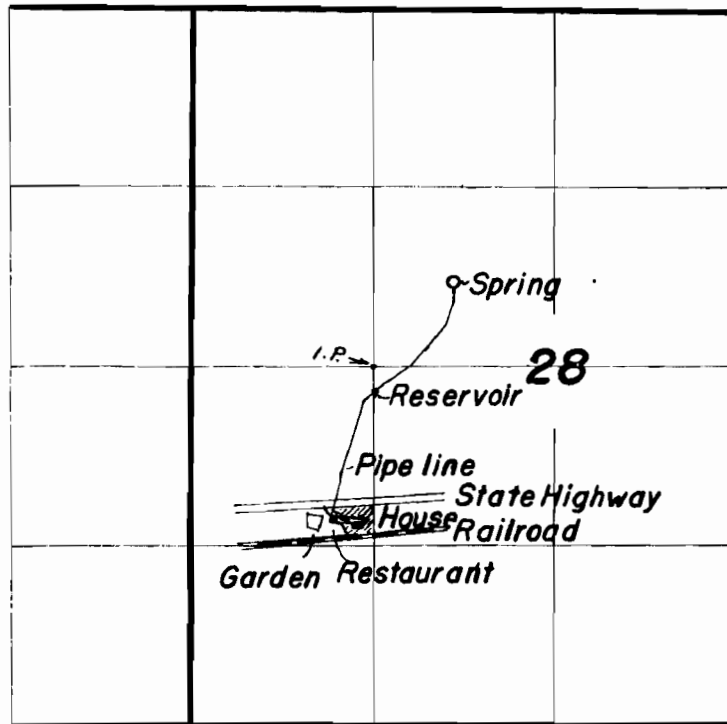

FINAL PROOF SURVEY
UNDER

Application No. 38271 Permit No. 28570
IN NAME OF

Athel Savage

Surveyed July 17 1963, by Floyd L. Seppmunt

T 10817