

STATE ENGINEER
Salem, Oregon

YAMHILL

5954

Well Record

STATE WELL NO. 4/4W-36A
COUNTY Yamhill
APPLICATION NO. GR-886

OWNER: Donald C. Goodrich


MAILING ADDRESS: Dayton

LOCATION OF WELL: Owner's No. _____

CITY AND STATE: _____

NE 1/4 NE 1/4 Sec. 36 T. 4 N. S. R. 4 E. W., W.M.

Bearing and distance from section or subdivision corner 930 feet west and 900 feet south
from NE corner, Section 36

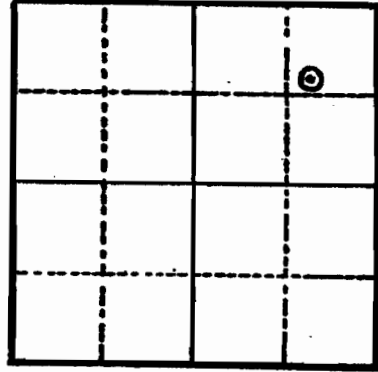

Section _____

Altitude at well 145

TYPE OF WELL: Drilled Date Constructed Nov. '52

Depth drilled 131 Depth cased _____

CASING RECORD:

FINISH:

AQUIFERS:

WATER LEVEL:

Varies

PUMPING EQUIPMENT: Type Fairbanks Morse Pomona Turbine HP. 15 Elec.
Capacity 200 G.P.M.

WELL TESTS:

Drawdown 29 ft. after _____ hours 380 G.P.M.

Drawdown _____ ft. after _____ hours _____ G.P.M.

USE OF WATER Irrigation Temp. _____ °F. _____, 19____

SOURCE OF INFORMATION Owner

DRILLER or DIGGER Wilcox Drilling Co. McMinnville, Oregon

ADDITIONAL DATA:

Log NA Water Level Measurements _____ Chemical Analysis _____ Aquifer Test _____

REMARKS:

T 10823

RECEIVED

MAR 17 2009

WATER RESOURCES DEPT
SALEM, OREGON