


G-1360

27120

T-7696

T.6 N. R. 35 E. W.M.

Washington

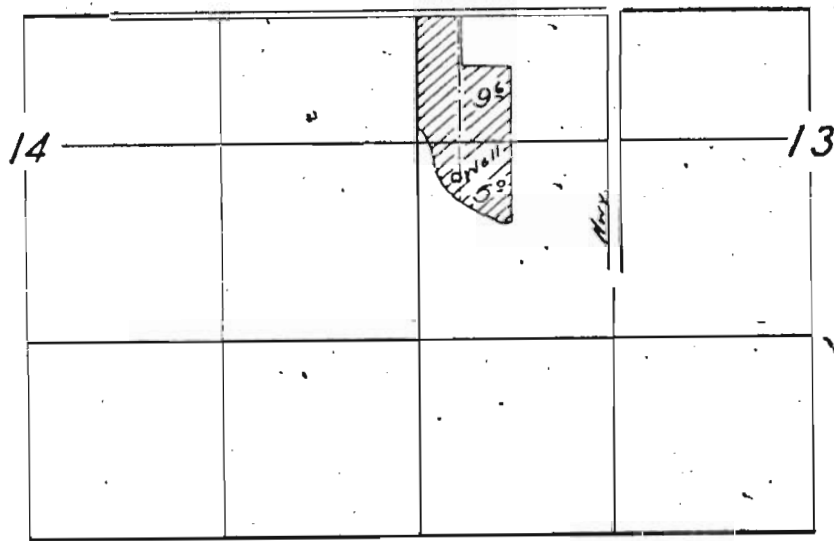

Scale

1" = 1320'

FINAL PROOF SURVEY

UNDER

Application No. G-1488 Permit No. G-1360

IN NAME OF

William Bark

Surveyed Oct. 23, 1959, by C. O. Baird

T 10786

RECEIVED

FEB 13 2009

WATER RESOURCES DEPT
SALEM, OREGON