

82607

PROPOSED Well


RECEIVED

MAR 20 2009

WATER RESOURCES DEPT
SALEM, OREGON

T 10832

T. 25 S. R. 34 E., W.M.

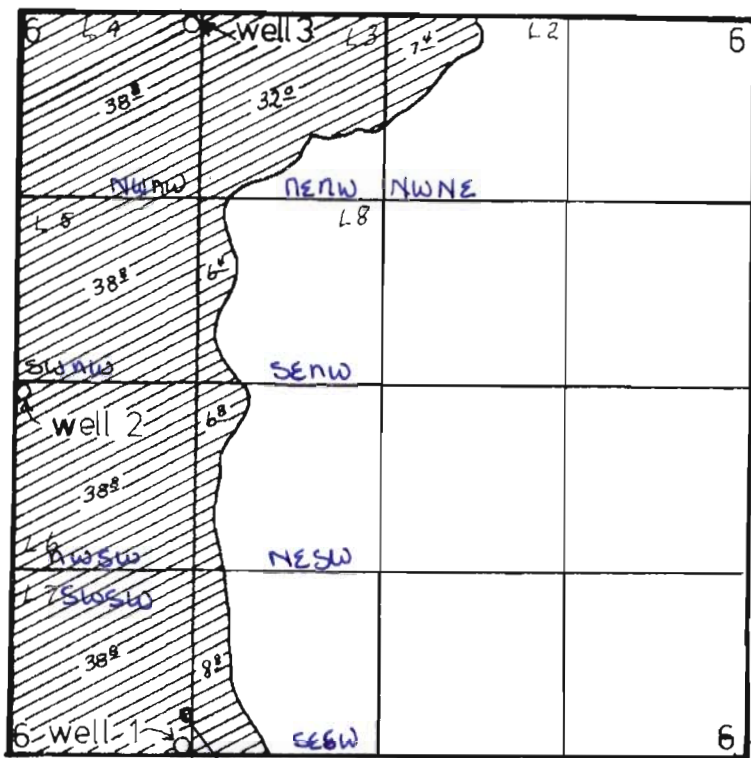

- Well # 1 - 80 feet North and 1305 feet East from Southwest corner of Section 6
- Well # 2 - 2630 feet North and 30 feet East from Southwest corner of Section 6
- Well # 3 - 40 feet South and 1290 feet East from Northwest corner of Section 6, Township 25 S. Range 34 E., W.M.

Proposed new well

Dave Mims
 P.O. Box 787
 Crane, OR. 97732
 (541) 589-1056

FINAL PROOF SURVEY UNDER

Application No. G-11583 Permit No. G-10710

IN NAME OF

RALPH OPIE

Surveyed 3-25-1992 by J. MILLER

RECEIVED

MAR 20 2009

WATER RESOURCES DEPT
 SALEM, OREGON

T 10832