



State of Oregon  
 Water Resources Department  
 725 Summer Street NE, Suite A  
 Salem, Oregon 97301-1266  
 (503) 986-0900

# Application for Instream Lease

*A summary of review criteria and procedures that are generally applicable to these applications is available at [www.wrd.state.or.us/OWRD/PUBS/forms.shtml](http://www.wrd.state.or.us/OWRD/PUBS/forms.shtml).*

**Pursuant to ORS 537.348(2) and OAR 690-077**

Optional Identification by Lessor/Lessee: \_\_\_\_\_  
 Lease Application Number (assigned by WRD): IL-985

This Lease is between:

**Lessor #1:**

Name Alberta Rorick  
 Mailing address 22773 Rickard Rd  
 City, State, Zip Code Bend, OR 97702  
 Telephone number 541-389-4607  
 Email address \_\_\_\_\_

**Lessor #2, 3, etc.**  
 \_\_\_\_\_

The water right to be leased is located in Deschutes County.

**Lessee (if different than Oregon Water Resources Department):**

Name Deschutes River Conservancy  
 Mailing address 700 NW Hill St  
 City, State, Zip Code Bend, OR 97701  
 Telephone number 541-322-4079  
 Email address \_\_\_\_\_

**Trustee:**

Oregon Water Resources Department  
 725 Summer Street NE, Suite A  
 Salem, OR 97301-1266  
 (503) 986-0900

**~I~ Water Right Holder and Water Right Information**

- 1.1 Lessor #1 is the water right holder, or authorized agent for water right holder of the property located at: Township 18 S, Range 13 E, Section 20 and Tax Lot number 103. If the water right appurtenant to these lands is also appurtenant to lands owned by others who are not included in this application, then Attachment 1 (tax lot map), needs to be included.

**RECEIVED**

APR 08 2009

WATER RESOURCES DEPT  
 SALEM, OREGON

- 1.2 Lessor #2 is the (Check one):  
 Not applicable  
 Official representative of \_\_\_\_\_, the irrigation district which conveys water to the subject water rights.  
 Another party with an interest in the subject water rights representing \_\_\_\_\_.

- 1.3 For the water right(s) being leased, list all water rights appurtenant to the same lands. Indicate if there are any supplemental or overlying rights.

Certificate No. 74197

- 1.4 Are some or all of the lands being leased part of a Conservation Reserve Enhancement Program.  Yes  No

1.5 **Water Rights Proposed to be Leased Instream.**

The first right to be leased identified in Section 1.3 is further described as follows:

Certificate No.: 74197

Priority date: February 1 - April 25, 1905 Type of use: IRRIG

Legal Season of Use: April 1 - October 31

Is the entire water right certificate being leased?  Yes  No

If no, list the acres of the subject water right by legal description of township, range, section, and ¼ ¼ which will be dried up as part of this lease, and include a map (Attachment 2) showing the lands which will not receive water.

Place of use: T 18 S, R 13 E, Section 20, NE¼ NE¼ - 17.00 acres to be leased

Enter additional places of use here, using format above:

tax lot 103

Page 22 (Identify page number of certificate, if certificate is greater than 10 pages.)

Number of acres being leased, if for irrigation: 17.00

Acre-feet of storage, if applicable: \_\_\_\_\_

Maximum rate associated with the right to be leased (cfs): ~~1.063~~

(Use additional lines if there is more than one rate associated with the water right.)

Maximum duty associated with the right to be leased (ac-ft): 262.14

(Use additional lines if there is more than one duty associated with the water right.)

→ Season 1-3  
Feb. 1, 1905 .097 cfs

Season 1 Ap. 25, 1905 - 0.236

Season 2 " - 0.339

Season 3 " - 0.485

Conditions or other limitations, if any: \_\_\_\_\_

If you need to enter another leased right, please use the additional water rights form.

1.6 **Validity of rights.** Lessor(s) attests (mark one) that:

- the water has been used over the past five years according to the terms and conditions of the water right certificate or as an instream water right or
- the water has not been used over the past five years according to the terms and conditions of the water right certificate, however the water right is not subject to forfeiture under ORS 540.610(2)( ) (include necessary supporting documentation as Attachment 3).

RECEIVED

APR 08 2009

WATER RESOURCES DEPT  
SALEM, OREGON

Application for Short-Term Instream Lease / 2

FSD

**~II~ Instream Water Right Information**

**2.1 Public use.** This lease will increase streamflows that will benefit:

- Conservation, maintenance and enhancement of aquatic and fish life, wildlife, and fish and wildlife habitat
- Pollution abatement
- Recreation and scenic attraction

**2.2 Instream use created by lease.** The instream use to be created is described as follows:

Deschutes River  
Tributary to Columbia in the Deschutes Basin.

Describe the point of diversion (POD) and any associated reach(es) of the instream use being created. If possible list the reach by river mile. If no reach is identified, and there is only one POD listed on the certificate, the lease may be processed to be protected at the POD. (If more than one POD is listed on the certificate, then the POD and any associated reach(es) must be identified): canal diversion river mile 174.5 to Lake Billy Chinook river mile 120 and to the mouth of the Deschutes at river mile 0

Maximum volume in acre-feet: February, 1905 - ~~114.4~~ 14.4, Apr 1905 58.46 =  
 Rate in cfs: Season 1 - February 1, 1905 - 0.034, April 25, 1905 - 0.083 Total  
Season 2 - February 1, 1905 - 0.034, April 25, 1905 - 0.119 72.86 AF  
Season 3 - February 1, 1905 - 0.034, April 25, 1905 - 0.170

(Use the section below to indicate a more restrictive period of use than allowed by the water right.)

**Conditions to prevent injury, if any:**

- None
- The instream flow will be allocated on a daily average basis up to the described rate from April 1 through October 31.
- Other (describe): \_\_\_\_\_

If you need to enter more instream uses, please use the additional water rights form.

**2.3 Term of lease.** This lease shall terminate on October 31, 2013.

**2.4 Flow protection.** The Trustees will regulate use of water from the source, subject to prior appropriation and the agency enforcement guidance, to assure the water is delivered to the point of diversion, and through the reach past junior downstream users, so long as flow is sufficient to meet the demand under priority date of the new instream use (see Section 2.2). As part of regulation activities the watermaster or a designee has access to the point of diversion and place of use for the water rights involved in this lease. No party is required to continuously measure the flow of the waterway described in Section 2.2.

**~III~ Other Information**

**3.1 Accuracy.** The Undersigned Lessor(s) and Lessee(s) declare that, to the best of their knowledge and belief, the information contained in this application is true, correct and complete. If after the lease order is signed, any information is determined to be false, the lease order may be modified or terminated. The lease only exercises the water rights being leased, for the term of the lease. It shall not be construed to overcome any claim that the

**RECEIVED**

APR 08 2009

water right may otherwise be subject to forfeiture for nonuse pursuant to ORS 540.610 during the period of time prior to the execution of the lease.

3.2 **Lease.** Lessor(s) and Lessee(s) agree to lease the water rights listed in Section(s) 1.5 for instream use for the term of this lease through Lessee to the Trustee, the Oregon Water Resources Department, pursuant to the provisions of ORS 537.348(2) and OAR 690-077.

3.3 **Precedent.** If a right which has been leased is later proposed to be leased again or transferred to an instream use under ORS 537.348 and OAR 690-077 a new injury review shall be required, and a prior lease shall not set a precedent for the amount of water to be leased or transferred instream.

3.4 **Suspension of original use.** During the period of the lease, the water right holder agrees to suspend use of water allowed under the subject water rights and under any water right that is supplemental to the subject water rights.

3.5 **Termination provision.**

For multiyear leases, the Lessor(s) shall have the option of terminating the lease each year with written notice to the Department. The lease may be terminated at any time during the calendar year. However, if the termination request is received less than 30 days prior to the period of allowed instream use or after the period of allowed use has begun for the water right(s) being leased, water may not be used under the right(s) leased until the following calendar year, unless the Director determines that enlargement would not occur. The Department may also require:

- Written notice to the Department with original signatures;
- Consent by all parties to the lease; and/or
- Written notice to the Watermaster's office.

For multiyear leases, the lessor shall not have the option of terminating the lease, without consent by all parties to the lease.

3.6 **Modification to prevent injury.** Allocation of water to the instream use described in Section 2.2 during the term of this lease is not reasonably expected to cause injury to other rights to use water from the same source. If injury is found after this lease is signed, the lease may be modified or terminated to prevent injury.

3.7 **Fees.** Pursuant to ORS 536.050, the following fee is included:

- \$200 for an application with four or more landowners or four or more water rights.  
 \$100 for all other applications.

Lessor #1: Alberta Rorick Date: 3-13-09  
Alberta Rorick

For additional Lessors, type in space for signature and date  
Lessor #2: Shawn Gerdes Date: 3/29/09  
Shawn Gerdes, Manager, Arnold Irrigation District

Lessee: Genevieve Hubert Date: 4/2/09  
Genevieve Hubert, Deschutes River Conservancy

RECEIVED

APR 08 2009

Application for Short-Term Instream Lease / 4

FSD

WATER RESOURCES DEPT

**This table will calculate flow rate factors and duty for Arnold Irrigation District  
Instream Leases**

Enter Total Number of Acres to be Leased Instream Here	→ <b>17.000</b>
---	-----------------

**Information highlighted with pink font is to be entered on to the Instream Lease Application Form**

**For Primary Water Right - Certificate 74197**

<b>Rate (CFS) associated with leased rights for Section 1.5 of the Lease Application Form</b>			
The rate and duty identified in this section includes the 65% transmission loss.			
Enter Rates by Priority Date on Lease Form	Full Rate	February 1, 1905	April 25, 1905
Season 1	0.333	0.097	0.236
Season 2	0.436	0.097	0.339
Season 3*	0.582	0.097	0.485
* The rate identified for Season 3 has been proportioned such that the max rate allowed by the right (150.0 CFS) will not be exceeded if all acres were being irrigated.			
<b>Duty (AF) associated with leased right for Section 1.5 of the Lease Application Form</b>			
Duty (decree) AF/Acre =	15.42		
	262.14		

<b>Rate (CFS) leased instream for Section 2.2 of the Lease Application Form</b>			
The rate and duty identified in this section does not include the 65% transmission loss.			
Enter Rates by Priority Date on Lease Form	Full Rate	February 1, 1905	April 25, 1905
Season 1	0.117	0.034	0.083
Season 2	0.153	0.034	0.119
Season 3	0.204	0.034	0.170

<b>Volume (AF) leased instream for Section 2.2 of the Lease Application Form</b>			
	# days	AF/Season	Duty (decree) AF/Acre = 5.40
Season 1	61	14.12	Total = 91.75
Season 2	30	9.08	Feb. 1905 portion = 14.40
Season 3	123	49.67	April 1905 portion = 58.46
		72.86	

<b>Additional Conditions to Prevent Injury for Section 2.2 of the Lease Application Form</b>	
Water protected instream:	April 1 through October 31

**For Supplemental Water Right from Crane Prairie Reservoir - Certificate 76714**

<b>Duty Associated with Leased Right for Section 1.5 of the Additional Water Right Form</b>	
	262.14

<b>Volume (AF) leased instream for Section 2.2 of the Additional Water Right Form</b>	
	72.86

APR 08 2009


**Arnold Irrigation District**

**Alberta Rorlick - 17.00**  
acres

1813200000103 -  
18-13-20-NENE-00103

- District Boundary
- County Boundary
- Road Labels
- Township Range
- Sections
- Section Labels
- Quarter
- Quarter Labels
- Quarter Quarter
- Quarter Quarter Labels
- Tardets
- Canal / A
- Canal Piped
- Canal Open
- POU District Primary FI
- Eriens

Scale 1" = 400'  
Created: 9/10/2009

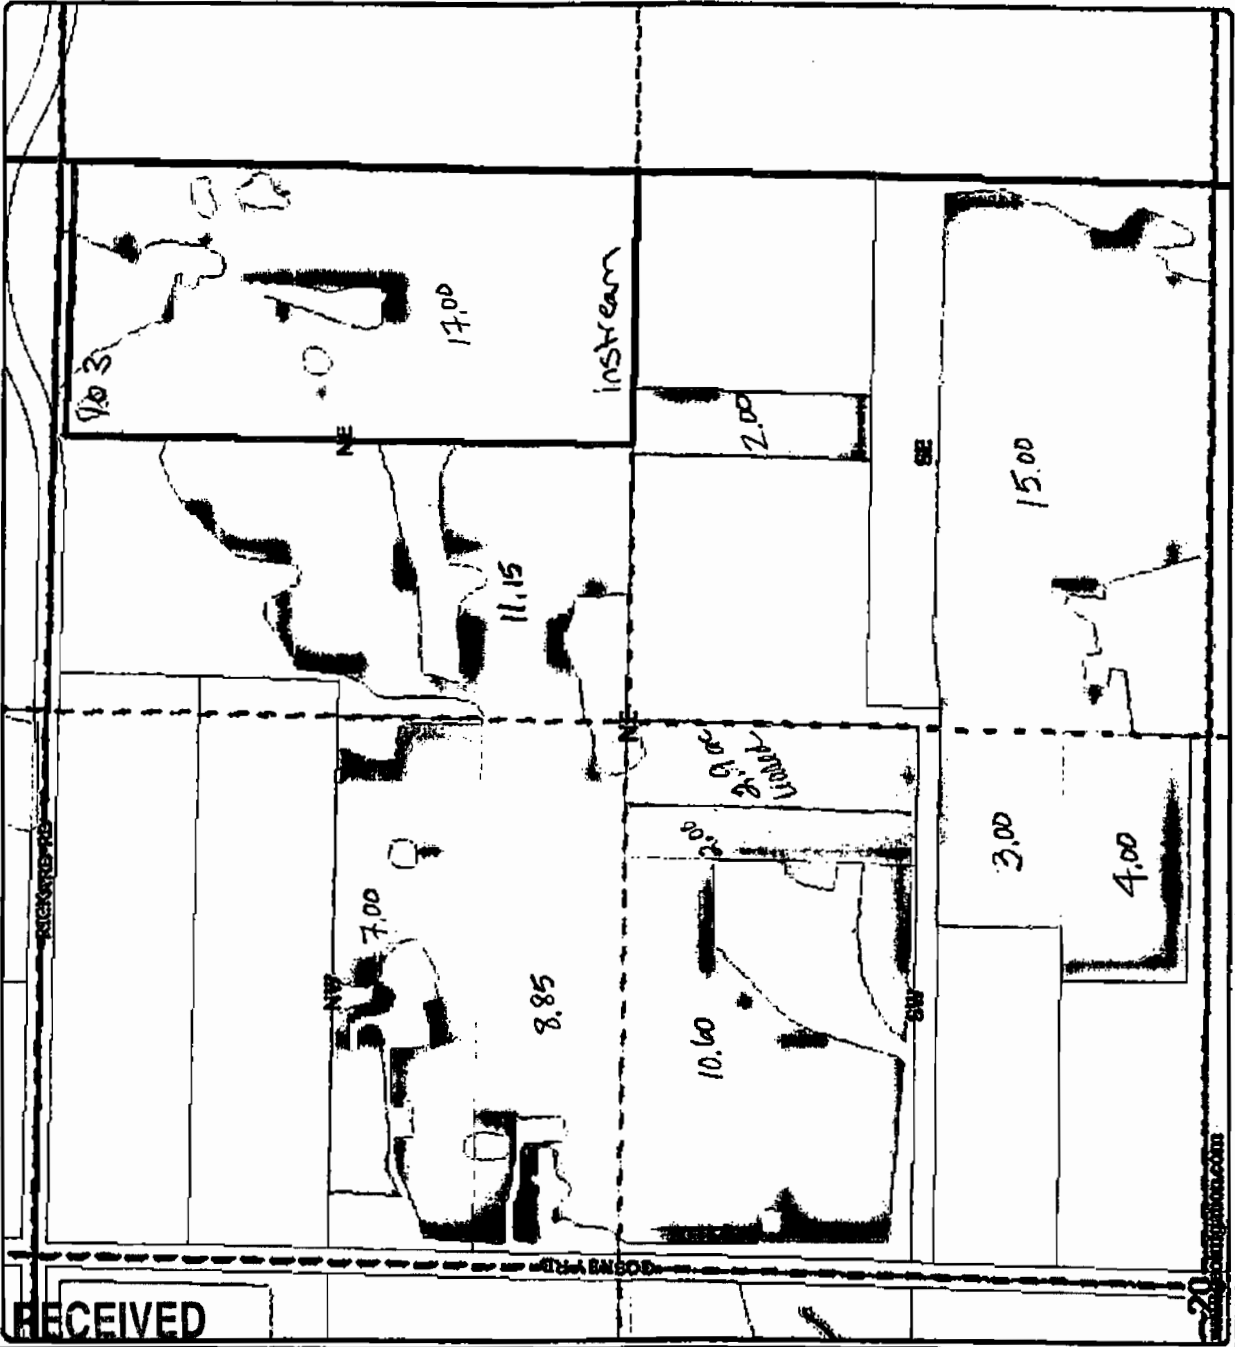

APR 08 2009

WATER RESOURCES DEPT

DISCLAIMER: This map is intended for display purposes only and is not intended for any legal representation. There are no warranties, expressed or implied, that accompany this product.

# Arnold Irrigation District


Alberta Rorick - 17.00 acres

181320000103 -  
18-13-20-NENE-00103

- District Boundary
- County Boundary
- Road Labels
- Township Range
- Sections
- Section Labels
- Quarters
- Quarter Labels
- Quarter Quarters
- Quarter Quarter Labels
- Taxlots
- Canal All
- Canal Piped
- Canal Open
- POU District Primary FM
- Rivers



Scale 1" = 400'  
Created: 3/10/2009

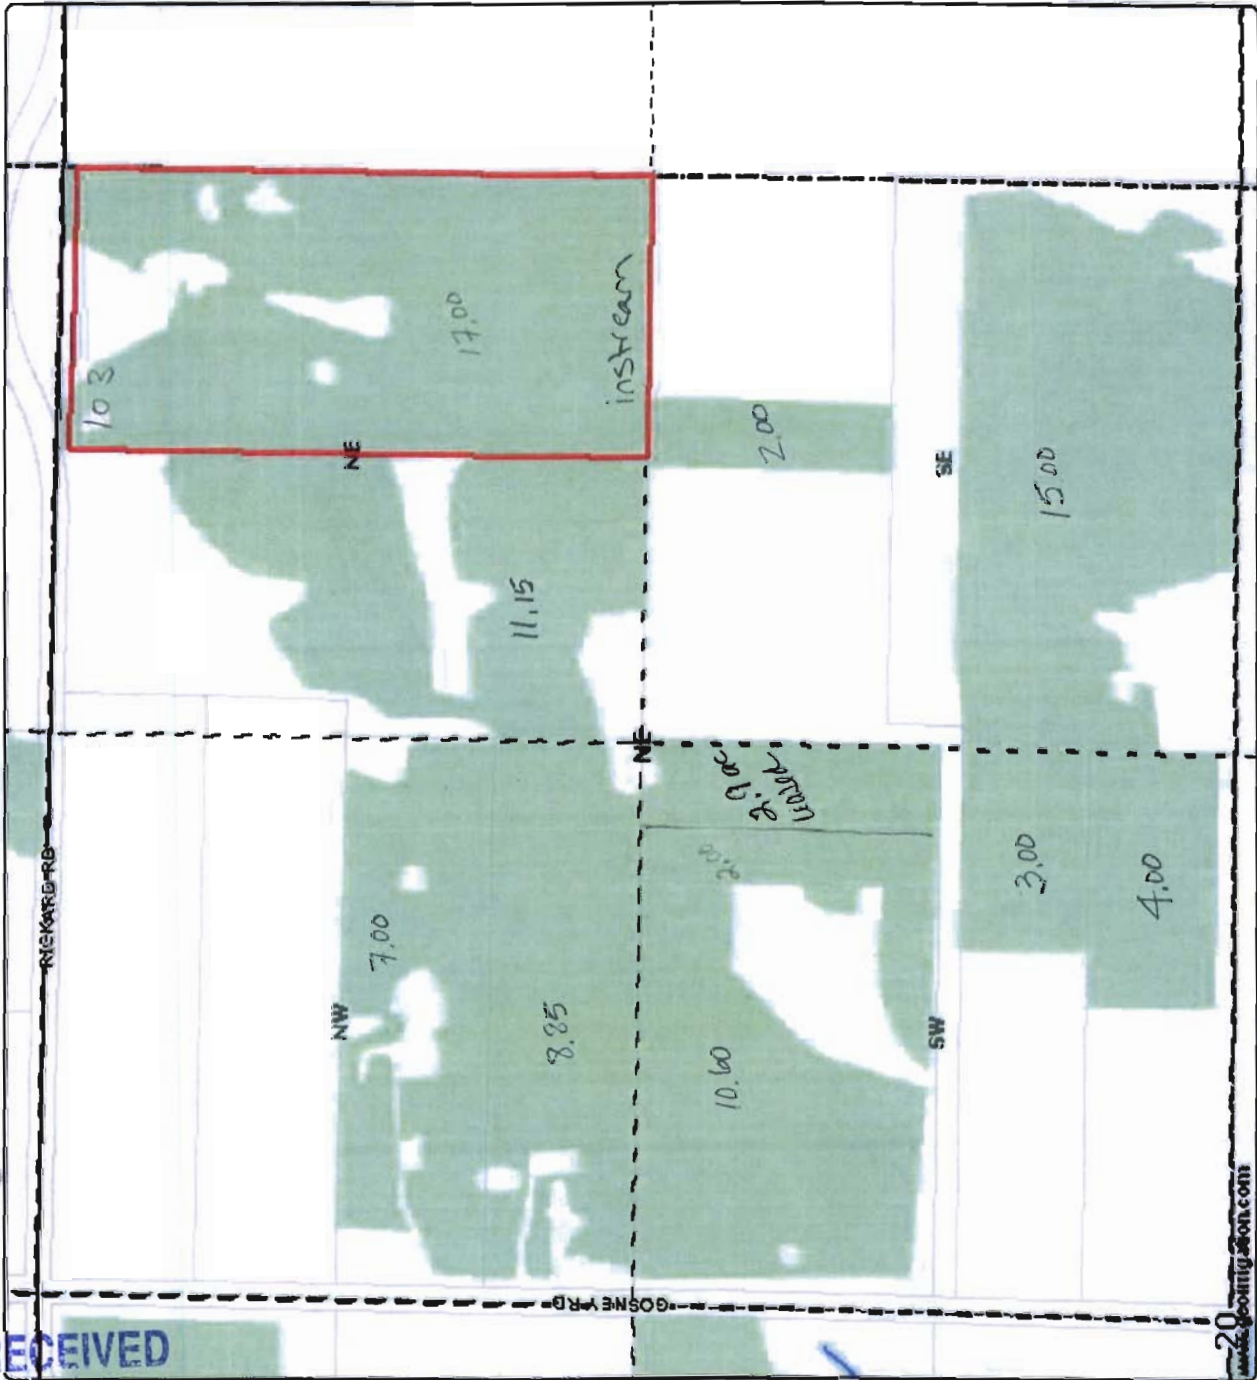

www.geointel.com

DISCLAIMER: This map is intended for display purposes only and is not intended for any legal representation. These are not warranties, representations or implied, and accompany this product.

APR 08 2009  
WATER RESOURCES DEPT