


T. 15 S., R. 16 E. W.M.

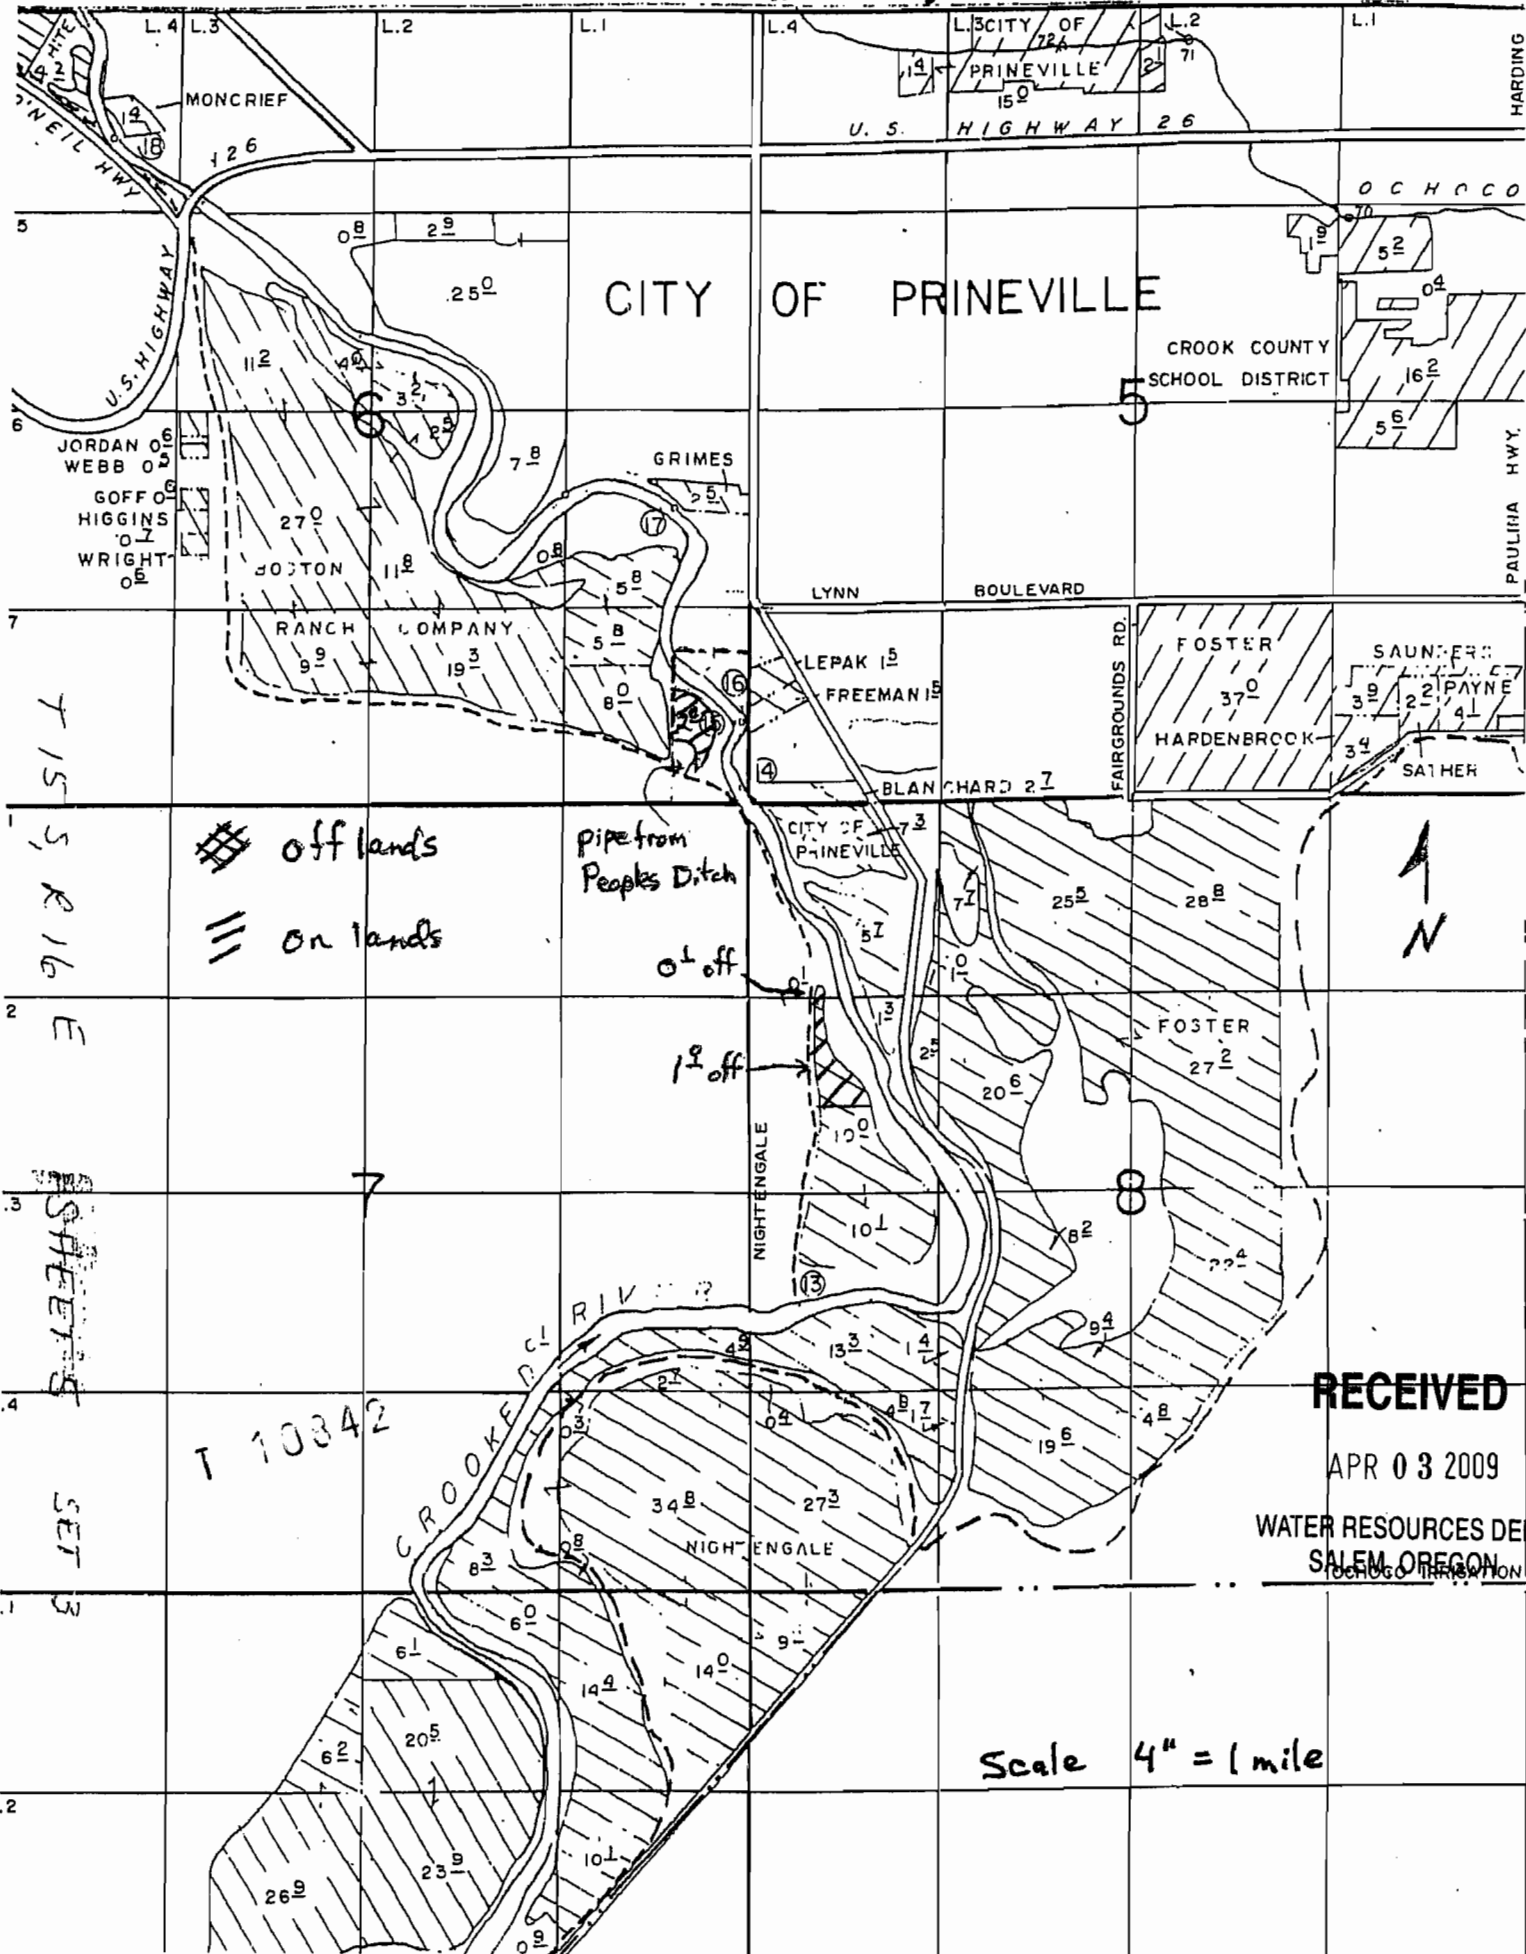

T 15 S, R 16 E SHEETS SET 3

T 10342

RECEIVED

APR 03 2009

WATER RESOURCES DEPT SALEM OREGON

Scale 4" = 1 mile