


SECTION 10, T.4S, R.1E, W.M.
CLACKAMAS COUNTY, OREGON




RECEIVED

APR 07 2009

WATER RESOURCES DEPT
SALEM, OREGON

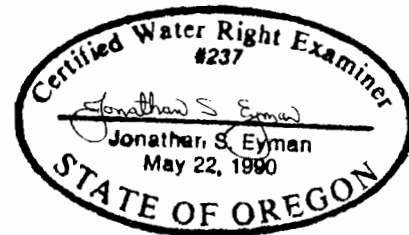

RENEWS 12-31-2009

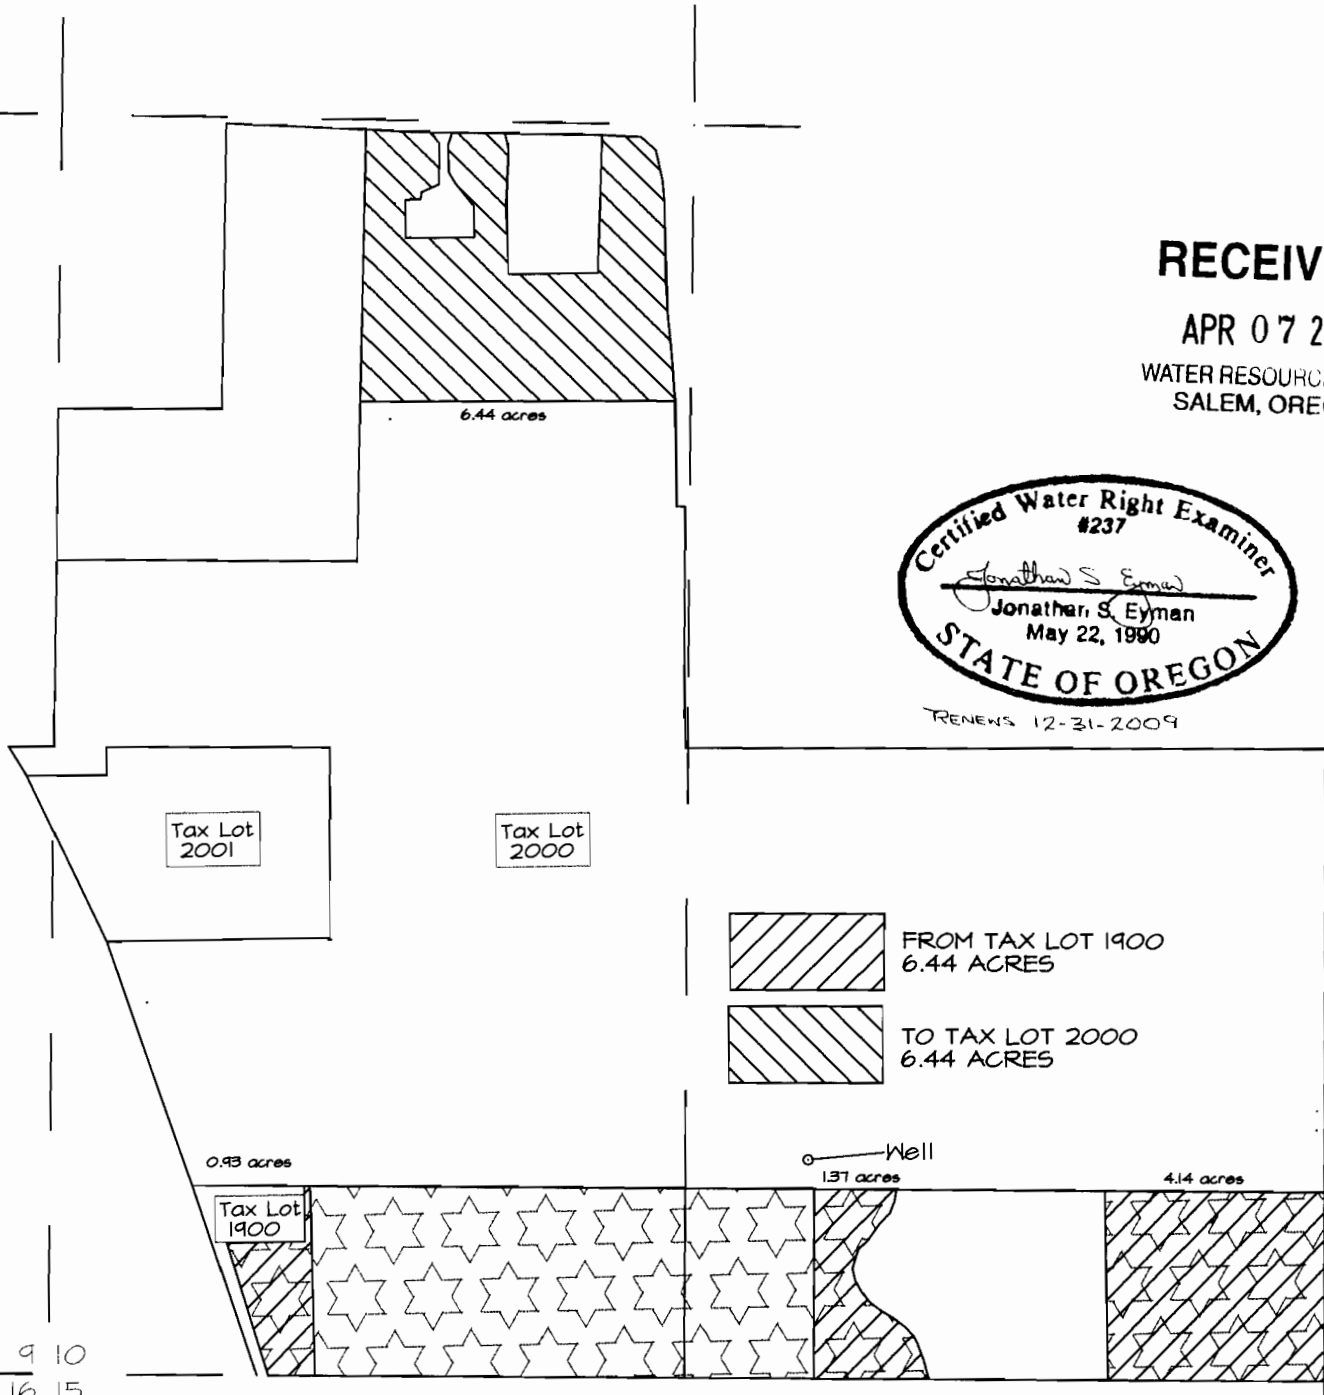

THE WELL IS 1591 FEET EAST AND 454 FEET NORTH OF THE SW CORNER OF SECTION 10
THE WATER METERS ARE LOCATED AT THE WELL.

SCALE: 1" = 400'



APPLICATION G-15582
AREA (16.0 ACRES)
PART OF TL 1900

PERMIT AMENDMENT MAP
ALLEN KRAXBERGER, JR.

APPLICATION NO. G-15582
PERMIT NO. G-15003

THE PREPARATION OF THIS MAP IS FOR THE
PURPOSE OF IDENTIFYING THE LOCATION
OF THE WATER RIGHT ONLY AND HAS NO
INTENT TO PROVIDE DIMENSIONS OR LOCATION
OF PROPERTY OWNERSHIP LINES

T 10843