


CCPD INC. C/O, TED C. CARNER
 PERMIT AMENDMENT APPLICATION MAP
 FOR PERMIT G-11074
 ADDING THREE ADDITIONAL POINTS OF
 APPROPRIATION
 T2S, R39E WM
 UNION CO, OREGON

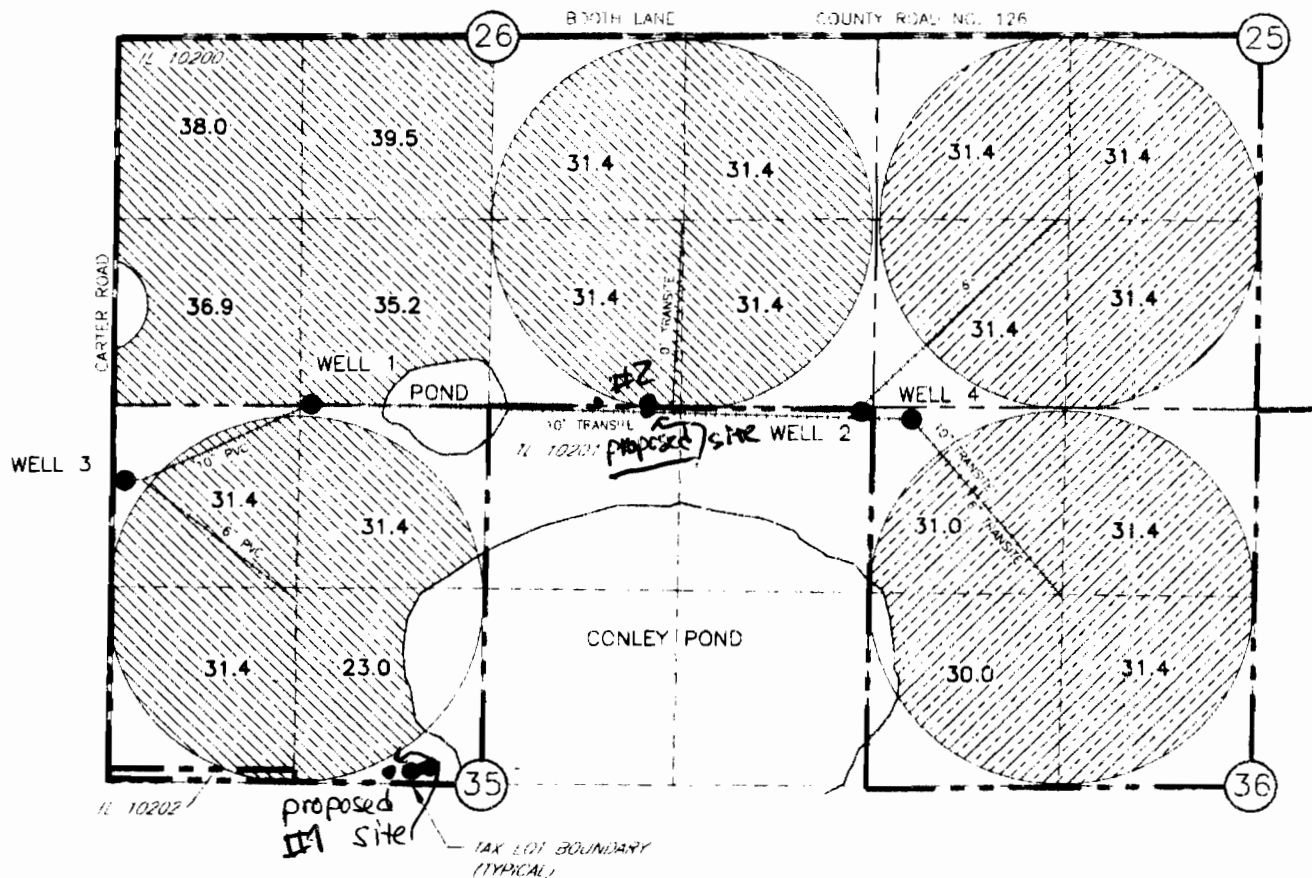

AUTHORIZED POINT OF
 APPROPRIATION

WELL 3
 LOCATED 505'S AND 24'E FROM THE NW
 CORNER OF SEC 35

PROPOSED ADDITIONAL POINTS OF
 APPROPRIATION

WELL 1
 LOCATED 1360'E FROM THE SW CORNER
 OF SEC 26

WELL 2
 LOCATED 40'S AND 80'W FROM THE NE
 CORNER OF SEC 35

WELL 4
 LOCATED 2600'N AND 2370'W FROM THE
 CENTER OF SEC 36

FLOW METERS ARE LOCATED AT THE WELLS


LEGEND

-  249.4ac PRIMARY
-  392.4ac SUPPLEMENTAL

RECEIVED

APR 02 2009

WATER RESOURCES DEPT
 SALEM, OREGON

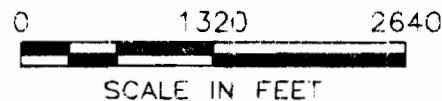


NOTE:
 THE PURPOSE OF THIS MAP IS TO IDENTIFY THE APPROXIMATE LOCATION
 OF THE WATER RIGHT. IT IS NOT INTENDED TO PROVIDE INFORMATION

DRAWING: H:\CAD\AC\35\2\CARNER\5502300\carner.dwg

T 10608

1 10638


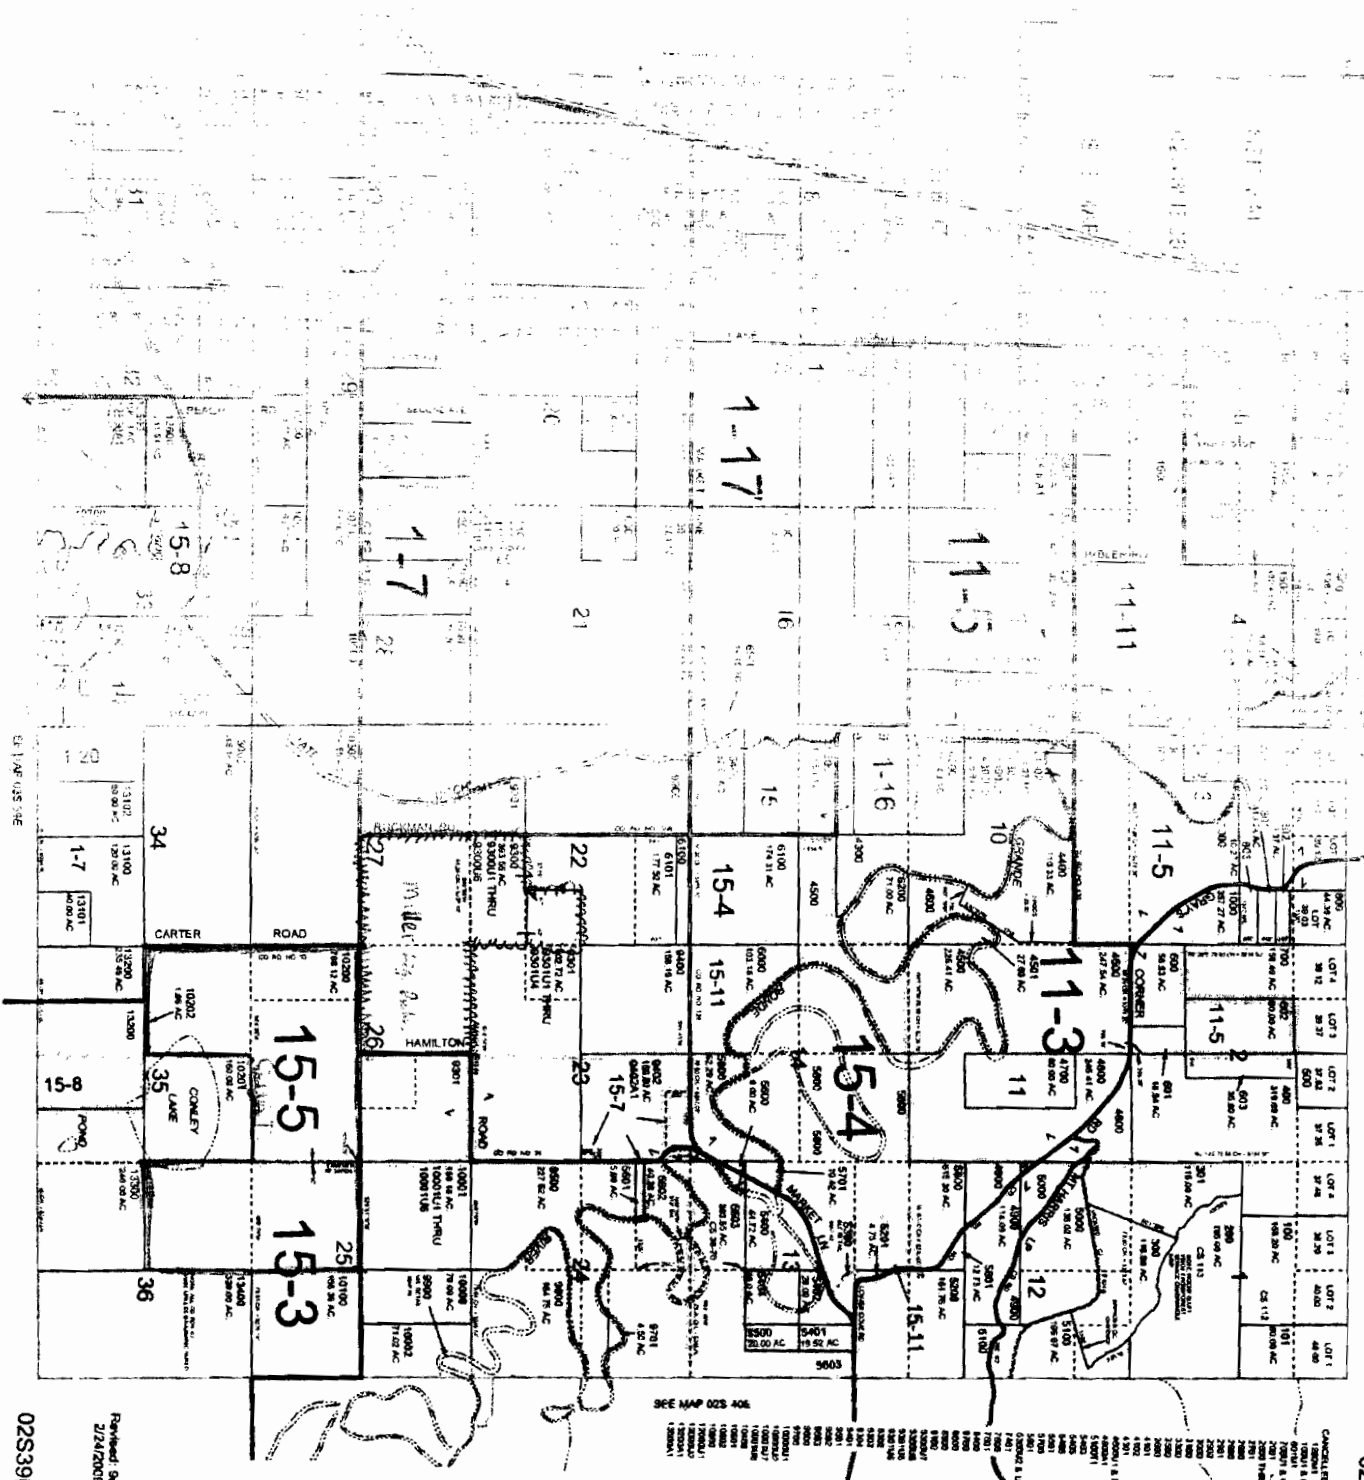

SEE MAP 025 406

02539E