



T. 1 S. R. 38 E. W. M.

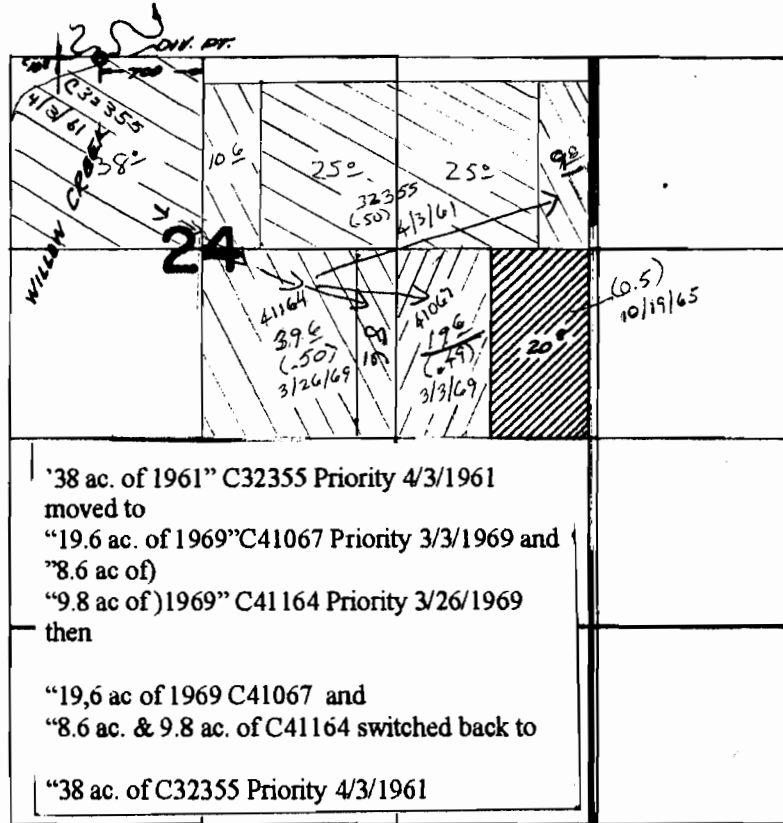

Temporary Request - 2009
 → → C32355 moved To.
 Original Permits switched

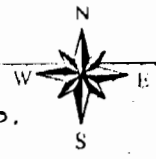

RECEIVED

APR 29 2009

WATER RESOURCES DEPT
SALEM, OREGON

T 10364