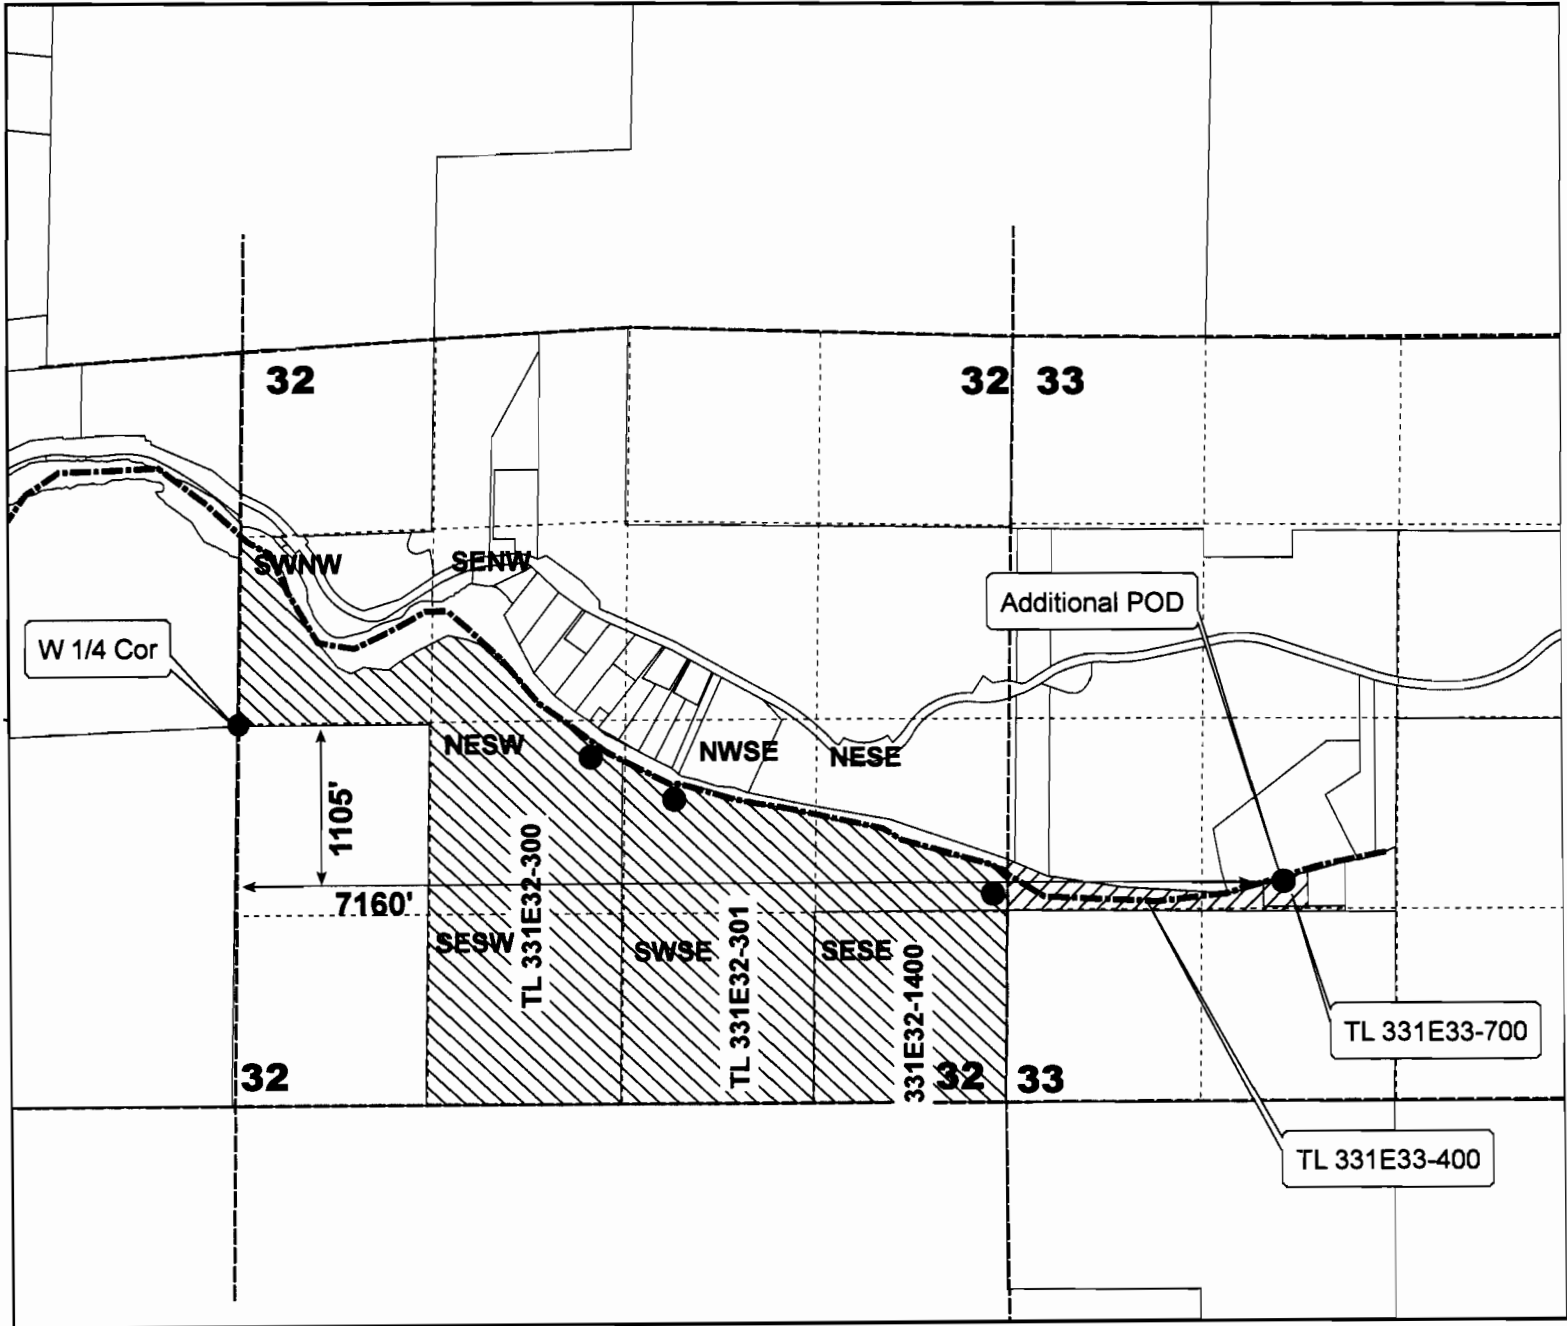

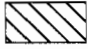


**Permit Amendment
Application S-87157 Permit S-54486
Crowfoot Water Improvement District**

T 33 S, R 1 E, Sec 32 & 33, W.M.



Legend

- POD
-  Additional
-  Existing
- Section Line
- - - - Quarter-quarter Line



1 inch = 1,320 feet

T 10360

RECEIVED

APR 24 2009

WATER RESOURCES DEPT
SALEM, OREGON